PARENT PARCEL: 09-00-063-000-018

CHILD PARCEL: N/A

STARTING POINT: INTERSECTION OF C/L OF BUTTERNUT RIDGE RD & PYLE-SOUTH AMHERST RD

22-04824-A

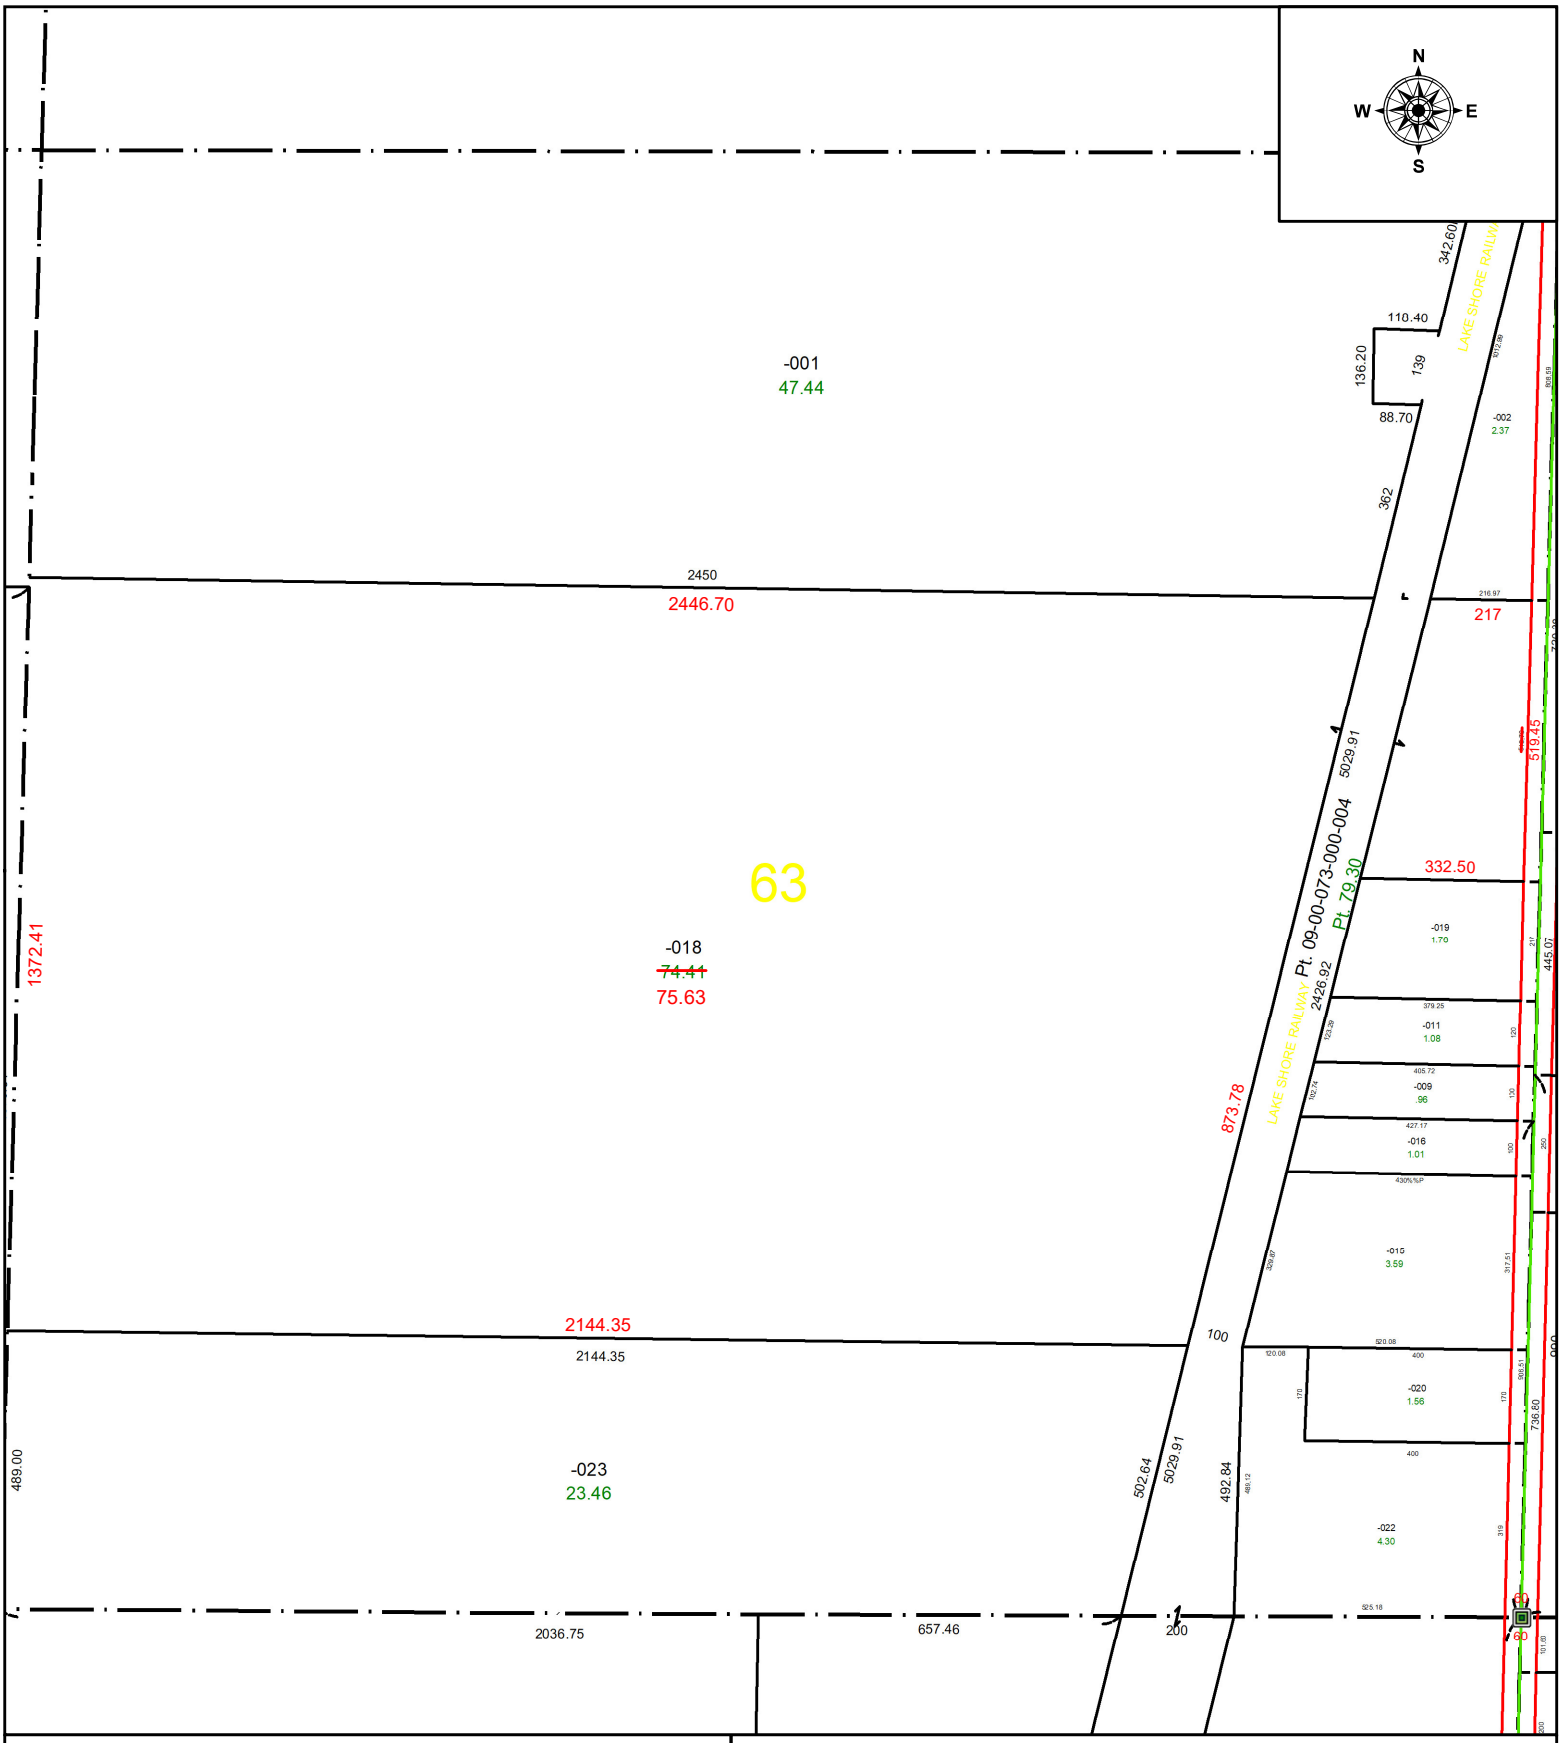

SPLITS/DEEDS PROCESSED

LORAIN COUNTY TAX MAP DEPARTMENT
226 MIDDLE AVE. ELYRIA, OH

SURVEYED BY: THOMAS A. SIMON
CLOSURE: 1: 731928
MAP PAGE(S): 09-00-063
APPOVED BY: WRZ **DATE:** 3/25/2022
SCALE: 1" = 350 **PRIOR INSTRUMENT:** 2019-0743665