PARENT PARCEL: 04-00-019-143-053

CHILD PARCEL: AC. CORR. PER DED. ROW PLAT PER VOL. 12 PG. 32

STARTING POINT: N/A

22-04827-A

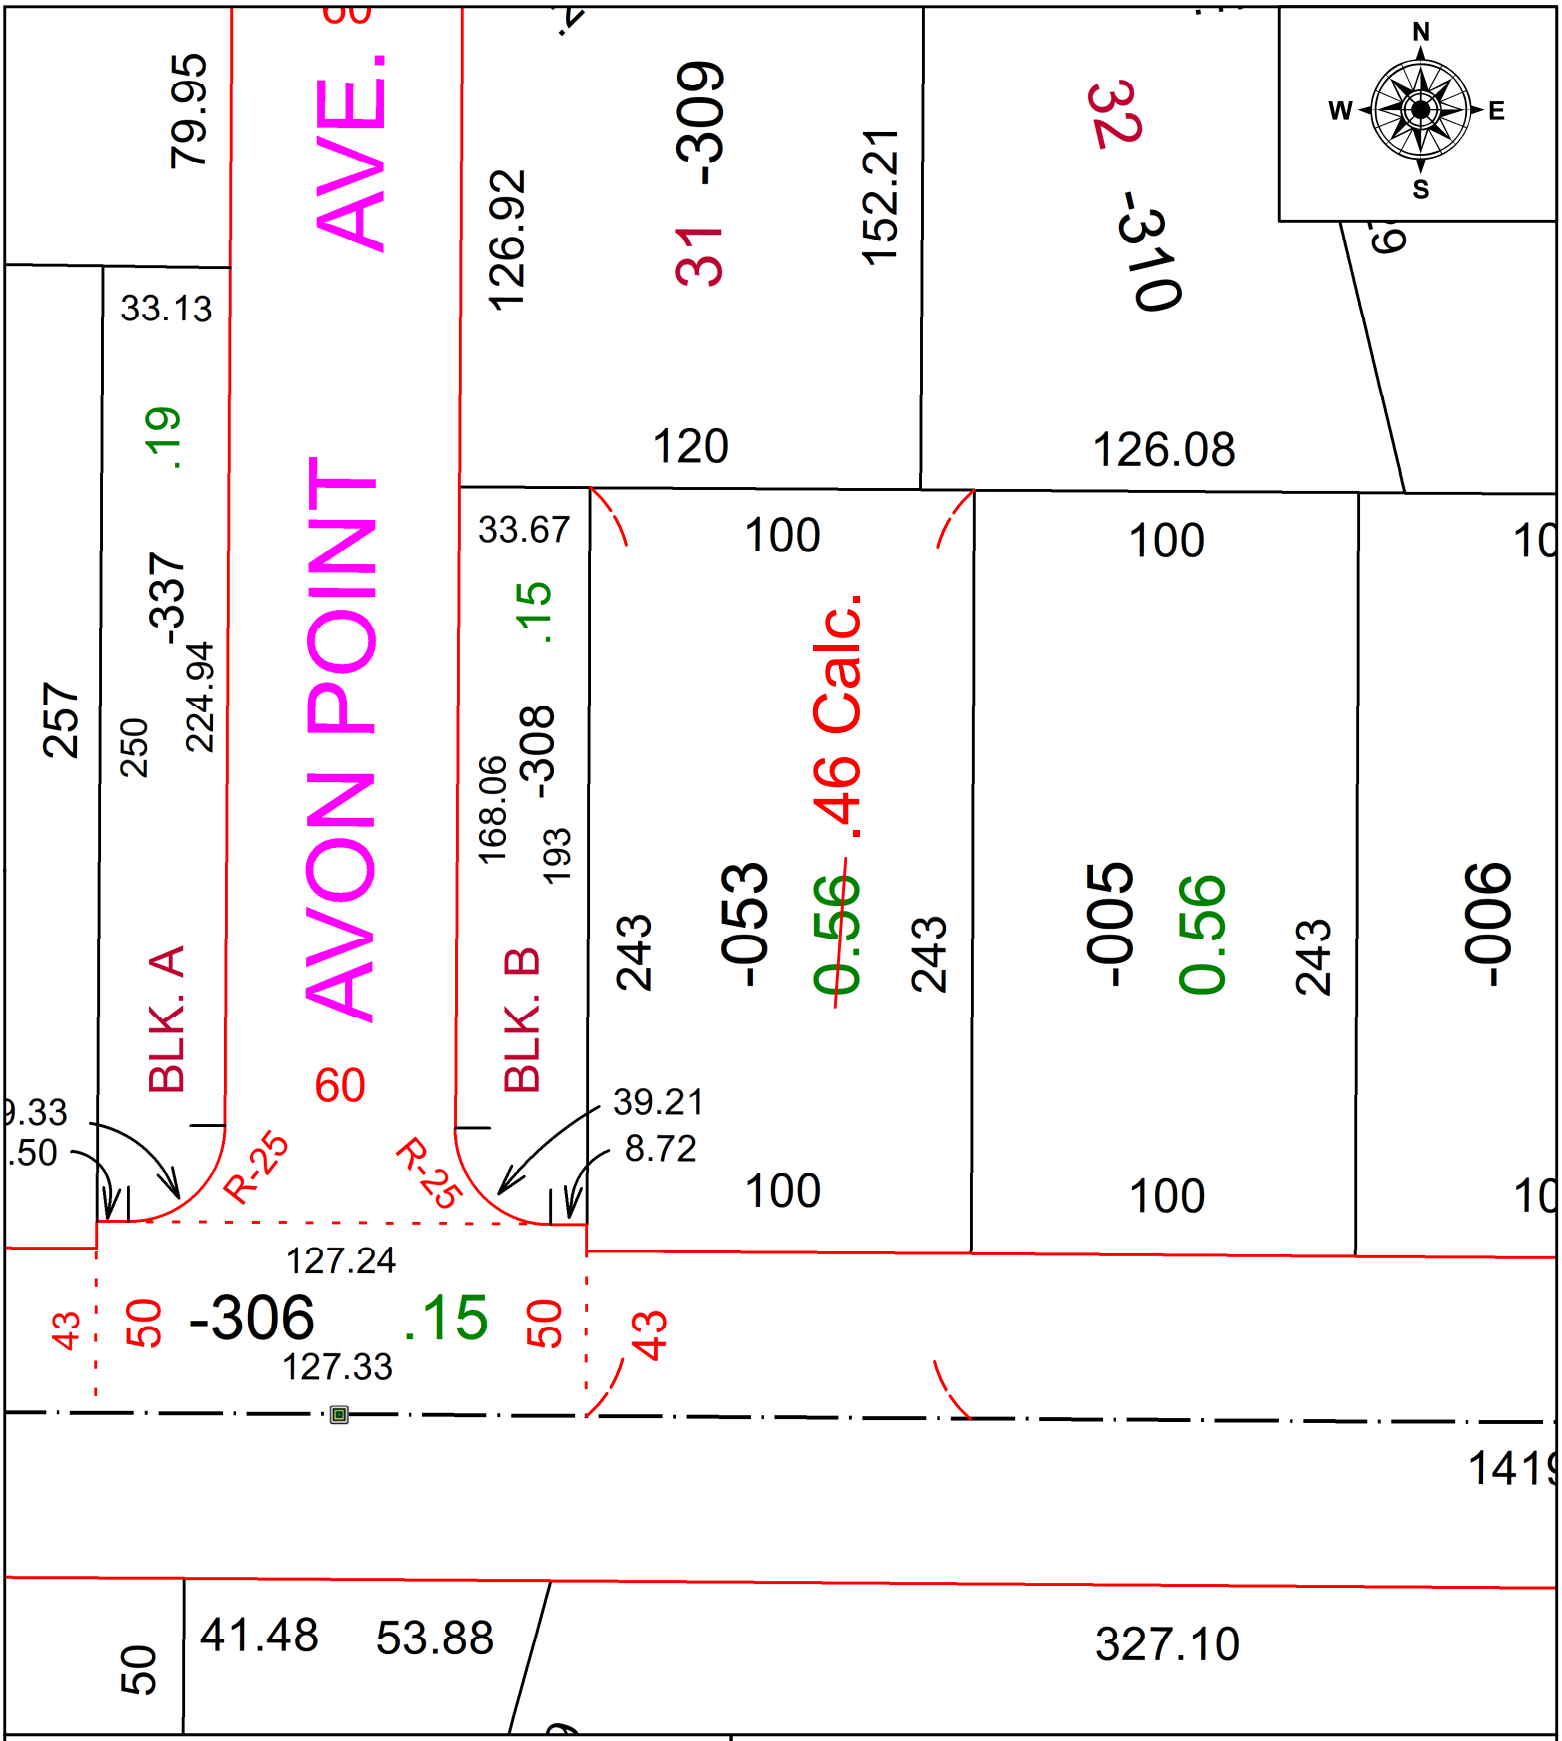

SPLITS/DEEDS PROCESSED

LORAIN COUNTY TAX MAP DEPARTMENT
226 MIDDLE AVE. ELYRIA, OH

SURVEYED BY: N/A
CLOSURE: N/A
MAP PAGE(S): 04-00-020
APPOVED BY: DMA **DATE:** 3/30/2022
SCALE: 1" = 50' **PRIOR INSTRUMENT:** D.V. 1368 PG. 493