PARENT PARCEL: 06-21-002-000-061
CHILD PARCEL: N/A
STARTING POINT: ACREAGE CORRECTION PER PRIOR DEED

22-04830-C

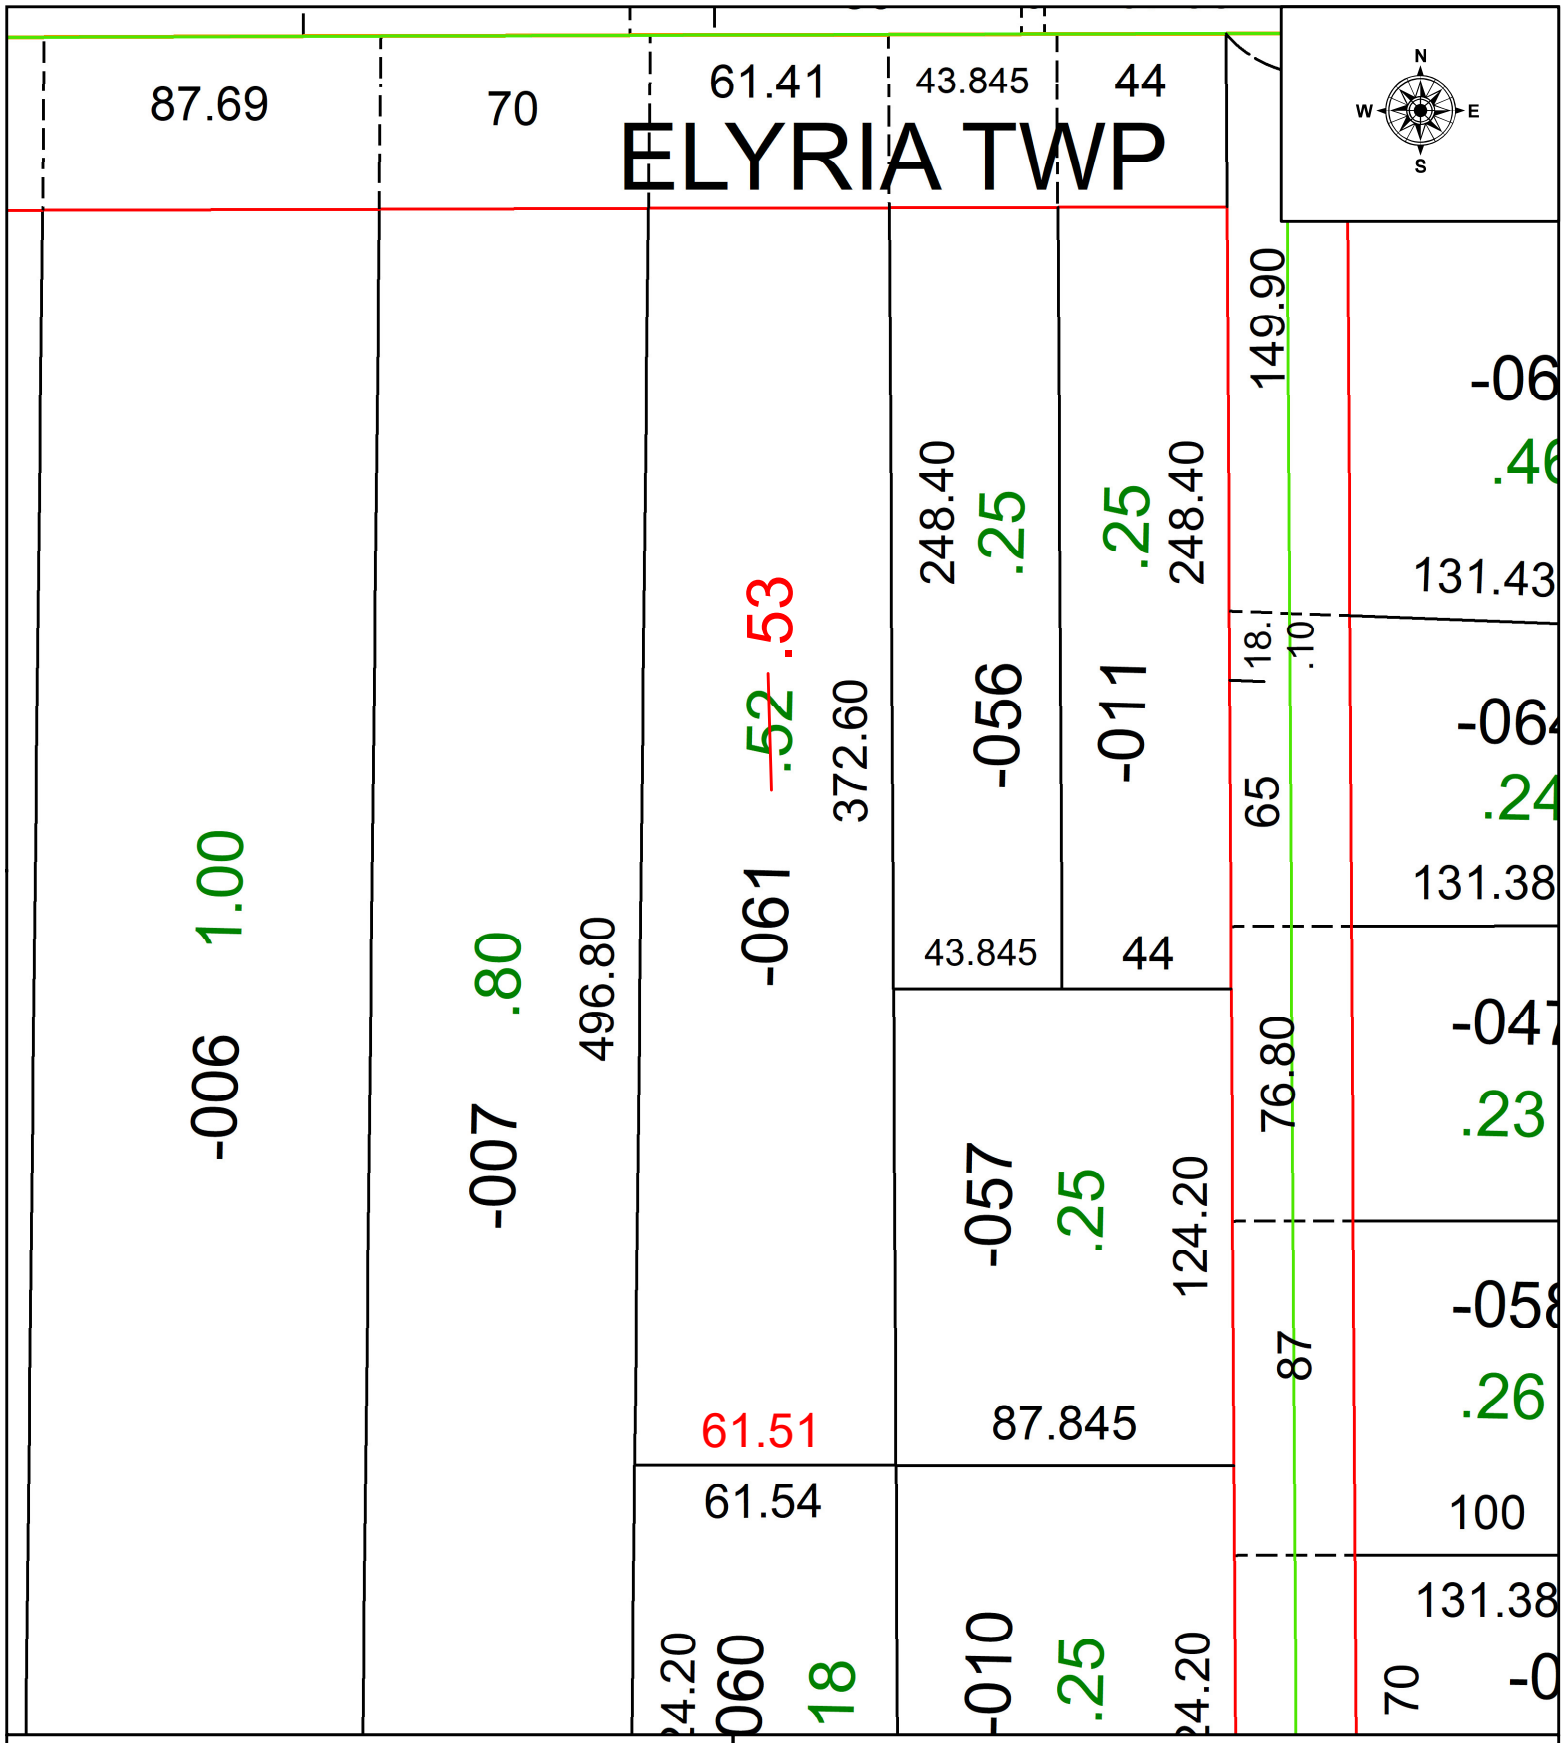

SPLITS/DEEDS PROCESSED
LORAIN COUNTY TAX MAP DEPARTMENT
226 MIDDLE AVE. ELYRIA, OH

SURVEYED BY: N/A
CLOSURE: N/A
MAP PAGE(S): 06-21-002
APPOVED BY: WRZ **DATE:** 4/1/2022
SCALE: 1" = 50 **PRIOR INSTRUMENT:** DV 1342 PG 93