PARENT PARCEL: 05-00-041-105-049 & -055

CHILD PARCEL: N/A AC CORR. PER MICHAEL SPELLACY

STARTING POINT: INTERSECTION OF C/L OF LEAVITT RD AT MONUMENT BOX & SOUTHEASTERLY CORNER OF O.L. 40

22-04831-A

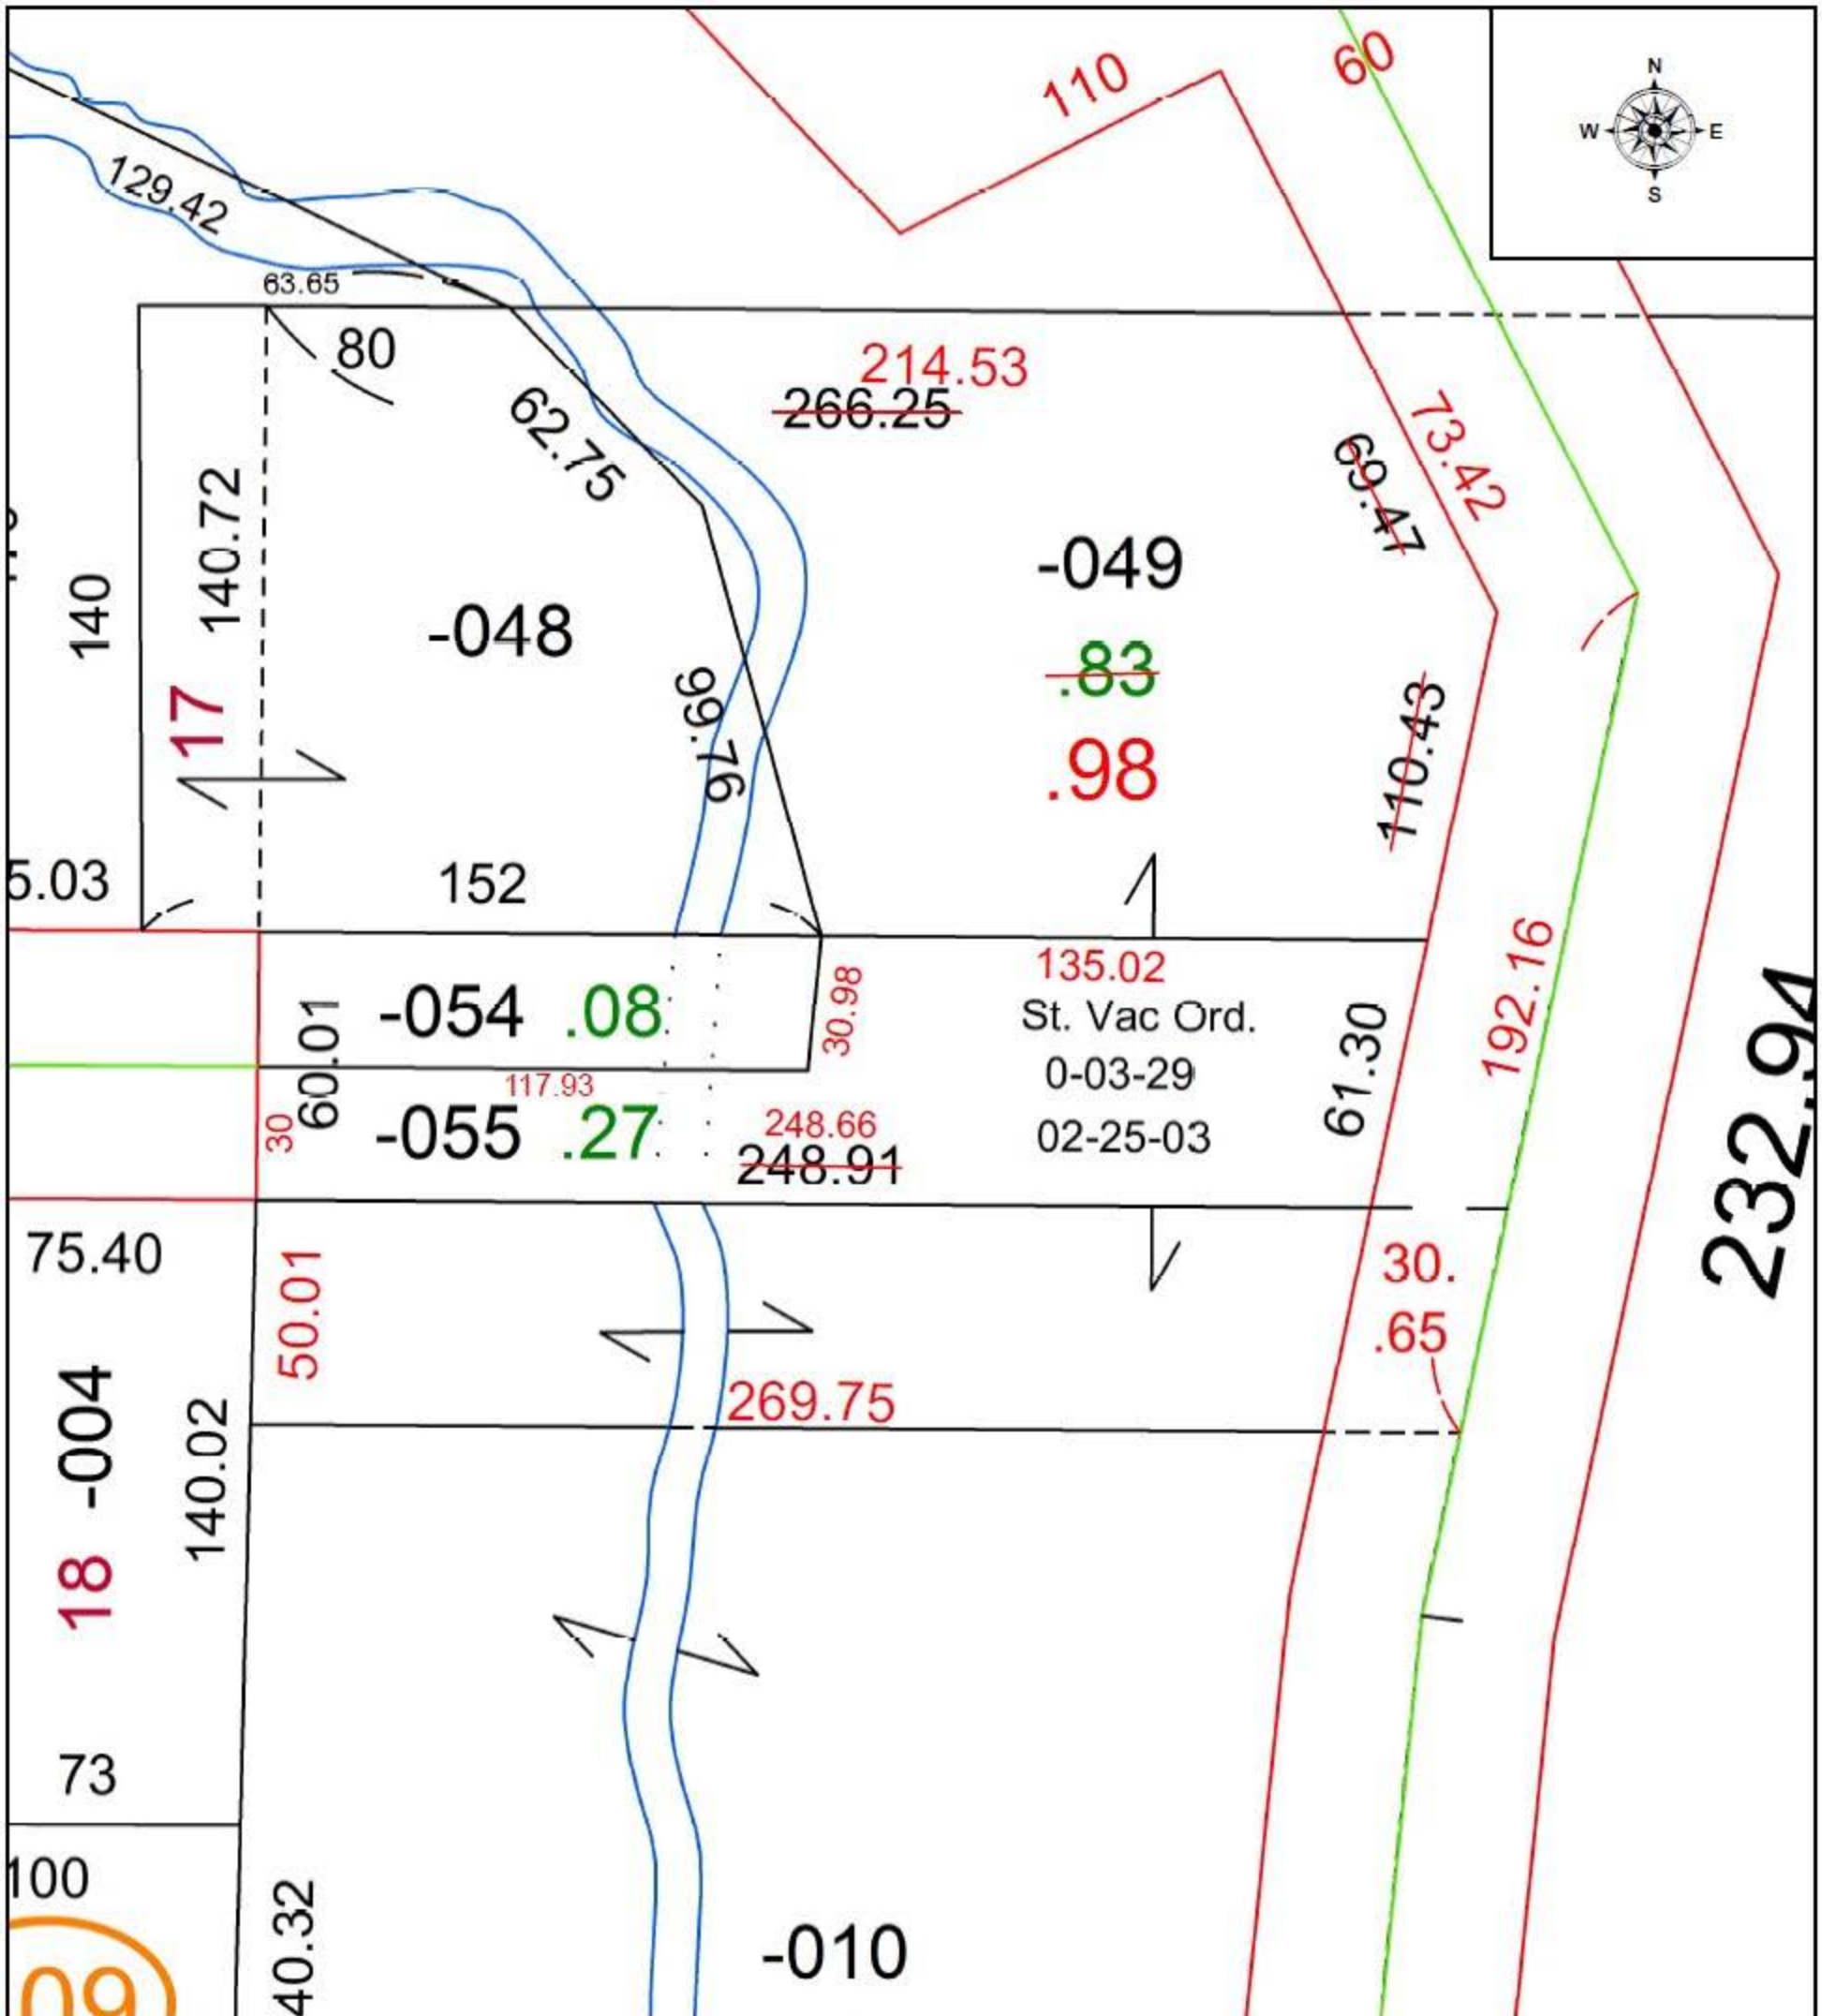

SPLITS/DEEDS PROCESSED

LORAIN COUNTY TAX MAP DEPARTMENT
226 MIDDLE AVE. ELYRIA, OH

SURVEYED BY: MICHAEL SPELLACY
CLOSURE: 1: 73784
MAP PAGE(S): 05-00-041
APPOVED BY: WRZ **DATE:** 4/25/2022
SCALE: 1" = 50 **PRIOR INSTRUMENT:** 2016-0613712