**PARENT PARCEL:** 04-00-023-105-057, -059, & -060

**CHILD PARCEL:** N/A ACREAGE CORRECTION PER WILLIAM WALLACE

**STARTING POINT:** INTERSECTION OF NORTHERLY LINE OF O.S. 23 AND C/L OF JAYCOX RD

# 22-04833-C

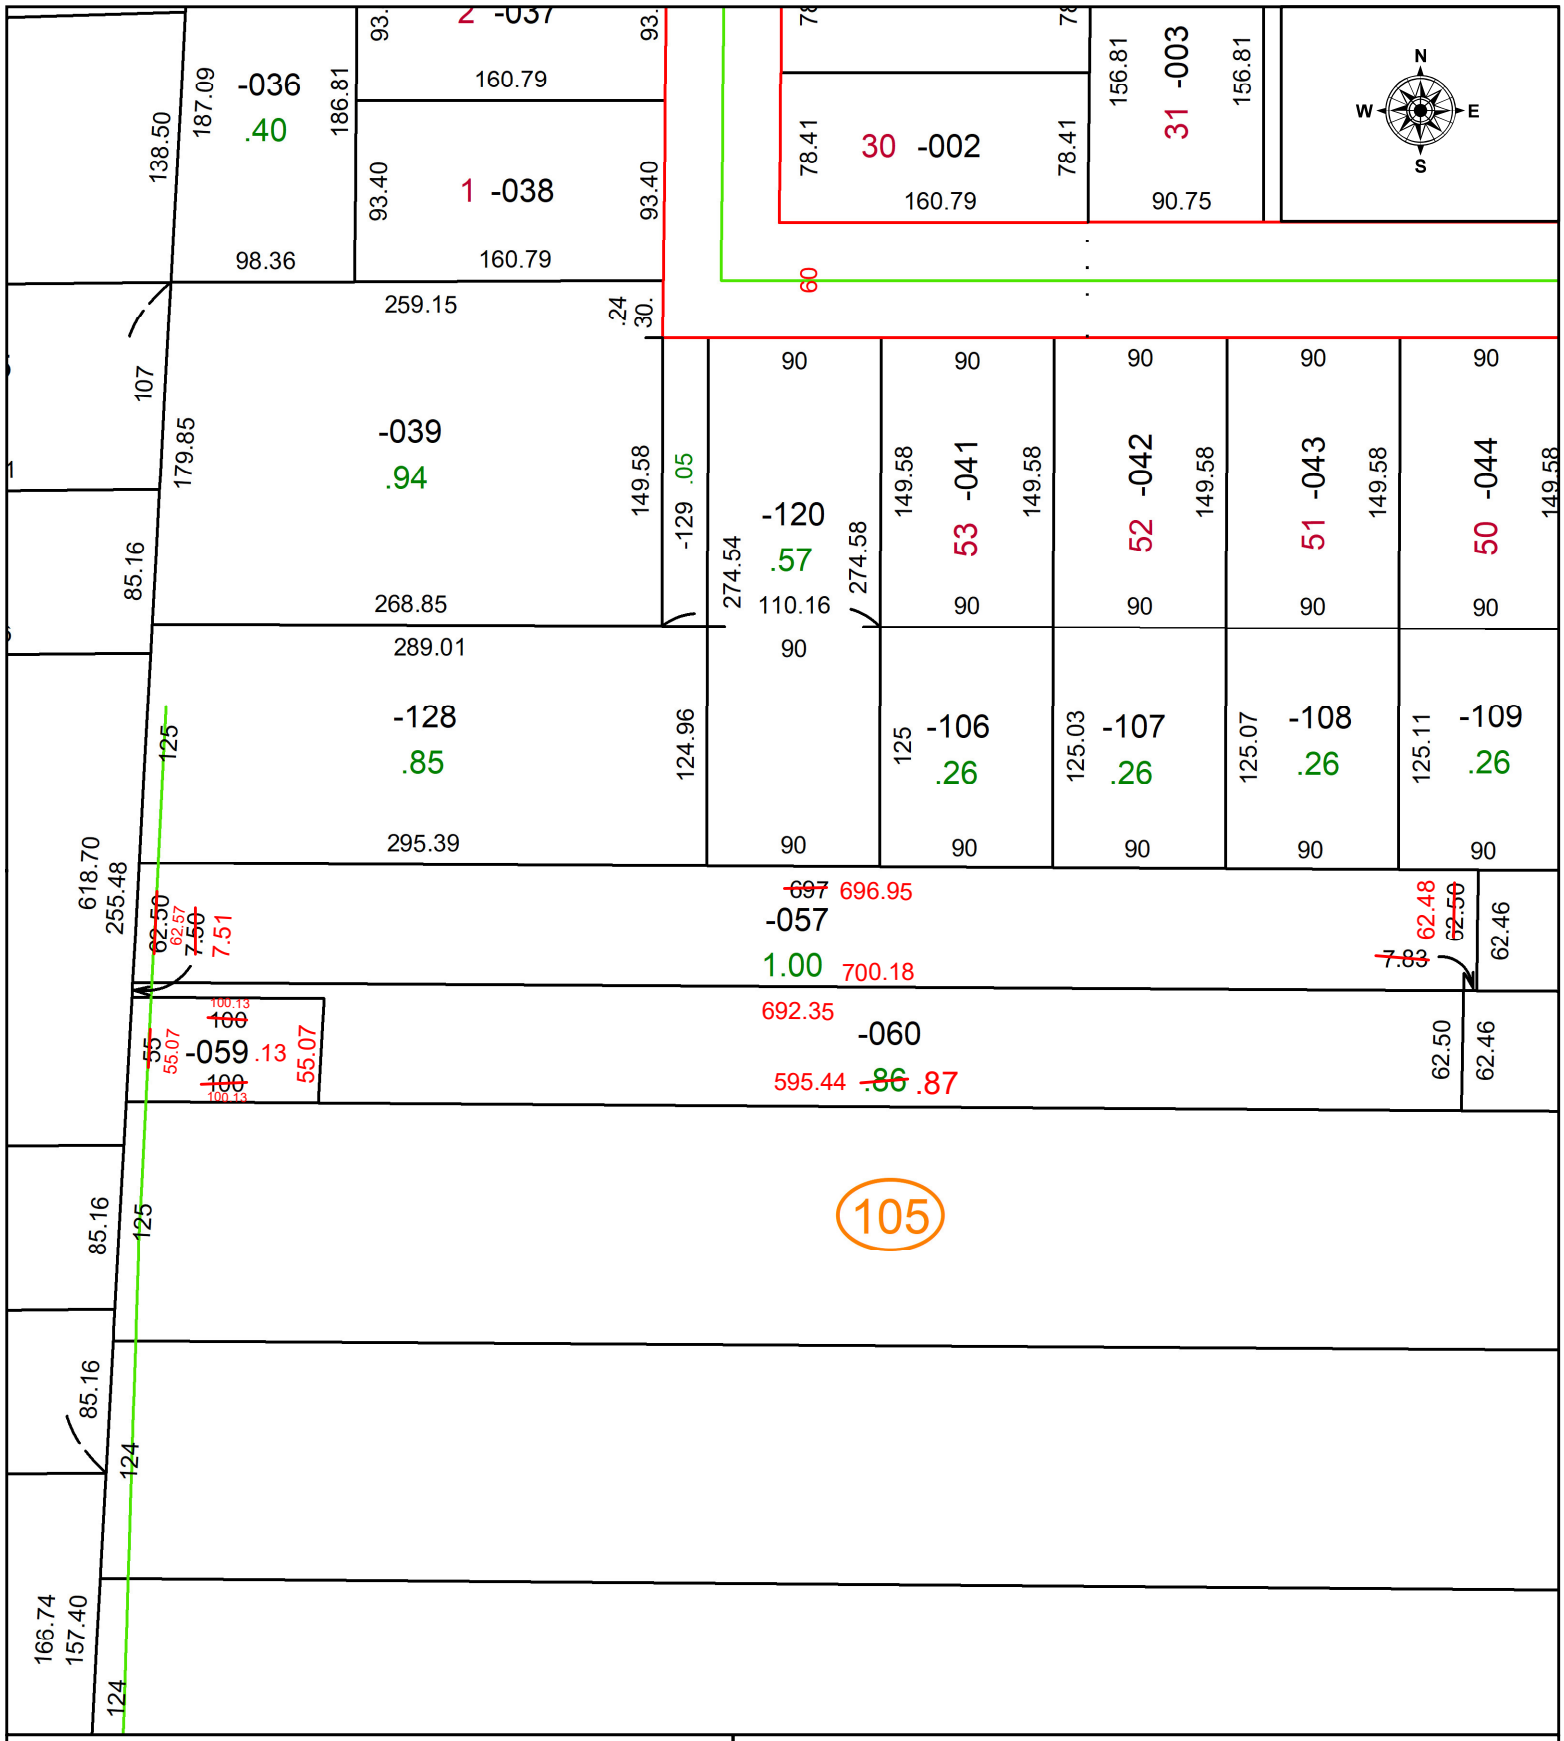


**SPLITS/DEEDS PROCESSED**

LORAIN COUNTY TAX MAP DEPARTMENT
226 MIDDLE AVE. ELYRIA, OH

**SURVEYED BY:** WILLIAM WALLACE
**CLOSURE:** 1: 150976
**MAP PAGE(S):** 04-00-023
**APPOVED BY:** WRZ **DATE:** 4/5/2022
**SCALE:** 1" = 100 **PRIOR INSTRUMENT:** 2021-0846444