PARENT PARCEL: 04-00-023-102-034 & -151

CHILD PARCEL: 04-00-023-102-158

STARTING POINT: C/L OF JAYCOX RD AND SADLE CREEK

24-04834

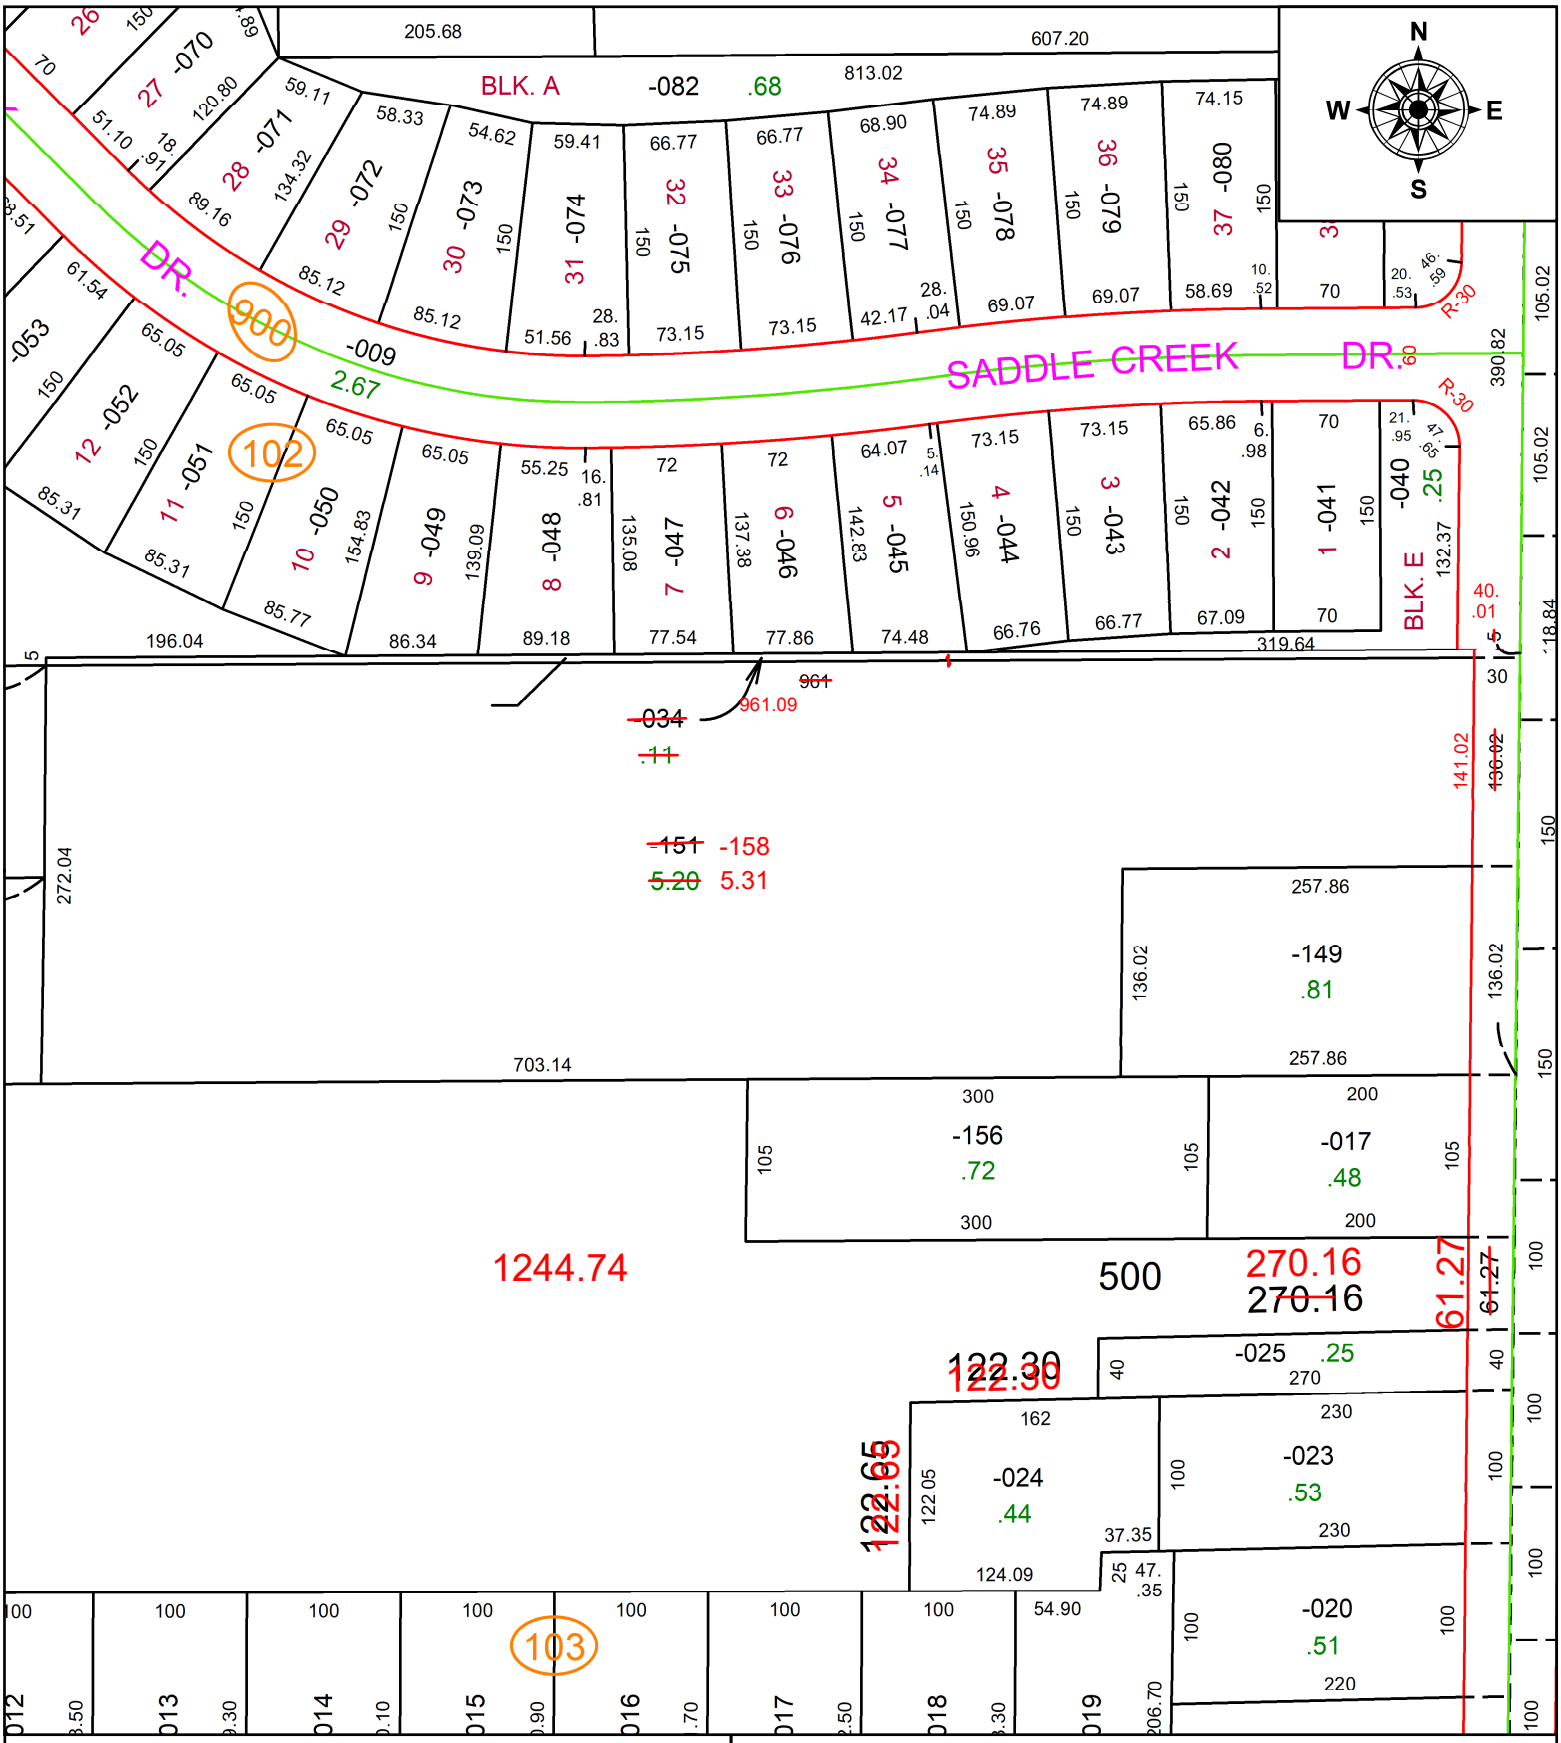

SPLITS/DEEDS PROCESSED

LORAIN COUNTY TAX MAP DEPARTMENT
226 MIDDLE AVE. ELYRIA, OH

SURVEYED BY: RICHARD A. THOMPSON JR **SURV # 51145**

CLOSURE: 1: 1374699

MAP PAGE(S): 04-00-023

APPOVED BY: AC **DATE:** April 01, 2024

SCALE: 1 in = 125 ft **PRIOR INSTRUMENT:** 2022- 0899040