PARENT PARCEL: 15-00-099-102-116 & -081
CHILD PARCEL: 15-00-099-102-119, -120, & -121
STARTING POINT: AC CORR PER SURV BY THOMAS A. SIMON

24-04835

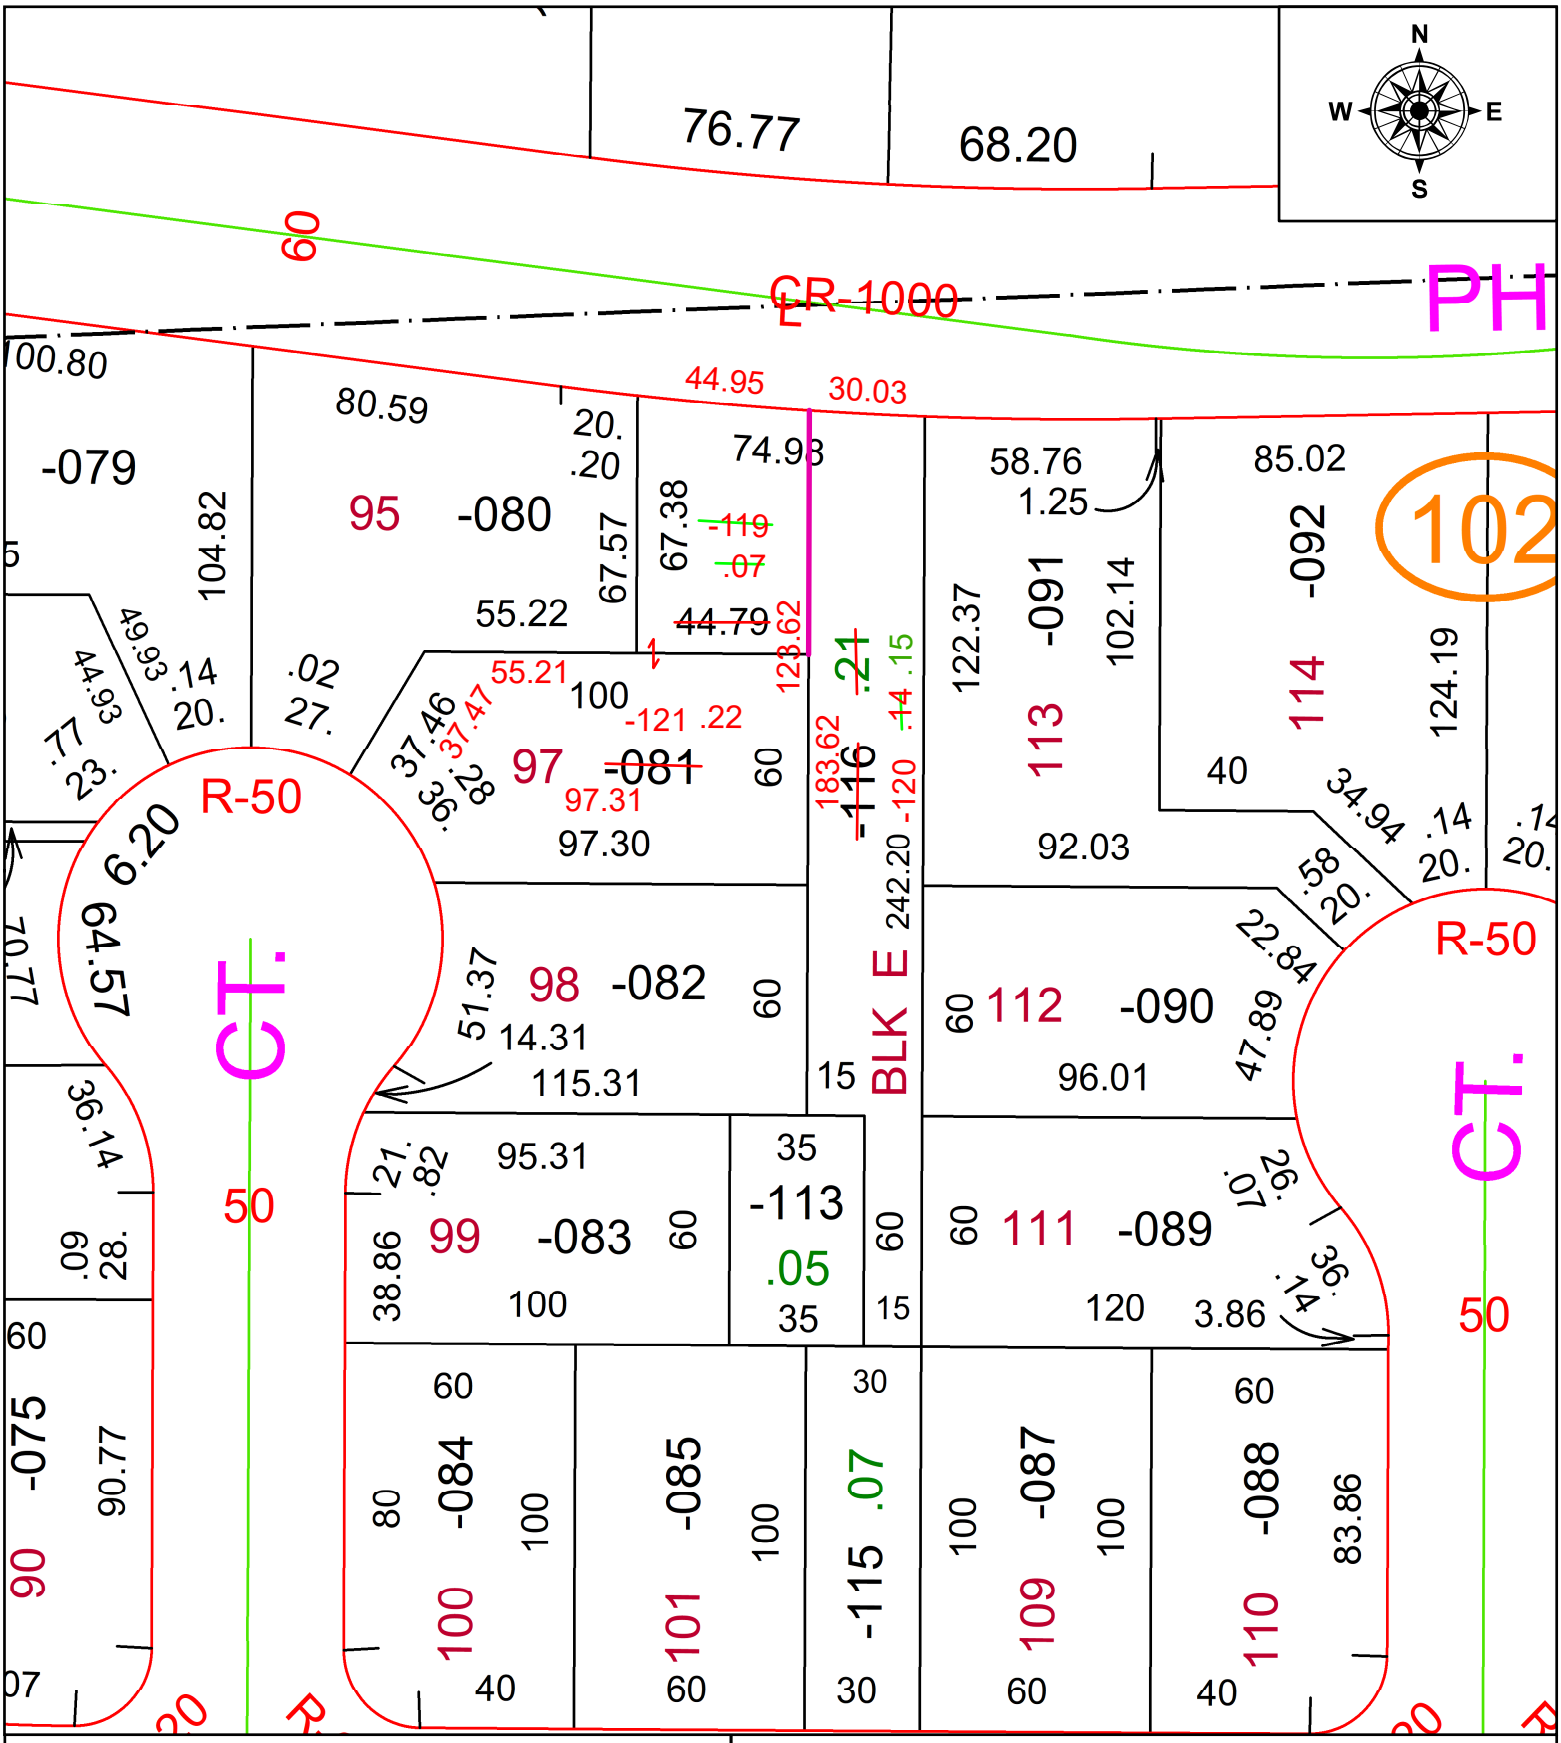

SPLITS/DEEDS PROCESSED
LORAIN COUNTY TAX MAP DEPARTMENT
226 MIDDLE AVE. ELYRIA, OH

SURVEYED BY: THOMAS A. SIMON **SURV # 51147**
CLOSURE: 1: 111476
MAP PAGE(S): 15-00-099
APPOVED BY: AC **DATE:** April 03, 2024
SCALE: 1 in = 50 ft **PRIOR INSTRUMENT:** 2019- 0735197