PARENT PARCEL: 07-00-038-000-029

CHILD PARCEL: AC CORR PER SURV BY WILFREDO BARBOSA

STARTING POINT: C/L OF SUGAR RIDGE AND BENDER RD

22-04837-A

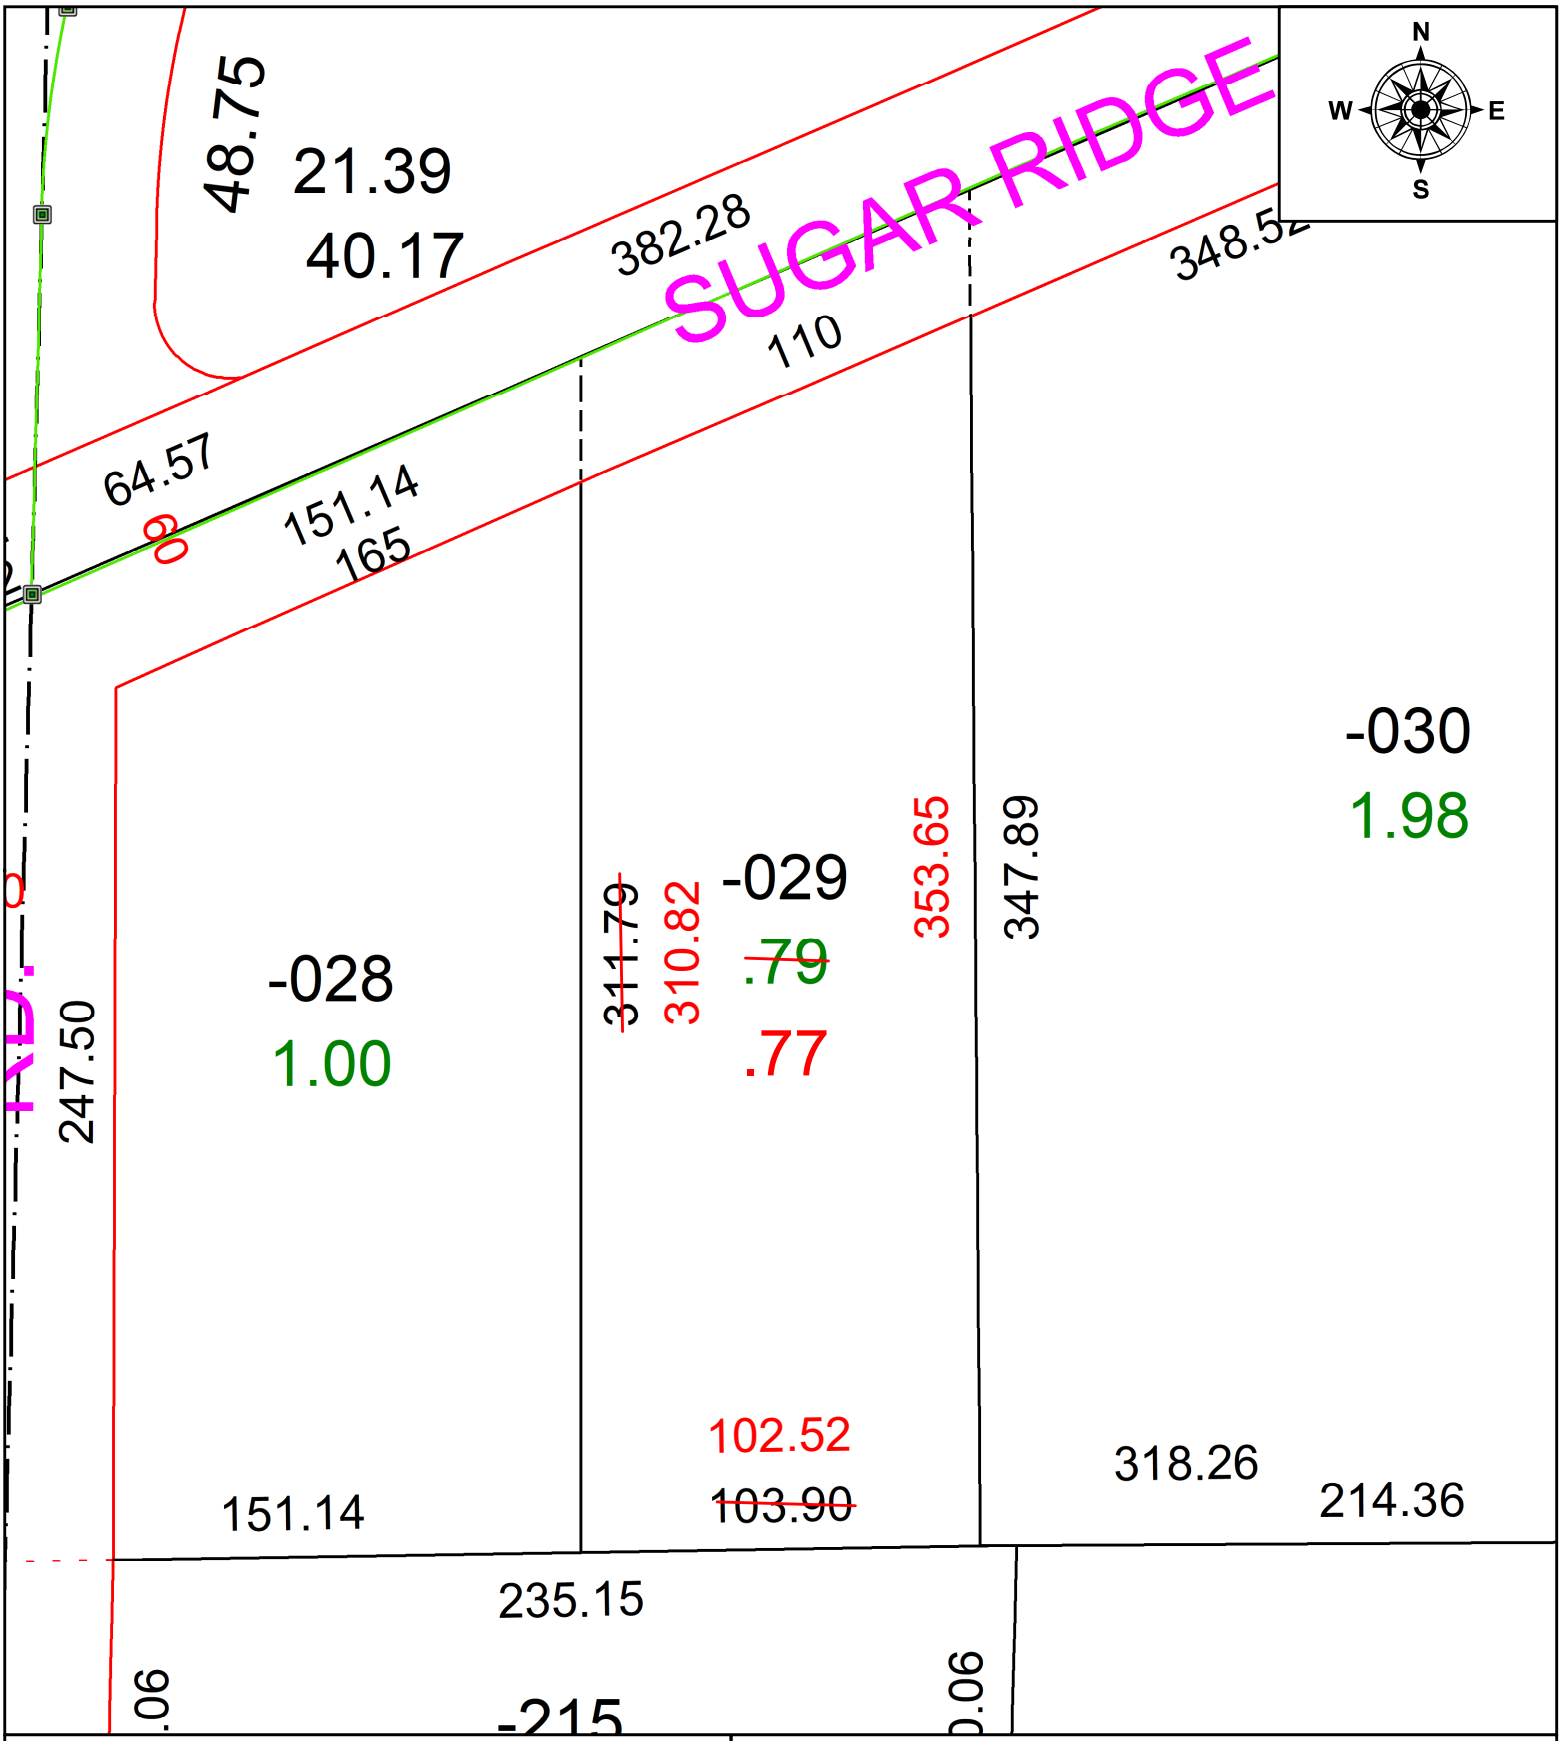

SPLITS/DEEDS PROCESSED

LORAIN COUNTY TAX MAP DEPARTMENT
226 MIDDLE AVE. ELYRIA, OH

SURVEYED BY: WILFREDO BARBOSA
CLOSURE: 1: 100789
MAP PAGE(S): 07-00-038
APPOVED BY: AC **DATE:** 4/14/2022
SCALE: 1" = 50 **PRIOR INSTRUMENT:** 2022- 0866305