PARENT PARCEL: 16-00-048-000-025

CHILD PARCEL: 16-00-048-000-049 & -050 AC CORR PER SURVEYOR THOMAS SIMON

STARTING POINT: IRON PIN IN MONUMENT BOX @ INTERSECTION OF C/LS ISLAND RD & ST RT 303, SOUTHWESTERLY CORNER OF O.L. 48

24-04838

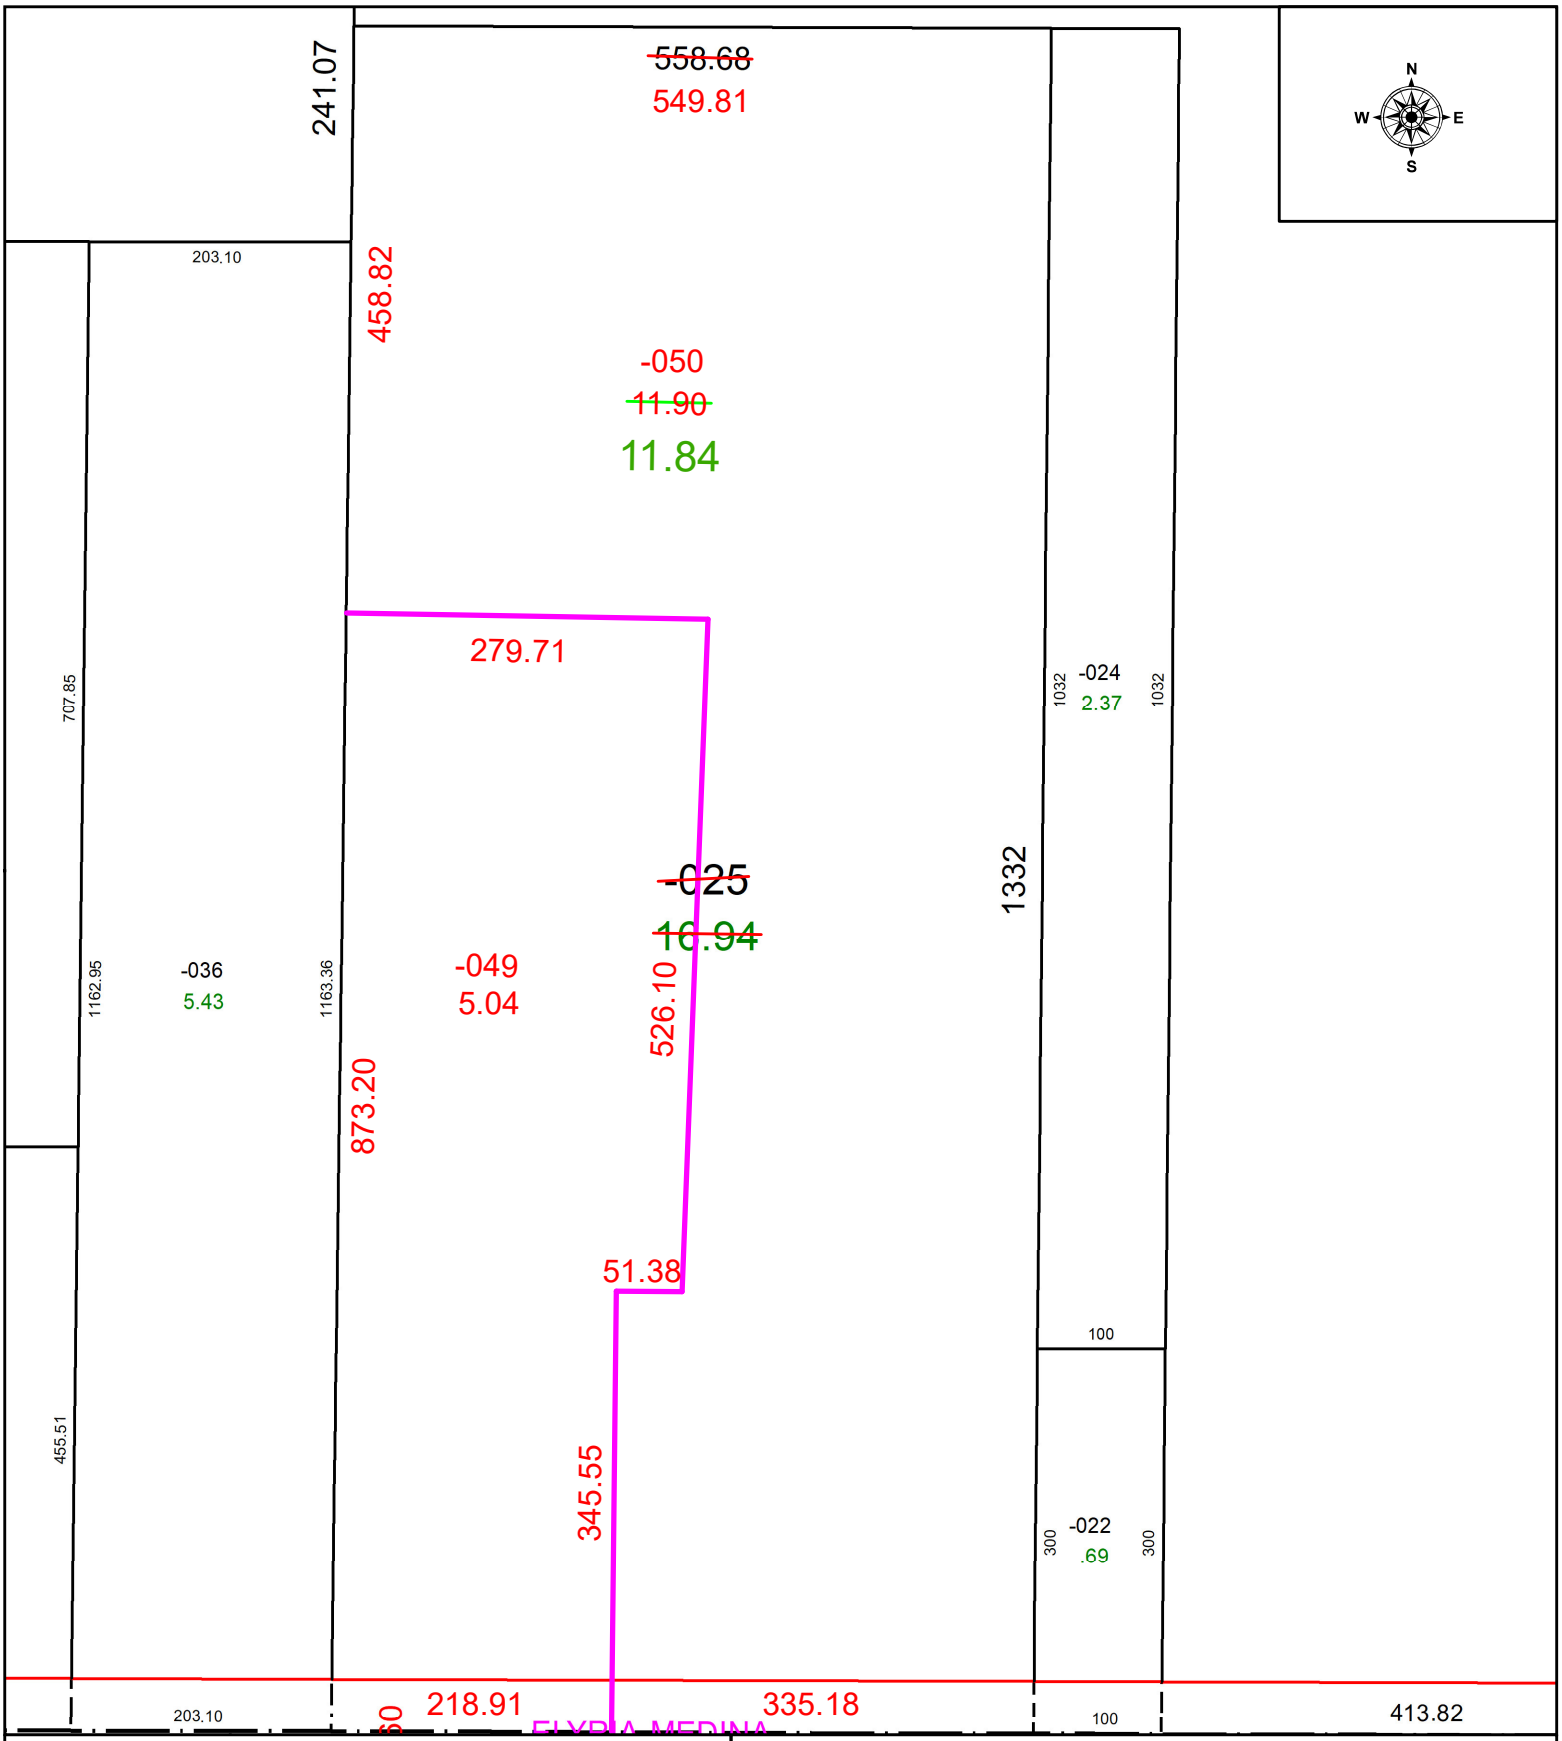

SPLITS/DEEDS PROCESSED

LORAIN COUNTY TAX MAP DEPARTMENT
226 MIDDLE AVE. ELYRIA, OH

SURVEYED BY: THOMAS SIMON SURVEY # 51150

CLOSURE: 1: 266101

MAP PAGE(S): 16-00-048

APPOVED BY: WRZ **DATE:** 4/3/2024

SCALE: 1" = 150 **PRIOR INSTRUMENT:** #2012-0416959