PARENT PARCEL: 11-00-045-000-058

CHILD PARCEL: 11-00-045-000-119 THRU -123

STARTING POINT: C/L OF E ROYALTON AND AVON BELDON RD

24-04839

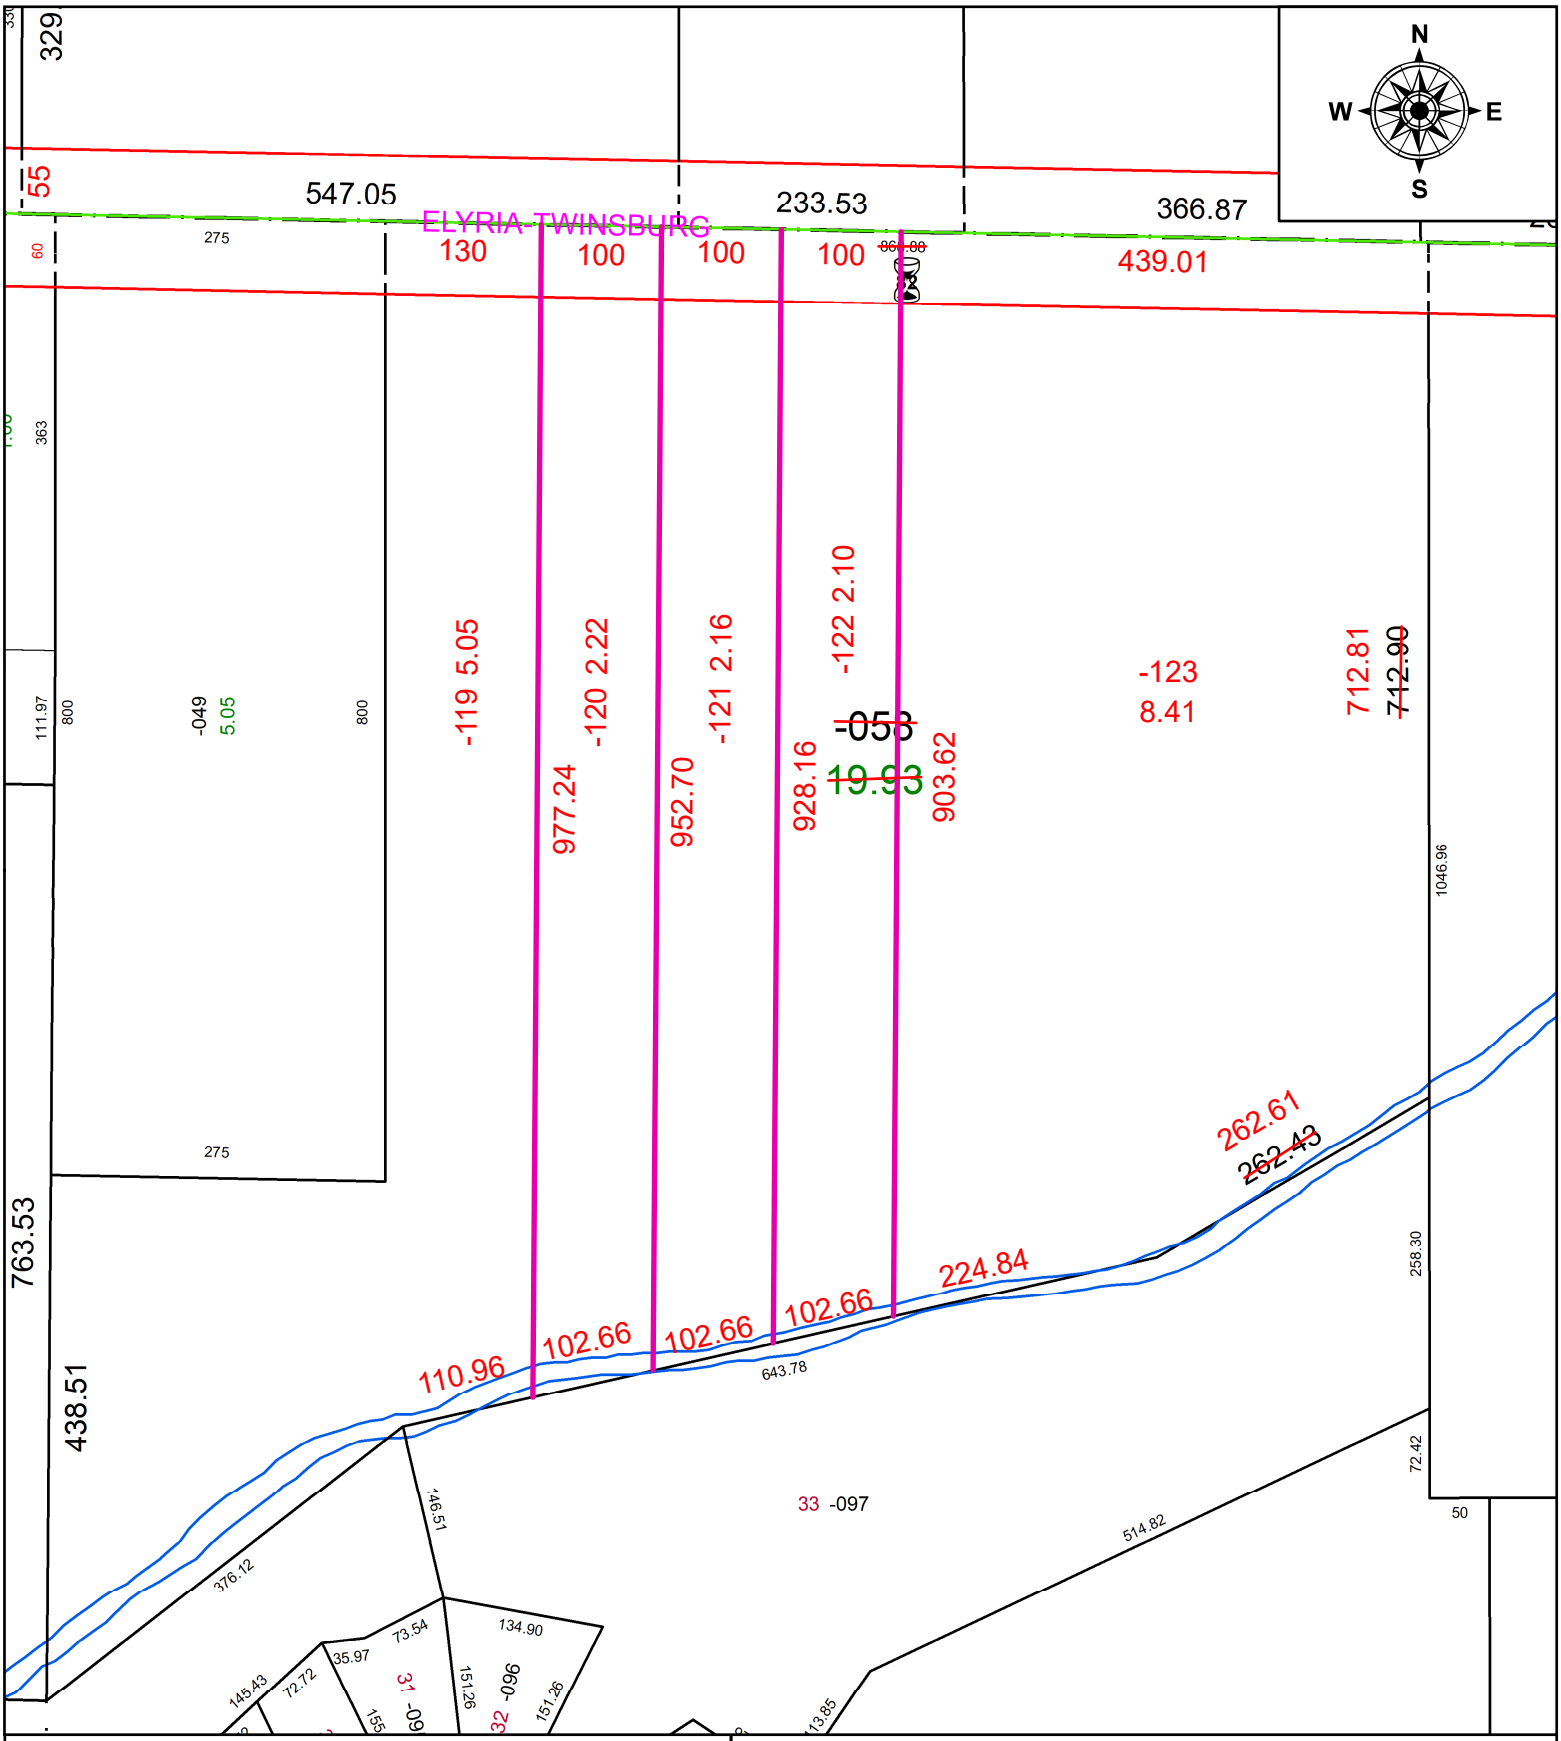

SPLITS/DEEDS PROCESSED

LORAIN COUNTY TAX MAP DEPARTMENT
226 MIDDLE AVE. ELYRIA, OH

SURVEYED BY: TREVOR A. BIXLER **SURV # 51152**

CLOSURE: 1: 871119

MAP PAGE(S): 11-00-045

APPOVED BY: AC **DATE:** April 04, 2024

SCALE: 1 in = 160 ft **PRIOR INSTRUMENT:** 2019- 0743414