PARENT PARCEL: 10-00-024-000-200, -011, -153, -156, -158, -159, & -195

CHILD PARCEL: 10-00-024-000-224 THRU -240

STARTING POINT: AC CORR PER SURV BY THOMAS A. SIMON

24-04840

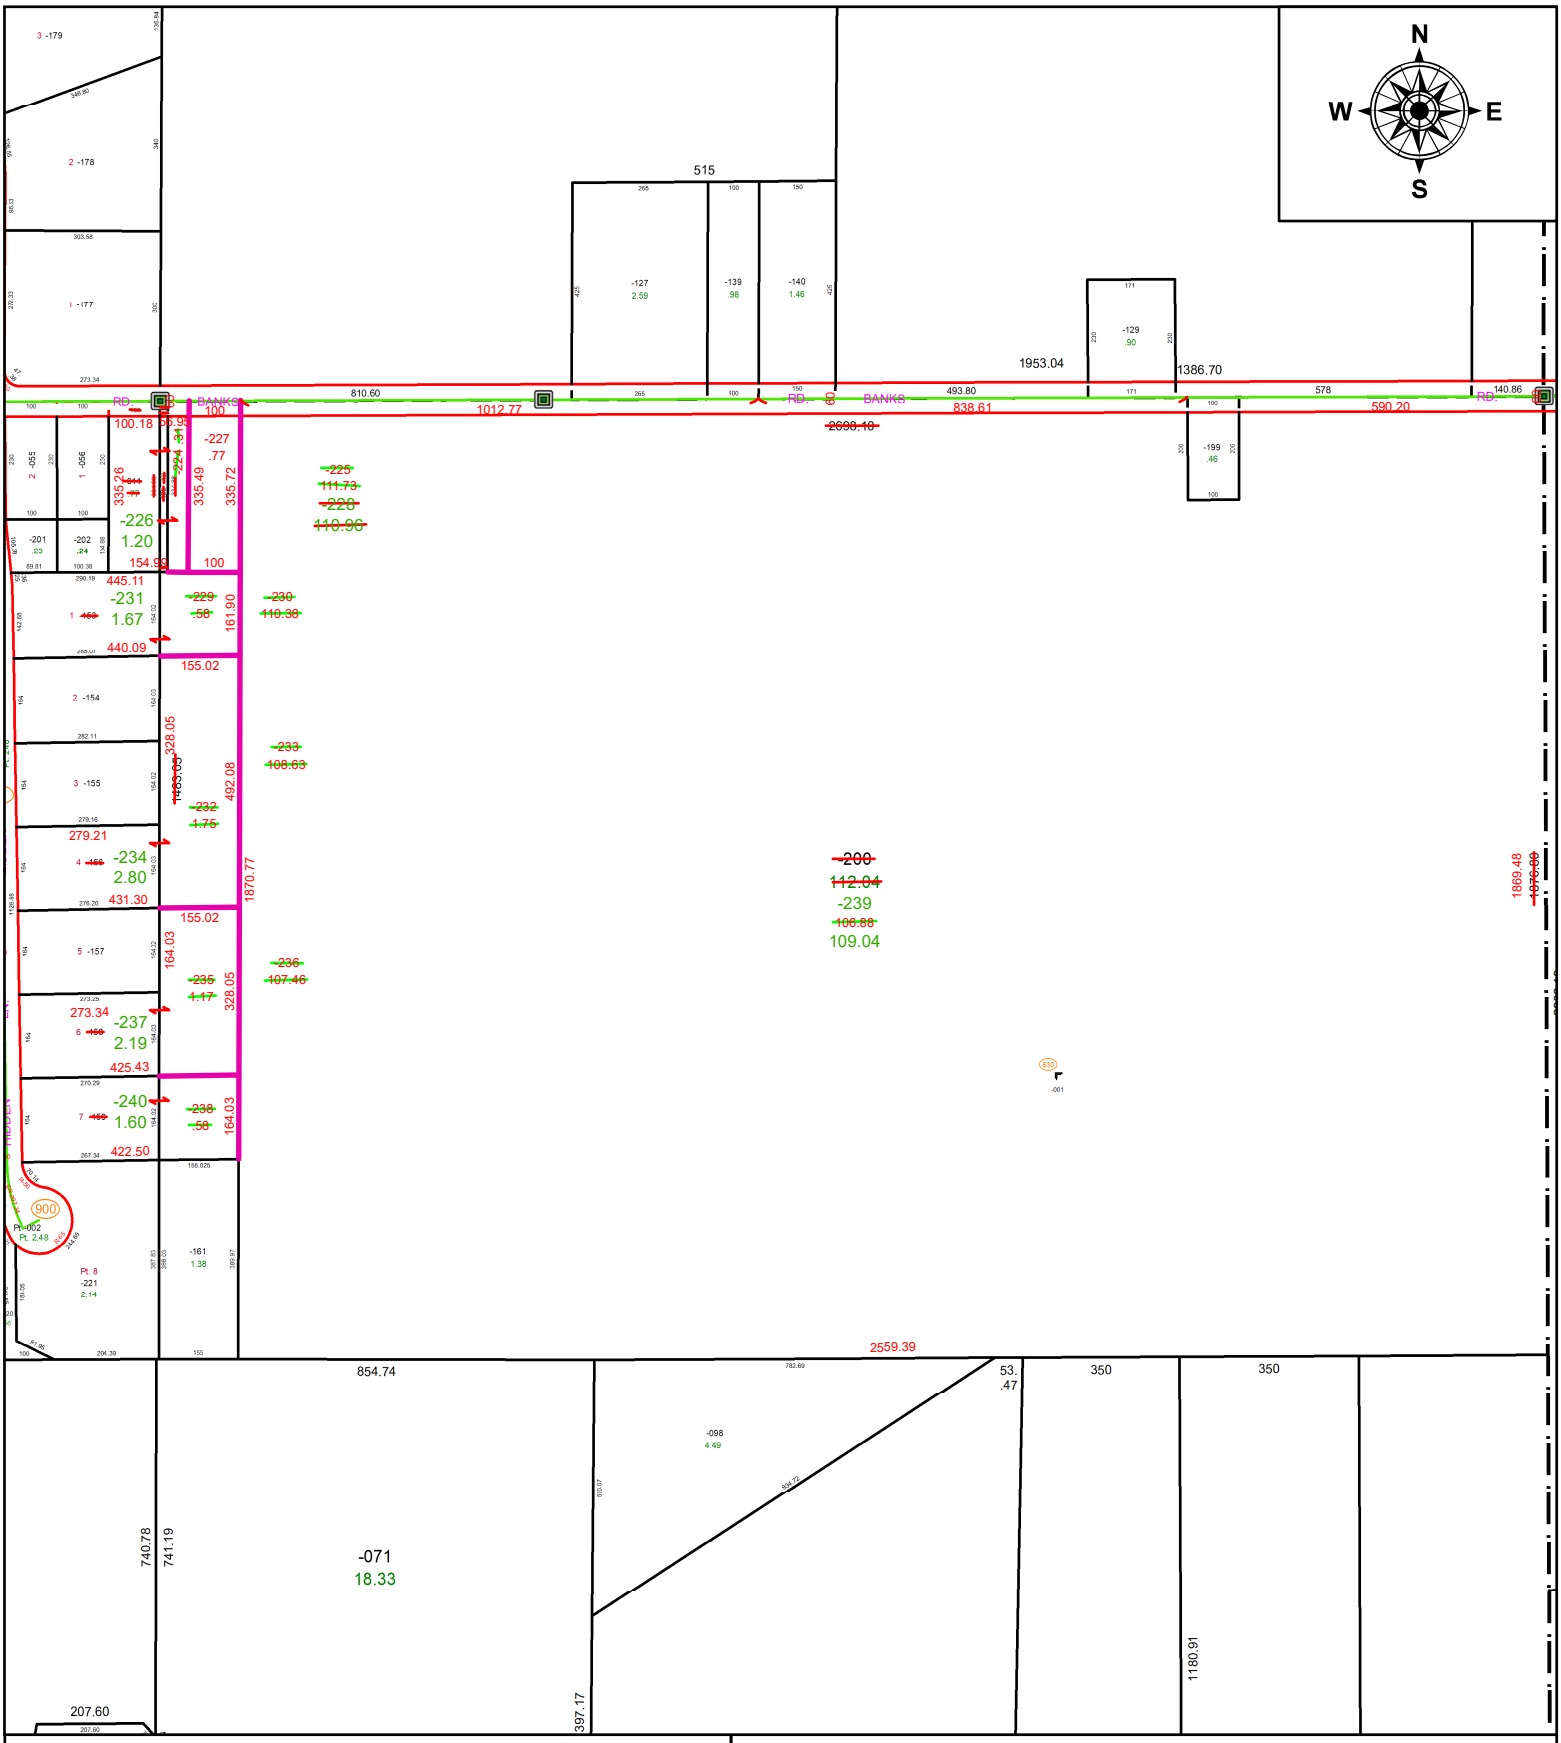

SPLITS/DEEDS PROCESSED

LORAIN COUNTY TAX MAP DEPARTMENT
226 MIDDLE AVE. ELYRIA, OH

SURVEYED BY: THOMAS A. SIMON **SURV # 51154**

CLOSURE: 1: 219020

MAP PAGE(S): 10-00-024

APPOVED BY: AC **DATE:** April 05, 2024

SCALE: 1 in = 375 ft **PRIOR INSTRUMENT:** 2015- 0530653