PARENT PARCEL: 05-00-068-000-028

CHILD PARCEL: 05-00-068-000-052 & -053 AC CORR PER SURVEYOR THOMAS SIMON

STARTING POINT: SOUTHEASTERLY CORNER OF O.L. 68

24-04841

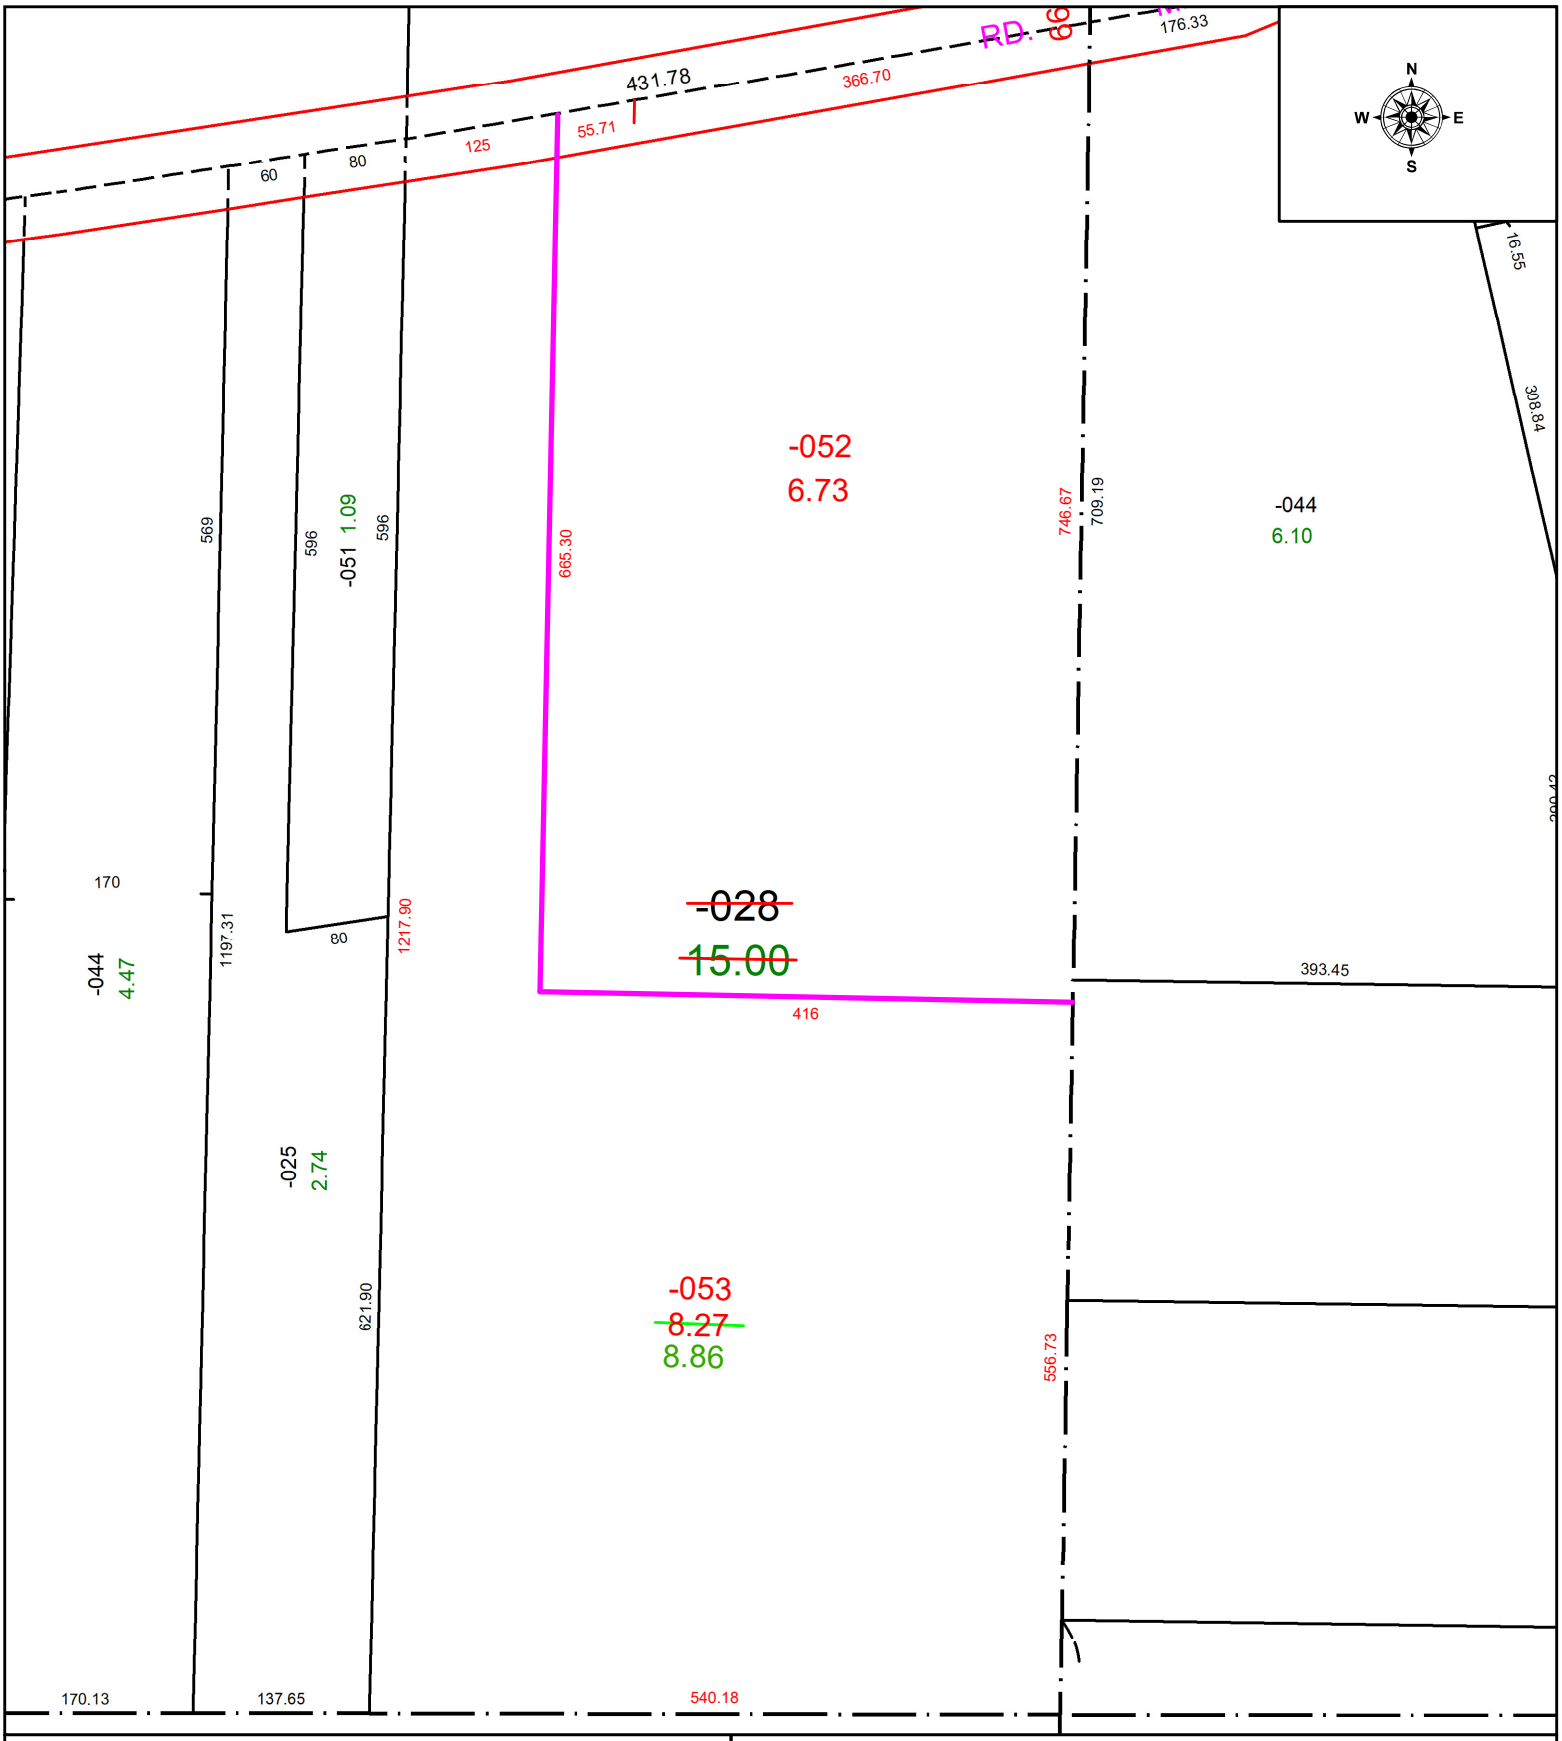

SPLITS/DEEDS PROCESSED

LORAIN COUNTY TAX MAP DEPARTMENT
226 MIDDLE AVE. ELYRIA, OH

SURVEYED BY: THOMAS SIMON SURVEY # 51155

CLOSURE: 1: 253011

MAP PAGE(S): 05-00-068

APPOVED BY: WRZ **DATE:** 4/9/2024

SCALE: 1" = 150 **PRIOR INSTRUMENT:** DV 1122/367