PARENT PARCEL: 05-00-068-000-011

CHILD PARCEL: 05-00-068-000-054, -055, -056, & -057 AC CORR PER SURVEYOR THOMAS SIMON

STARTING POINT: NORTHEASTERLY CORNER OF O.L. 68

24-04842

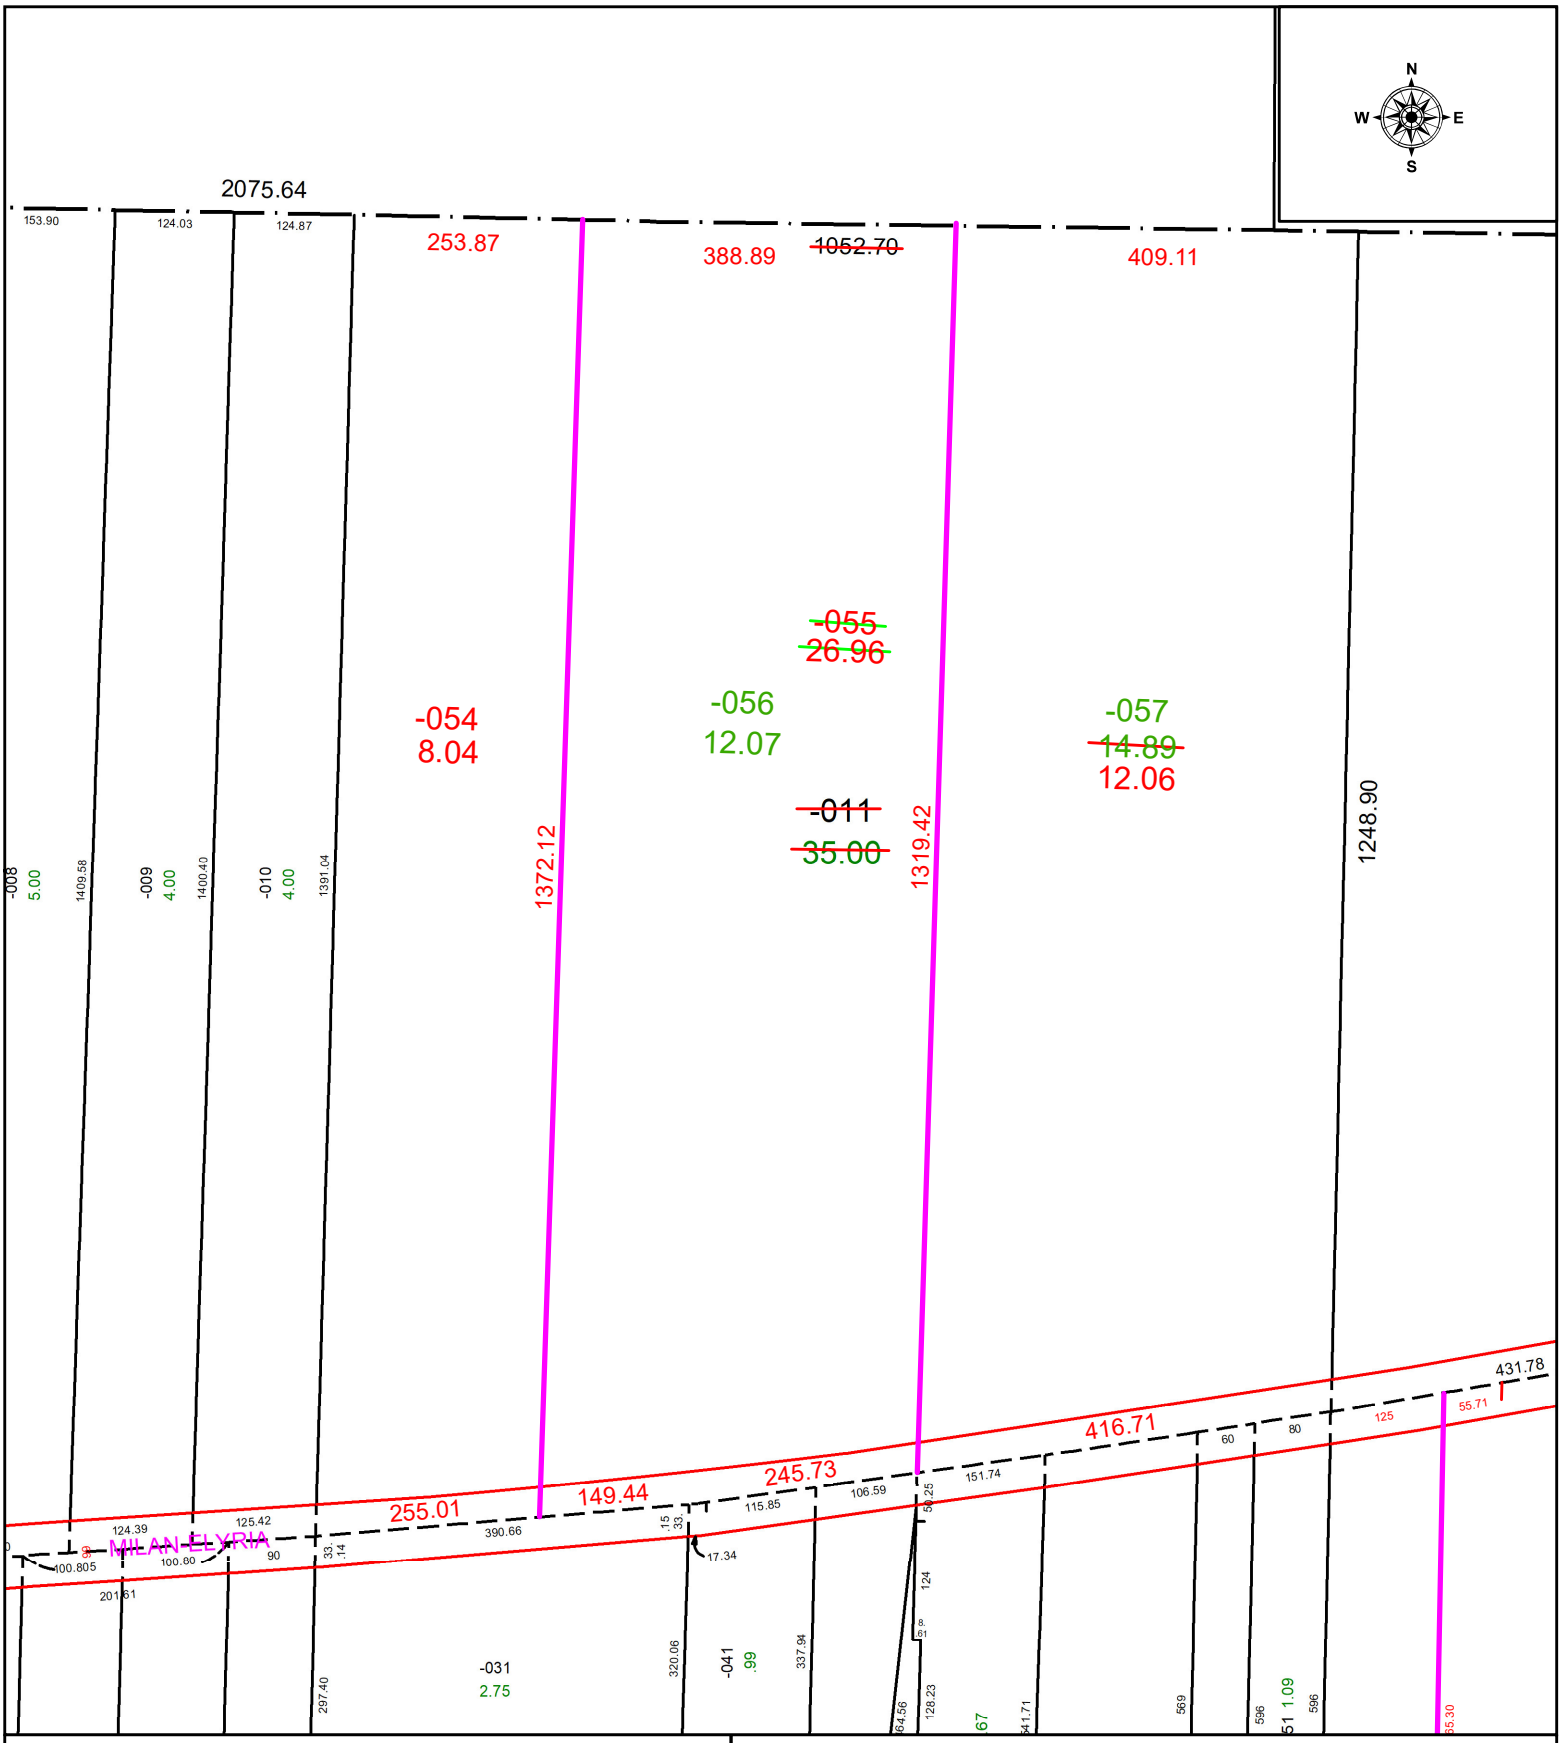

SPLITS/DEEDS PROCESSED

LORAIN COUNTY TAX MAP DEPARTMENT
226 MIDDLE AVE. ELYRIA, OH

SURVEYED BY: THOMAS SIMON SURVEY # 51156

CLOSURE: 1: 631013

MAP PAGE(S): 05-00-068

APPOVED BY: WRZ **DATE:** 4/10/2024

SCALE: 1" = 200 **PRIOR INSTRUMENT:** #2023-0926413