PARENT PARCEL: 02-01-003-169-011

CHILD PARCEL: 02-01-003-169-025 & -026 CALC. PER TAX MAP

STARTING POINT: N/A

22-04843-U

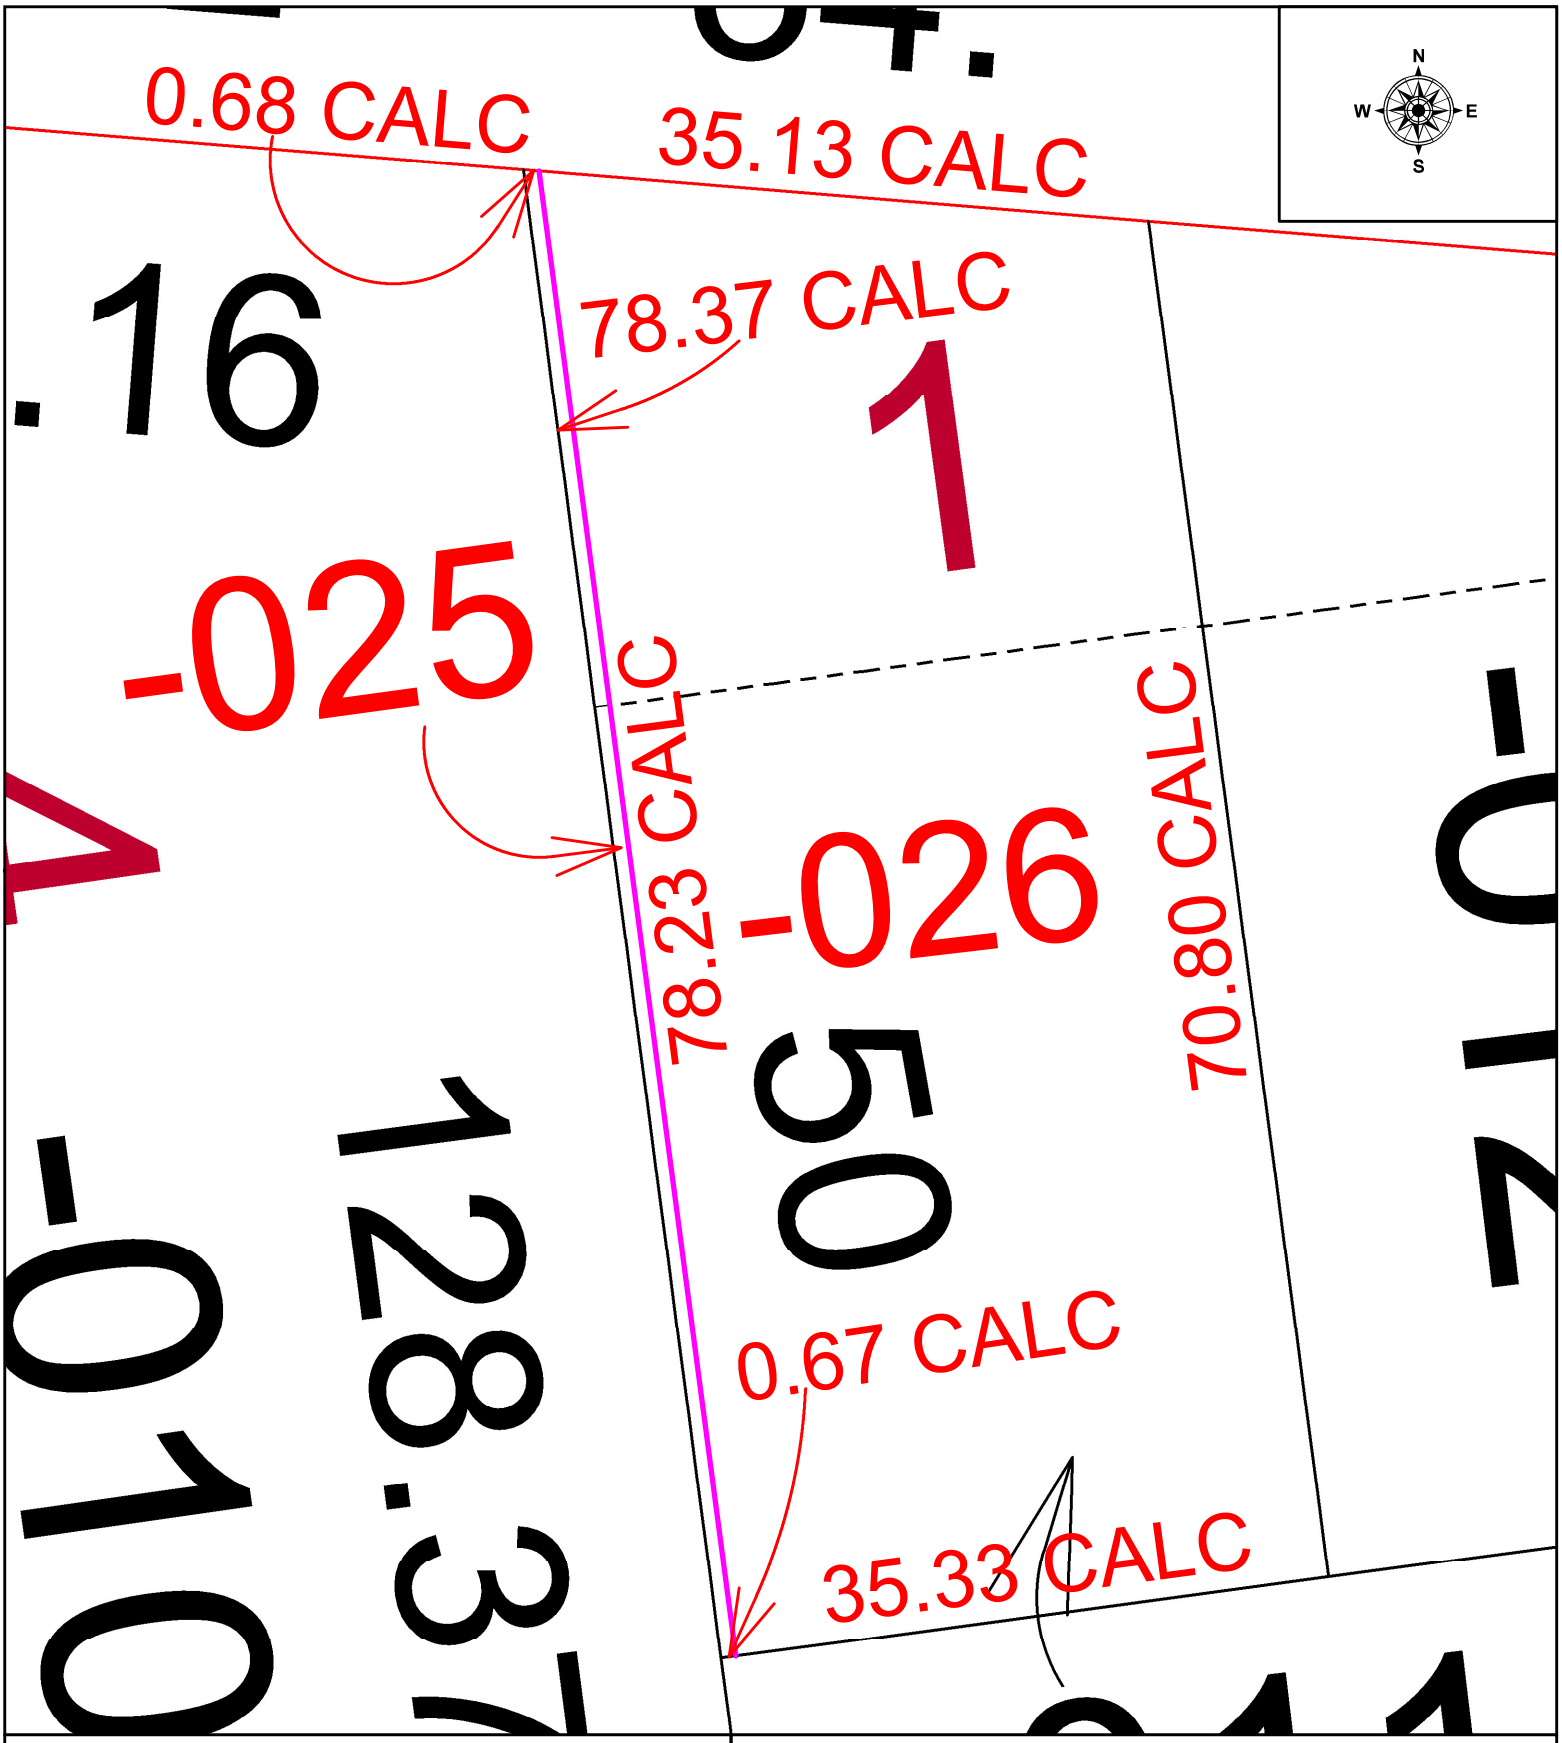

SPLITS/DEEDS PROCESSED

LORAIN COUNTY TAX MAP DEPARTMENT
226 MIDDLE AVE. ELYRIA, OH

SURVEYED BY: N/A
CLOSURE: N/A
MAP PAGE(S): 02-01-003
APPOVED BY: WRZ **DATE:** 4/21/2022
SCALE: 1" = 10 **PRIOR INSTRUMENT:** DV961, PG 215 & DV945, PG 792