PARENT PARCEL: 11-00-024-000-075, -076, 11-00-025-000-036

CHILD PARCEL: 11-00-024-000-091 & ST:11-00-025-000-036

STARTING POINT: AC CORR PER SURV BY MICHAEL A. ACKERMAN

24-04845

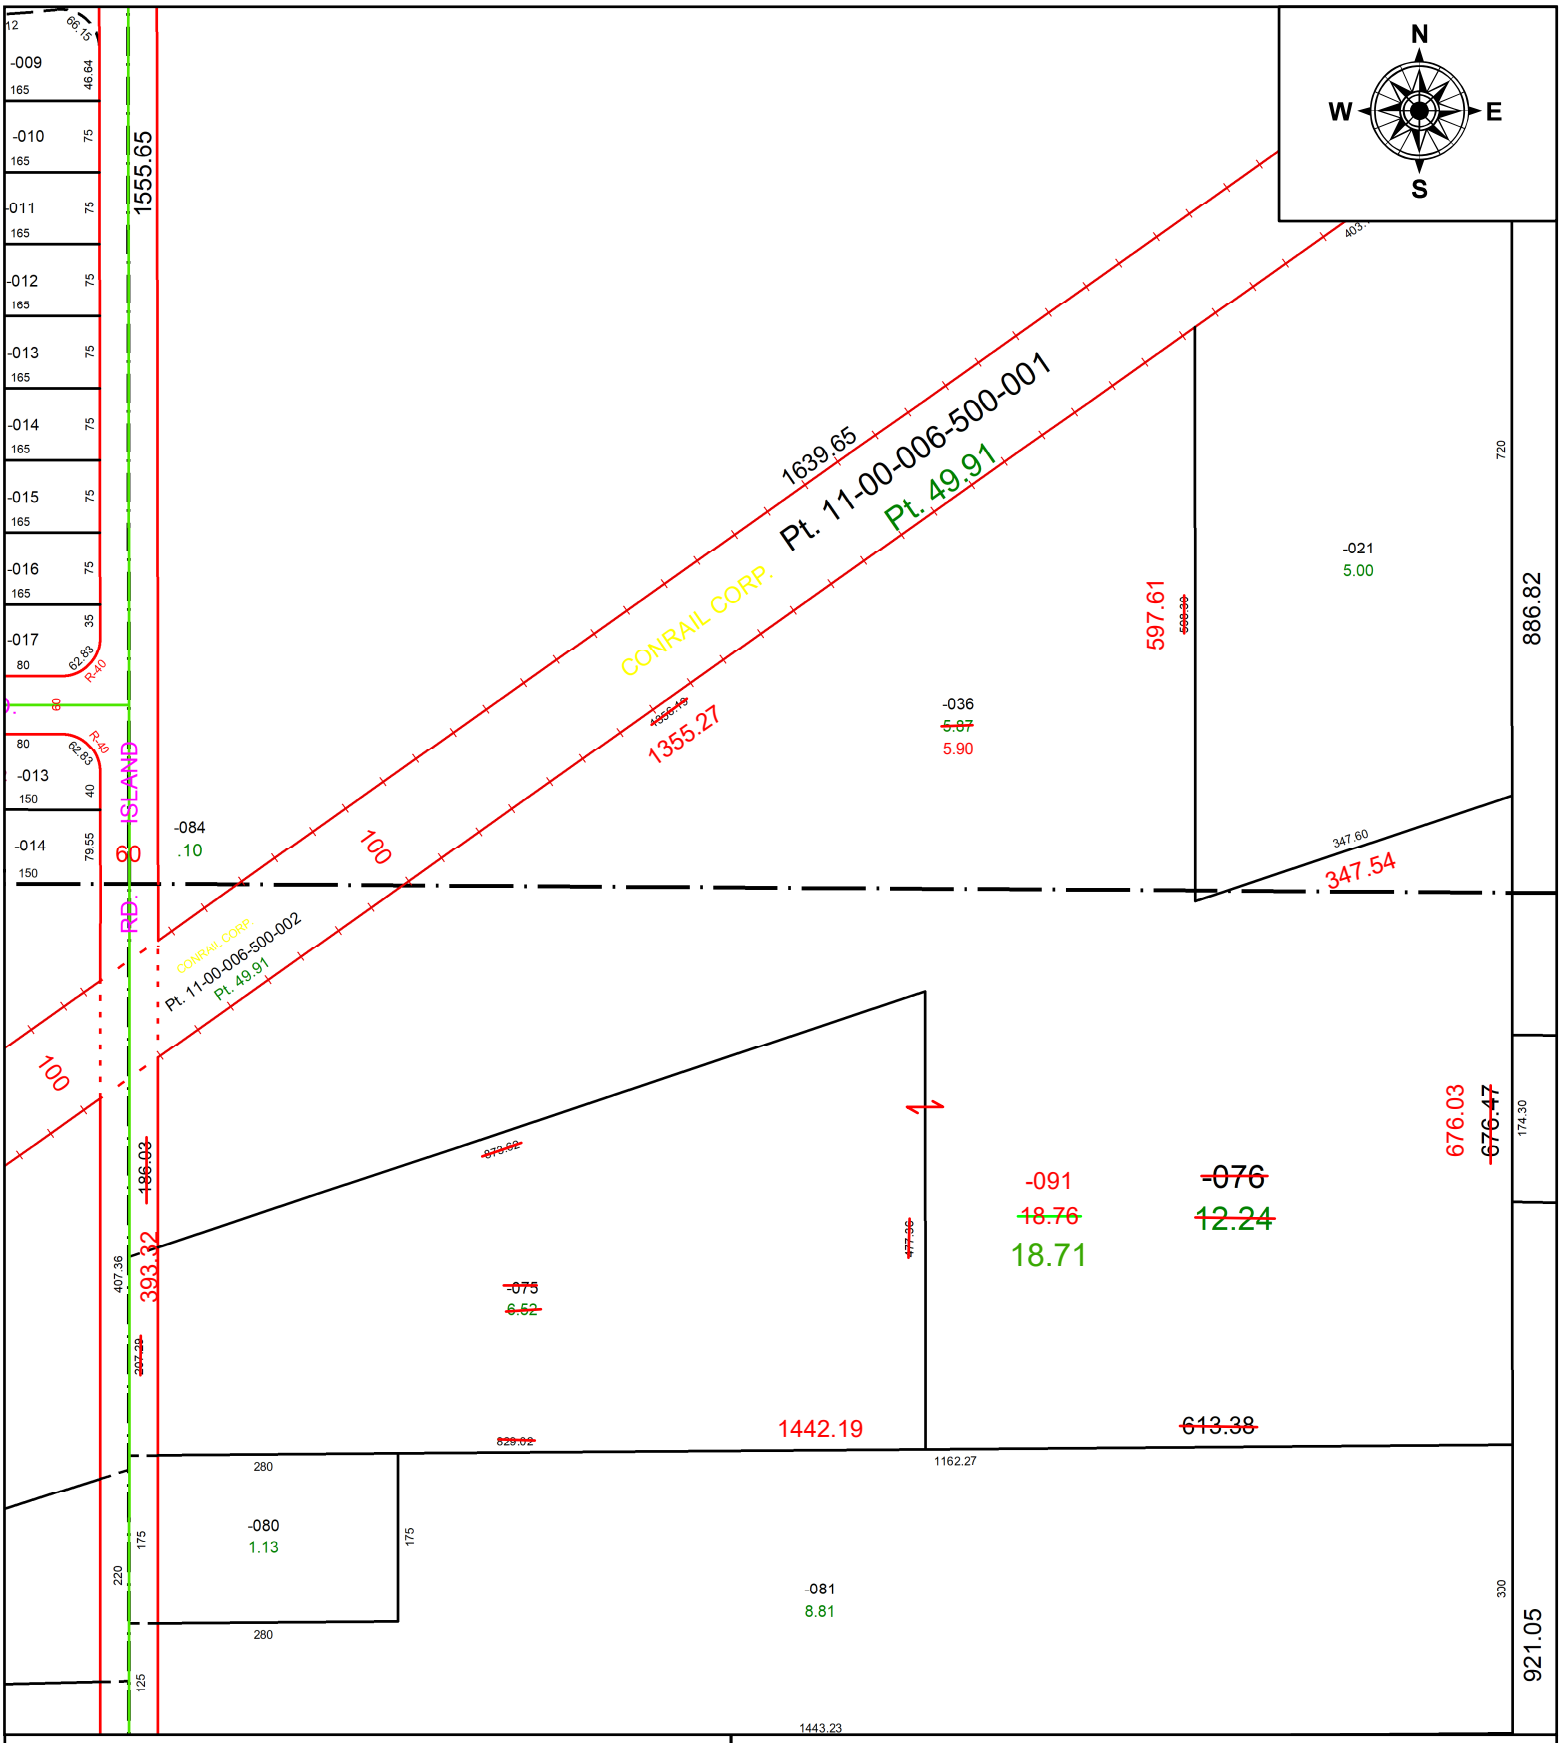

SPLITS/DEEDS PROCESSED

LORAIN COUNTY TAX MAP DEPARTMENT
226 MIDDLE AVE. ELYRIA, OH

SURVEYED BY: MICHAEL A. ACKERMAN **SURV # 51160**

CLOSURE: 1: 1161098

MAP PAGE(S): 11-00-024

APPOVED BY: AC **DATE:** April 11, 2024

SCALE: 1 in = 200 ft **PRIOR INSTRUMENT:** 2018- 0682939