PARENT PARCEL: 01-00-044-000-063 & -064

CHILD PARCEL: 01-00-044-000-066

STARTING POINT: MAG NAIL @ INTERSECTION OF C/LS OF NORTH RIDGE RD & CLAUS RD

24-04847

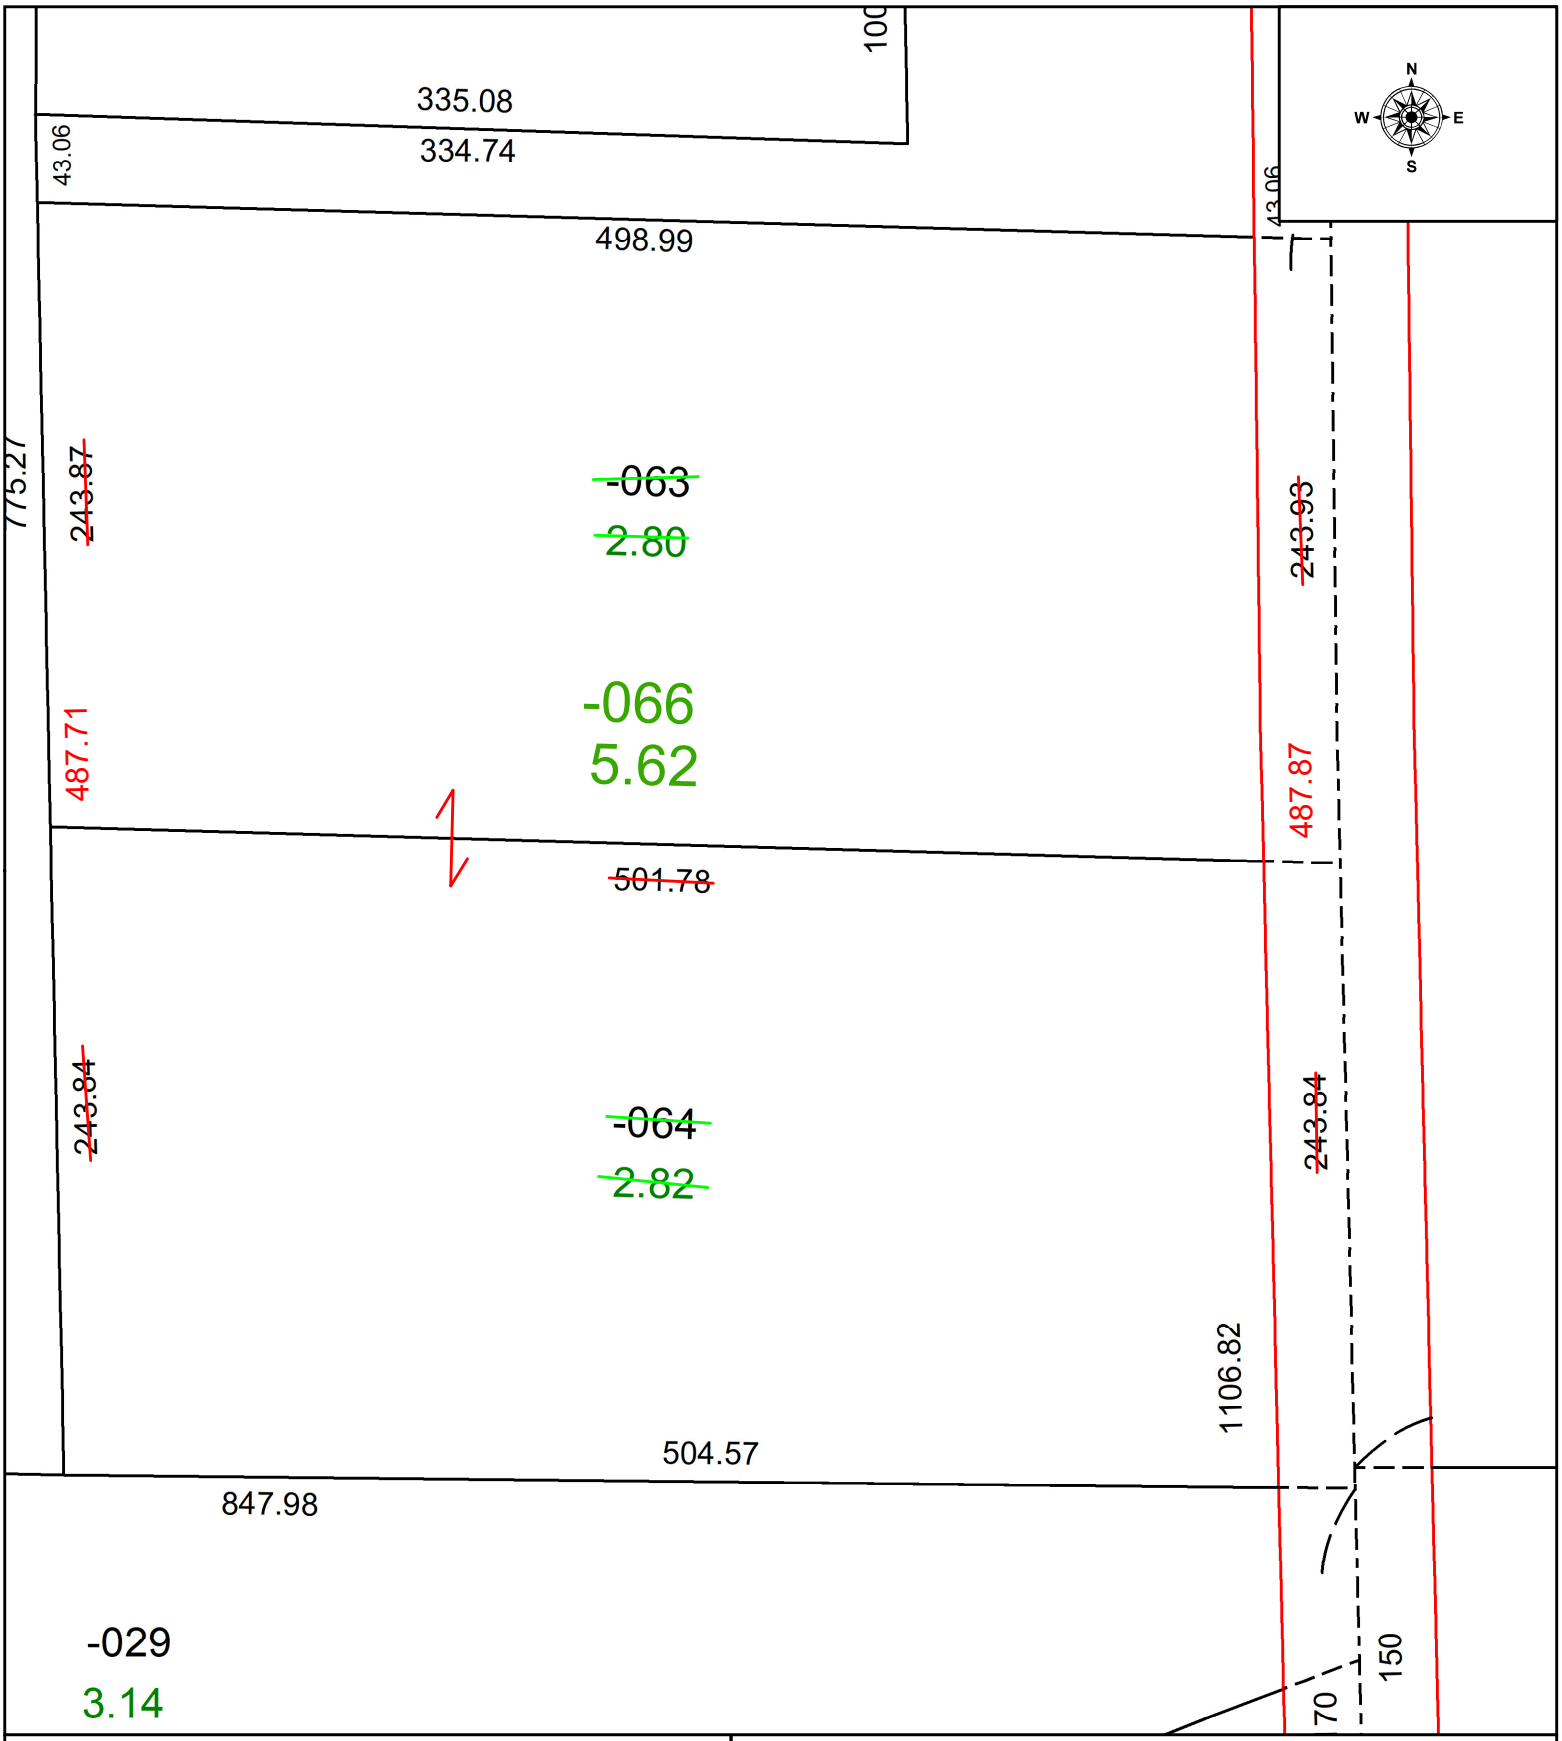

SPLITS/DEEDS PROCESSED

LORAIN COUNTY TAX MAP DEPARTMENT
226 MIDDLE AVE. ELYRIA, OH

SURVEYED BY: THOMAS SIMON SURVEY # 51170

CLOSURE: 1: 272113

MAP PAGE(S): 01-00-044

APPOVED BY: WRZ **DATE:** 4/23/2024

SCALE: 1" = 75 **PRIOR INSTRUMENT:** #2024-0008751