PARENT PARCEL: 06-24-025-105-017

CHILD PARCEL: FRONT & DEPTH TO AC CORR PER SURV BY SCOTT J. CASEY

STARTING POINT: SE CORNER OF OAKWOOD PARK SUBDIVISION

22-04849-C

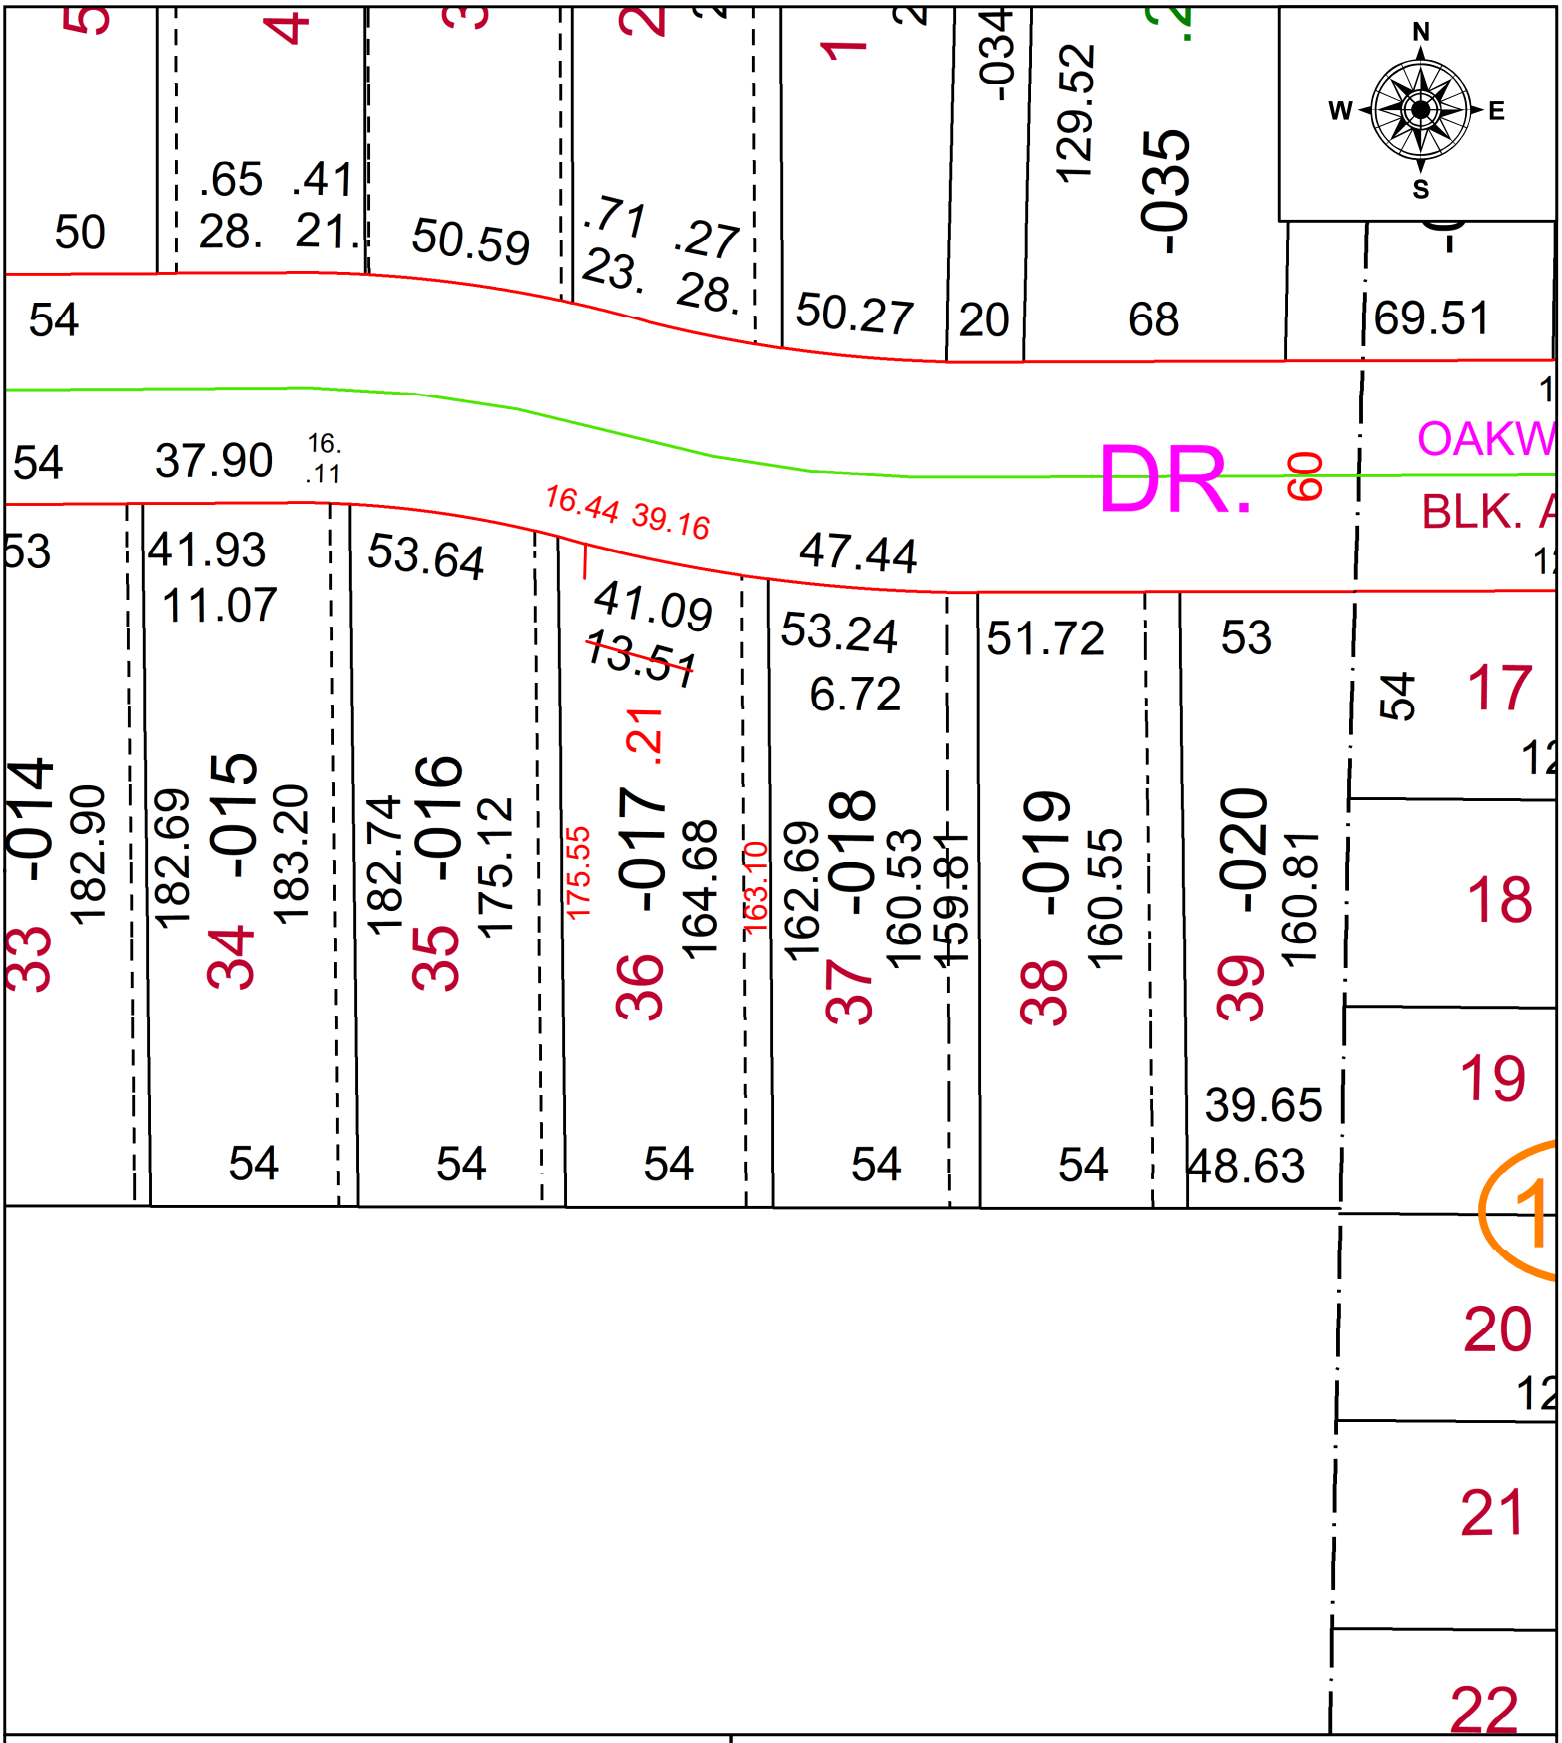

SPLITS/DEEDS PROCESSED

LORAIN COUNTY TAX MAP DEPARTMENT
226 MIDDLE AVE. ELYRIA, OH

SURVEYED BY: SCOTT J. CASEY
CLOSURE: 1: 50746
MAP PAGE(S): 06-24-025
APPOVED BY: AC **DATE:** 4/29/2022
SCALE: 1" = 50 **PRIOR INSTRUMENT:** 2013- 0470183