PARENT PARCEL: 06-24-035-102-072 & -073

CHILD PARCEL: 06-24-035-102-076, -077, & -078

STARTING POINT: INTERSECTION OF NORTH LINE OF SR 113 & C/L OF CLEMENS AVE

24-04850

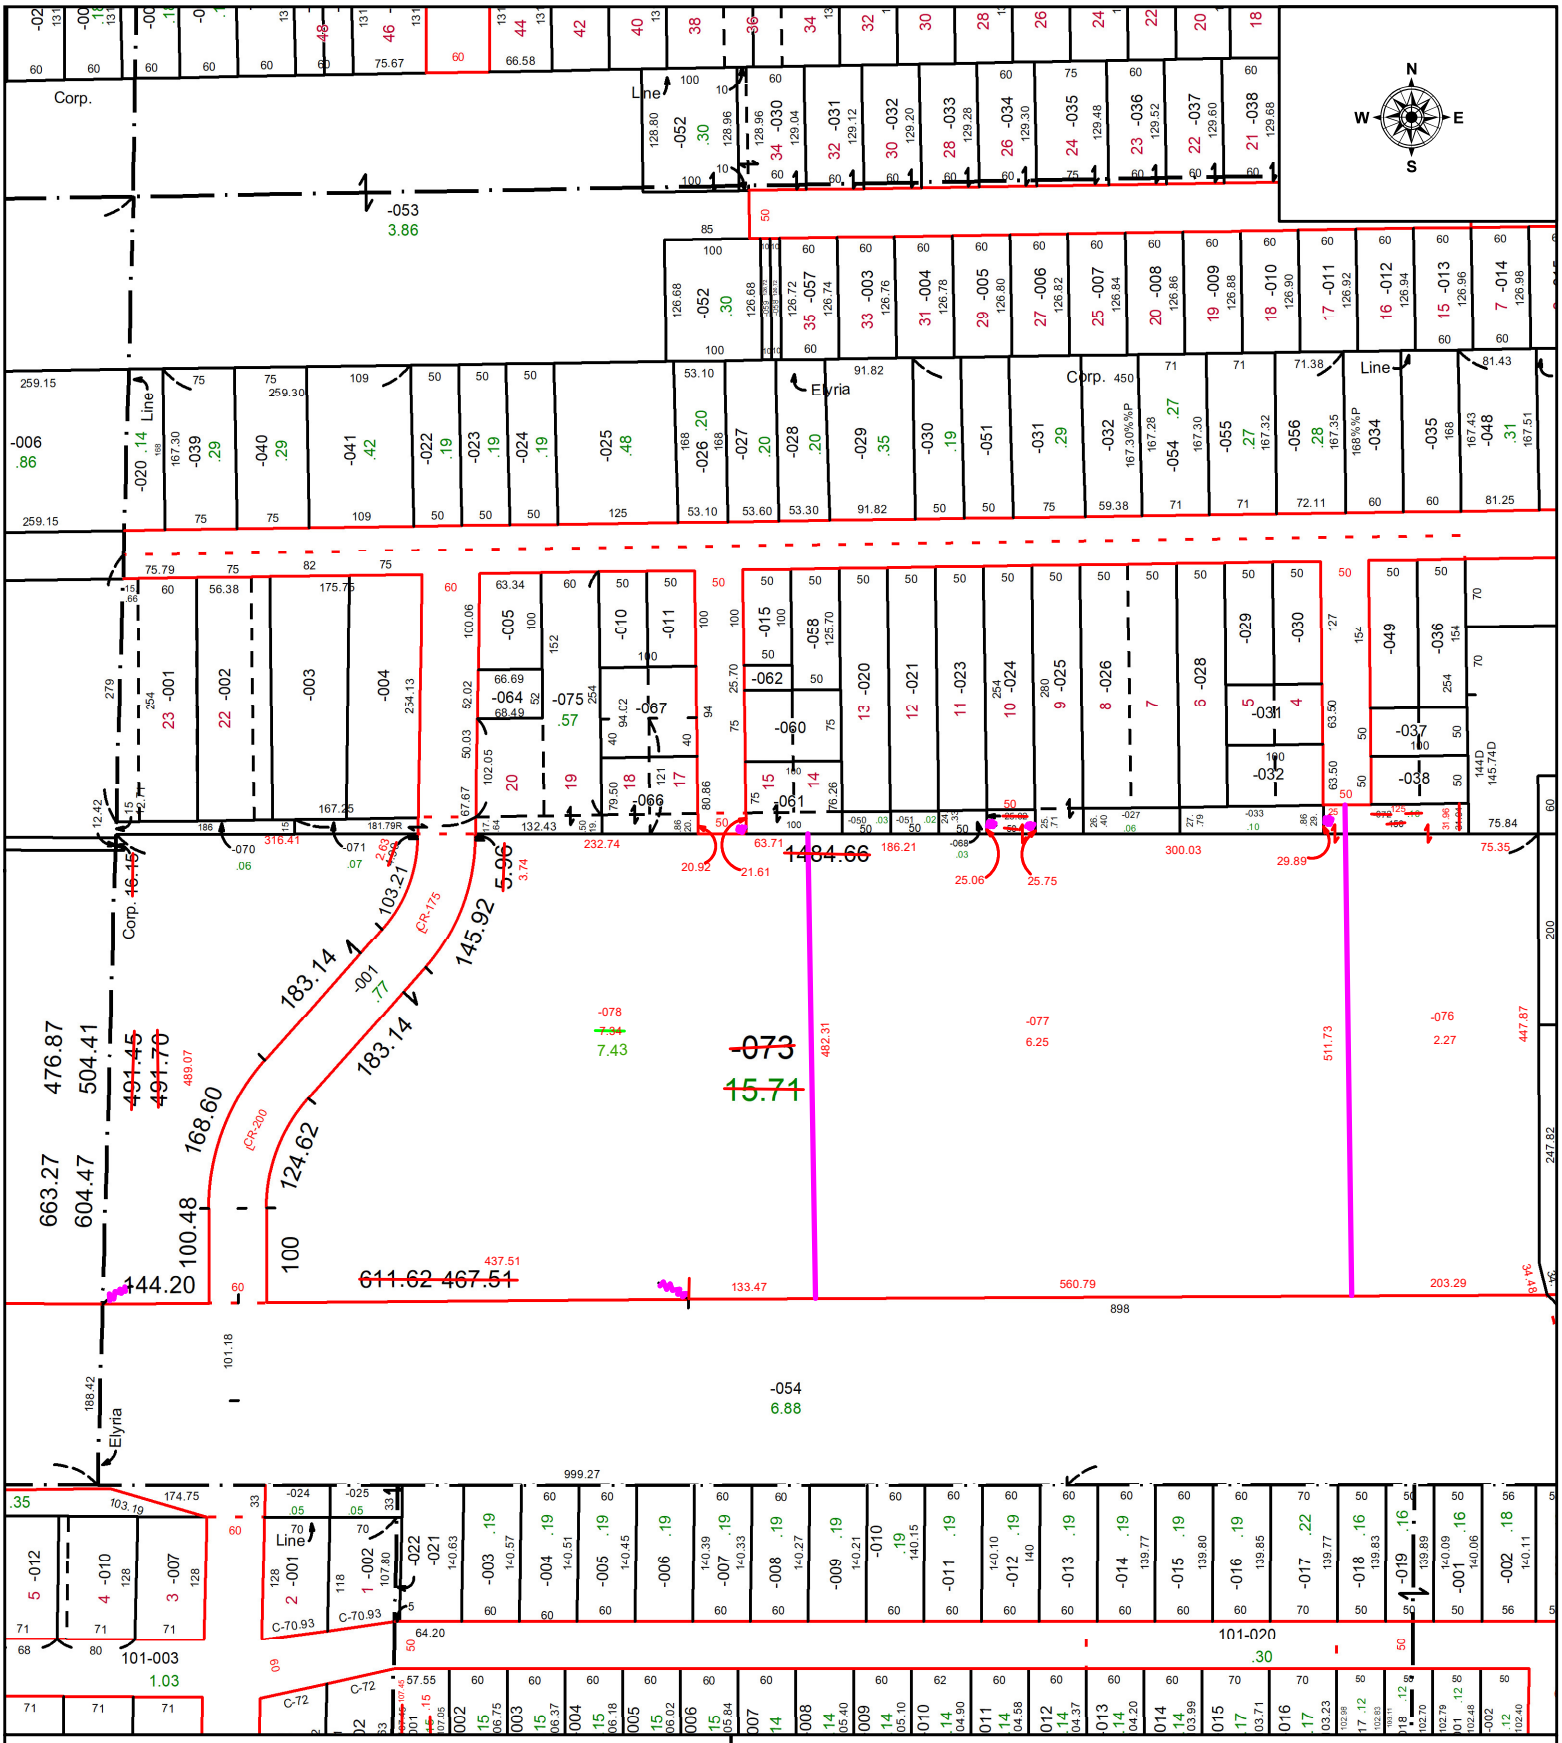

SPLITS/DEEDS PROCESSED

LORAIN COUNTY TAX MAP DEPARTMENT
226 MIDDLE AVE. ELYRIA, OH

SURVEYED BY: WILFREDO BARBOSA SURVEY # 51189

CLOSURE: 1: 129046

MAP PAGE(S): 06-24-035

APPOVED BY: WRZ **DATE:** 5/16/2024

SCALE: 1" = 200 **PRIOR INSTRUMENT:** ORV 148 PG 803