PARENT PARCEL: 07-00-043-101-025

CHILD PARCEL: 07-00-043-101-029 & -030

STARTING POINT: SE CORNER OF O/L 43 **AC CORR PER SURV BY JOSHUA MATEJIN**

24-04853

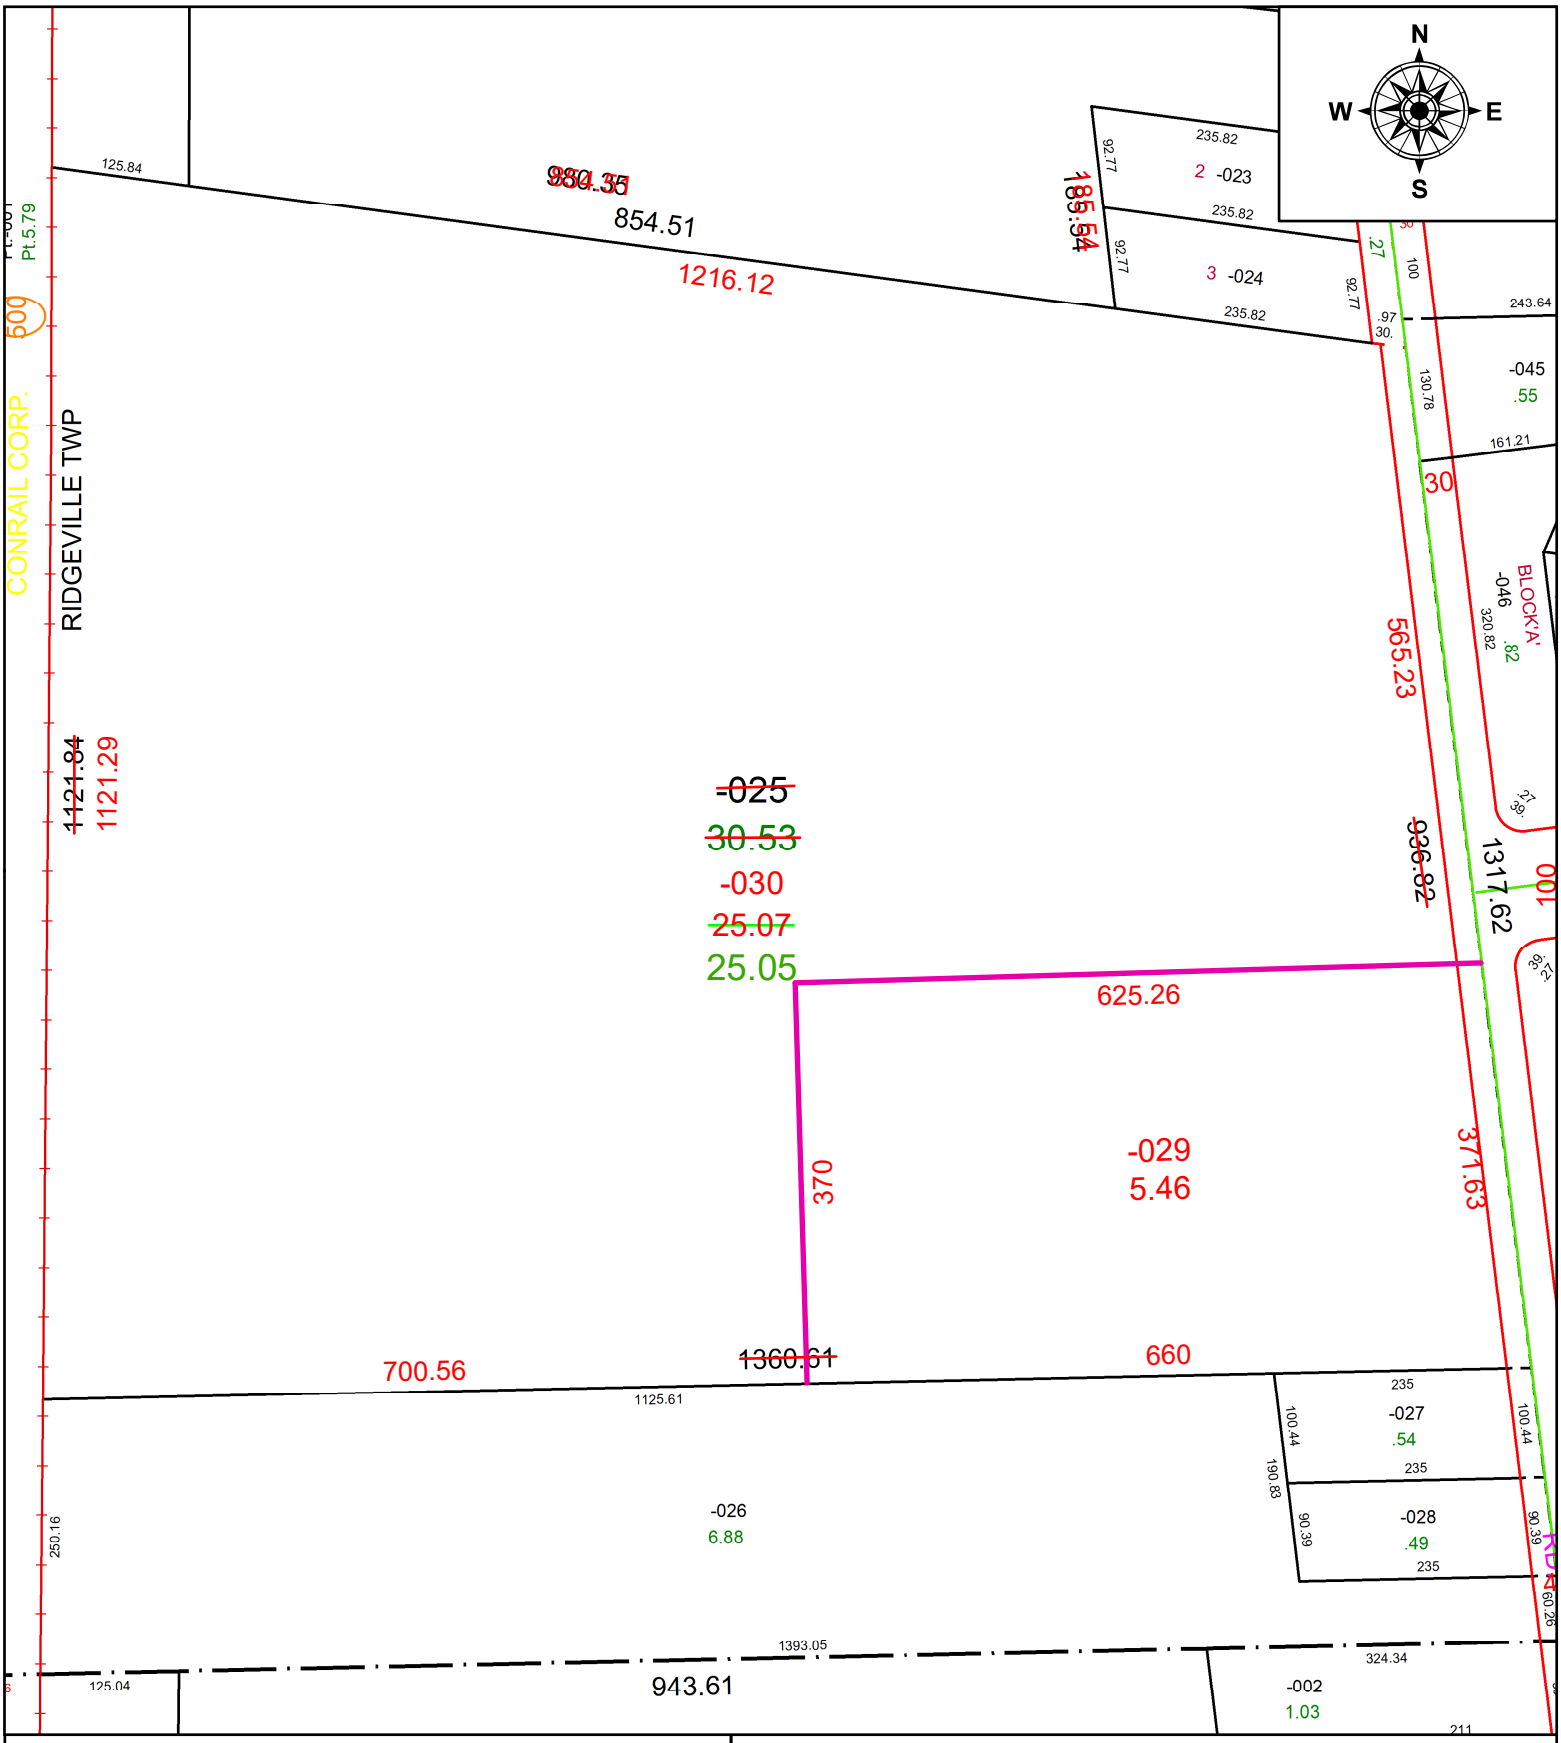

SPLITS/DEEDS PROCESSED

LORAIN COUNTY TAX MAP DEPARTMENT
226 MIDDLE AVE. ELYRIA, OH

SURVEYED BY: JOSHUA MATEJIN **SURV # 51175**

CLOSURE: 1: 757246

MAP PAGE(S): 07-00-043

APPOVED BY: AC **DATE:** May 03, 2024

SCALE: 1 in = 175 ft **PRIOR INSTRUMENT:** 2022- 0876440