PARENT PARCEL: 09-00-053-000-015

CHILD PARCEL: 09-00-053-000-037 & -038 AC CORR PER SURVEYOR TIMOTHY HOZALSKI

STARTING POINT: RAILROAD SPIKE @ NORTHEAST CORNER OF O.L. 53 & C/L OF PYLE-SOUTH AMHERST RD

24-04855

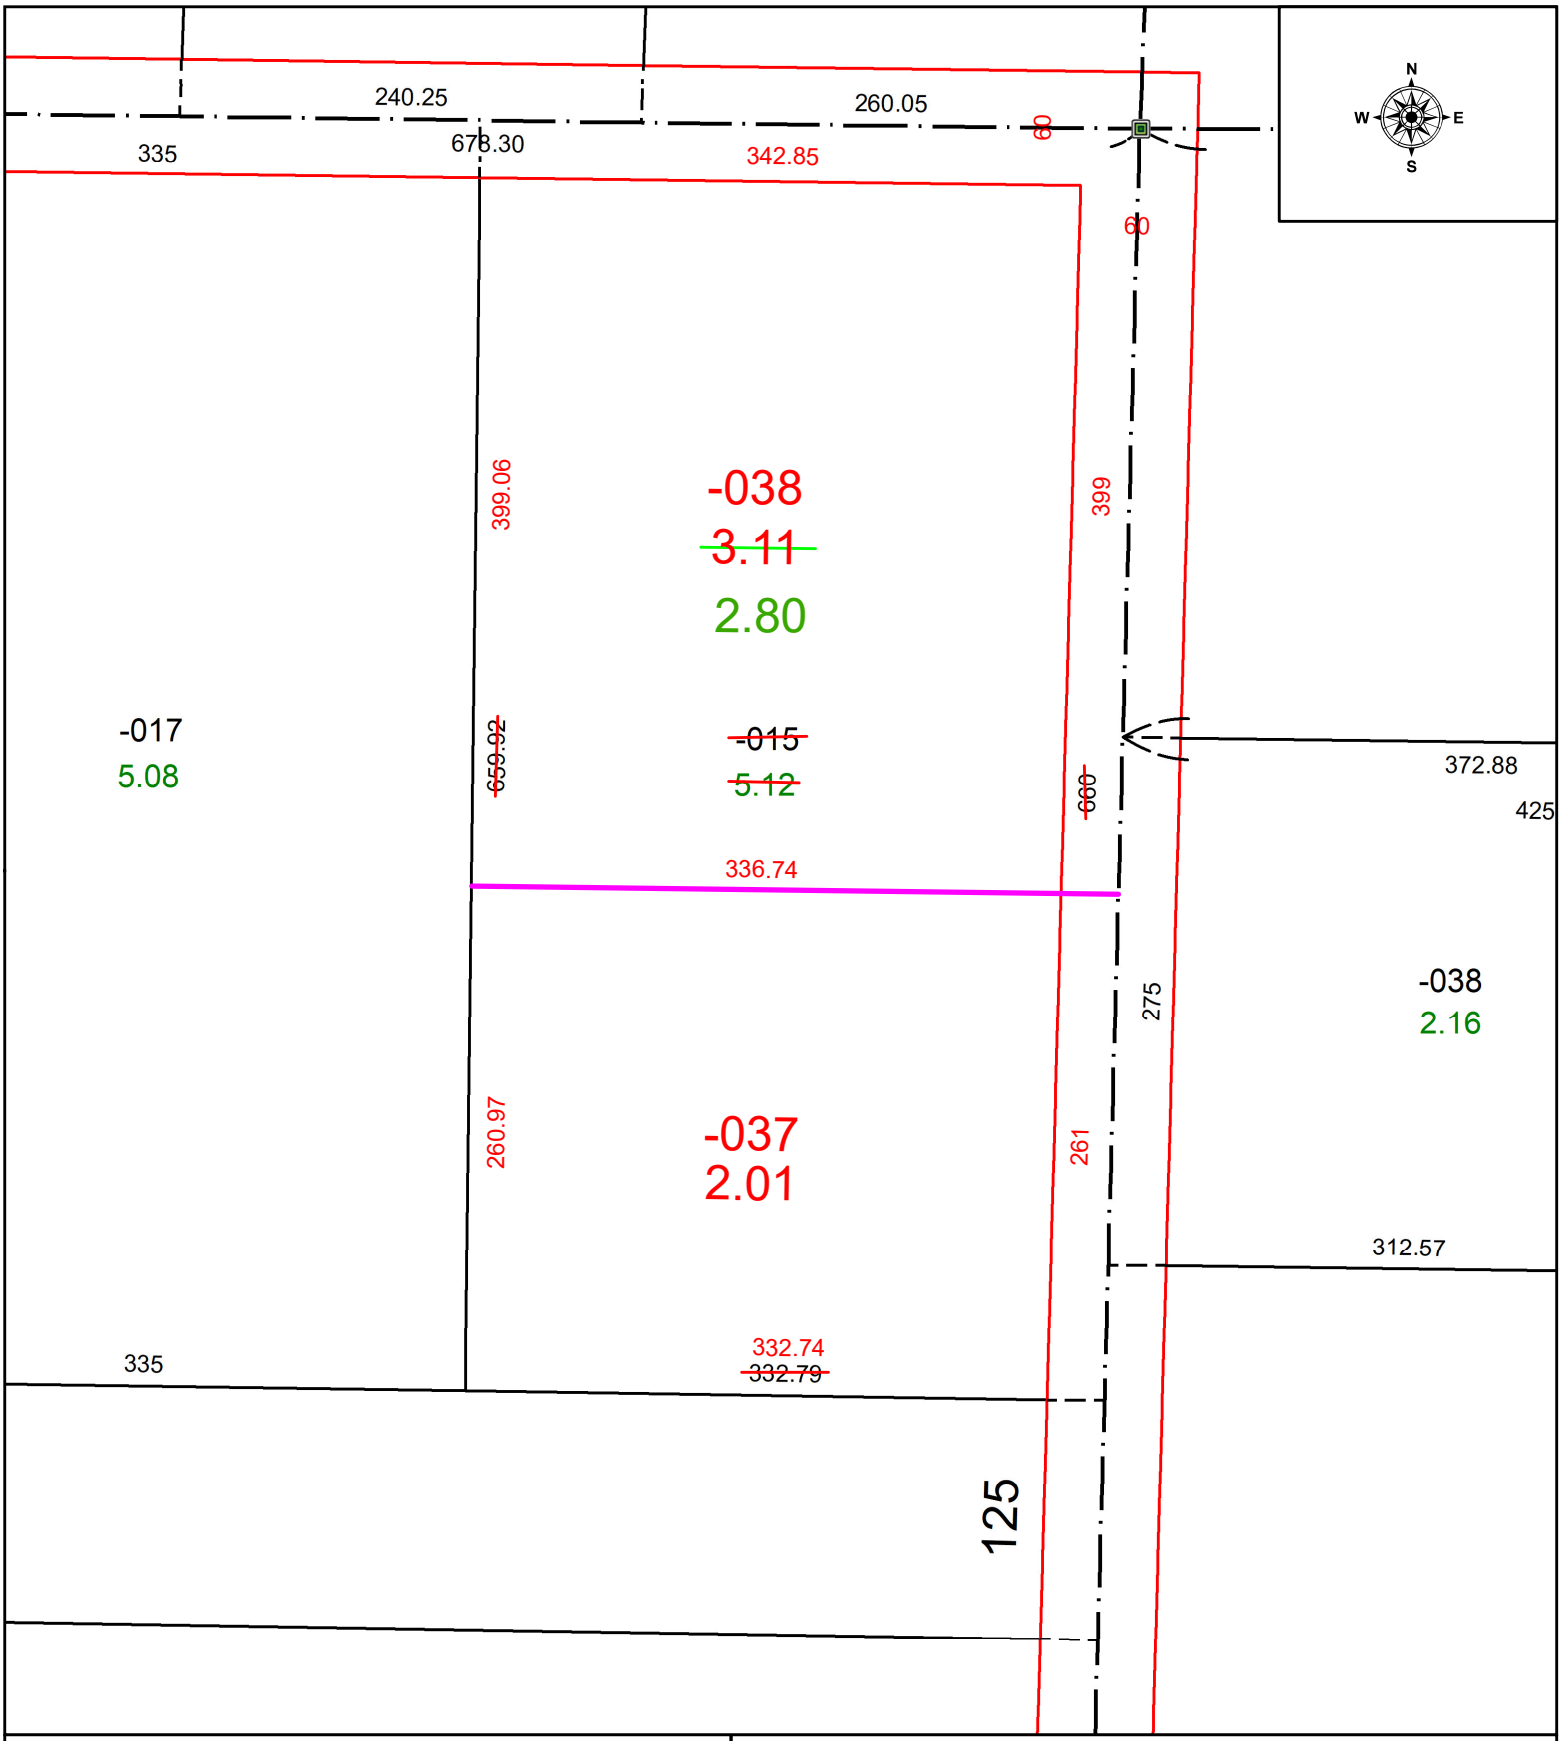

SPLITS/DEEDS PROCESSED

LORAIN COUNTY TAX MAP DEPARTMENT
226 MIDDLE AVE. ELYRIA, OH

SURVEYED BY: TIMOTHY HOZALSKI SURVEY # 51181

CLOSURE: 1: 224004

MAP PAGE(S): 09-00-053

APPOVED BY: WRZ **DATE:** 5/9/2024

SCALE: 1" = 100 **PRIOR INSTRUMENT:** #1998-0541560