PARENT PARCEL: 15-00-029-000-015 & -016
CHILD PARCEL: 15-00-029-000-033 THRU -035
STARTING POINT: IRON PIN IN MONUMENT BOX @ C/LS OF BRIGGS RD & INDIAN HOLLOW RD

24-04856

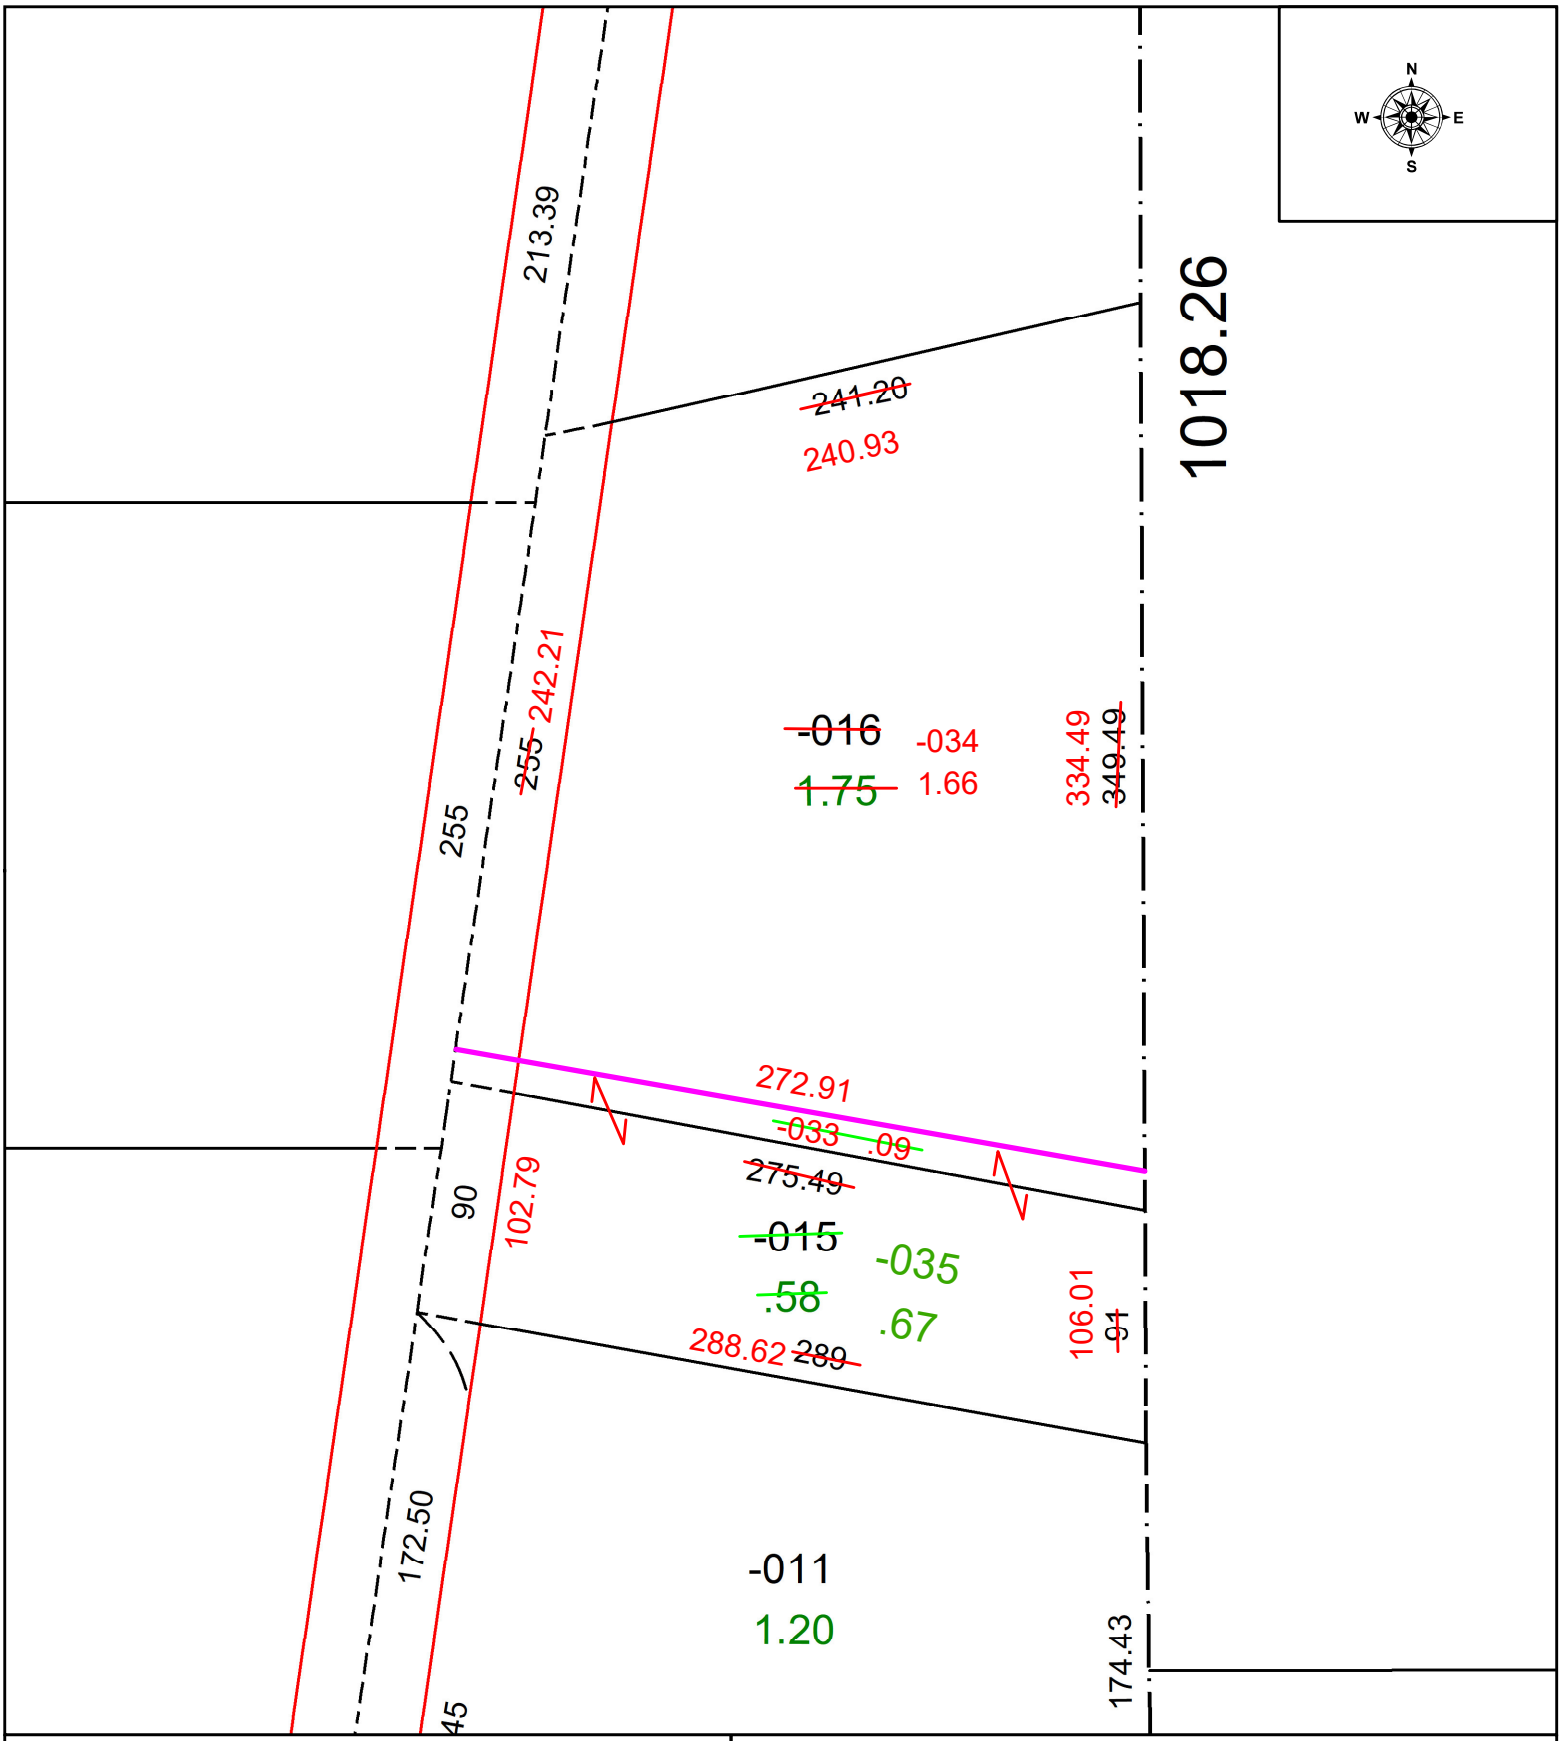

SPLITS/DEEDS PROCESSED
LORAIN COUNTY TAX MAP DEPARTMENT
226 MIDDLE AVE. ELYRIA, OH

SURVEYED BY: THOMAS SIMON SURVEY # 51188
CLOSURE: 1: 68766
MAP PAGE(S): 15-00-029
APPOVED BY: WRZ **DATE:** 5/16/2024
SCALE: 1" = 75 **PRIOR INSTRUMENT:** #1999-0654197