PARENT PARCEL: 21-10-000-000-026 & -052
CHILD PARCEL: 21-10-000-000-054, -055, & -056
STARTING POINT: INTERSECTION OF C/LS OF STEWART RD & SR 58

24-04857

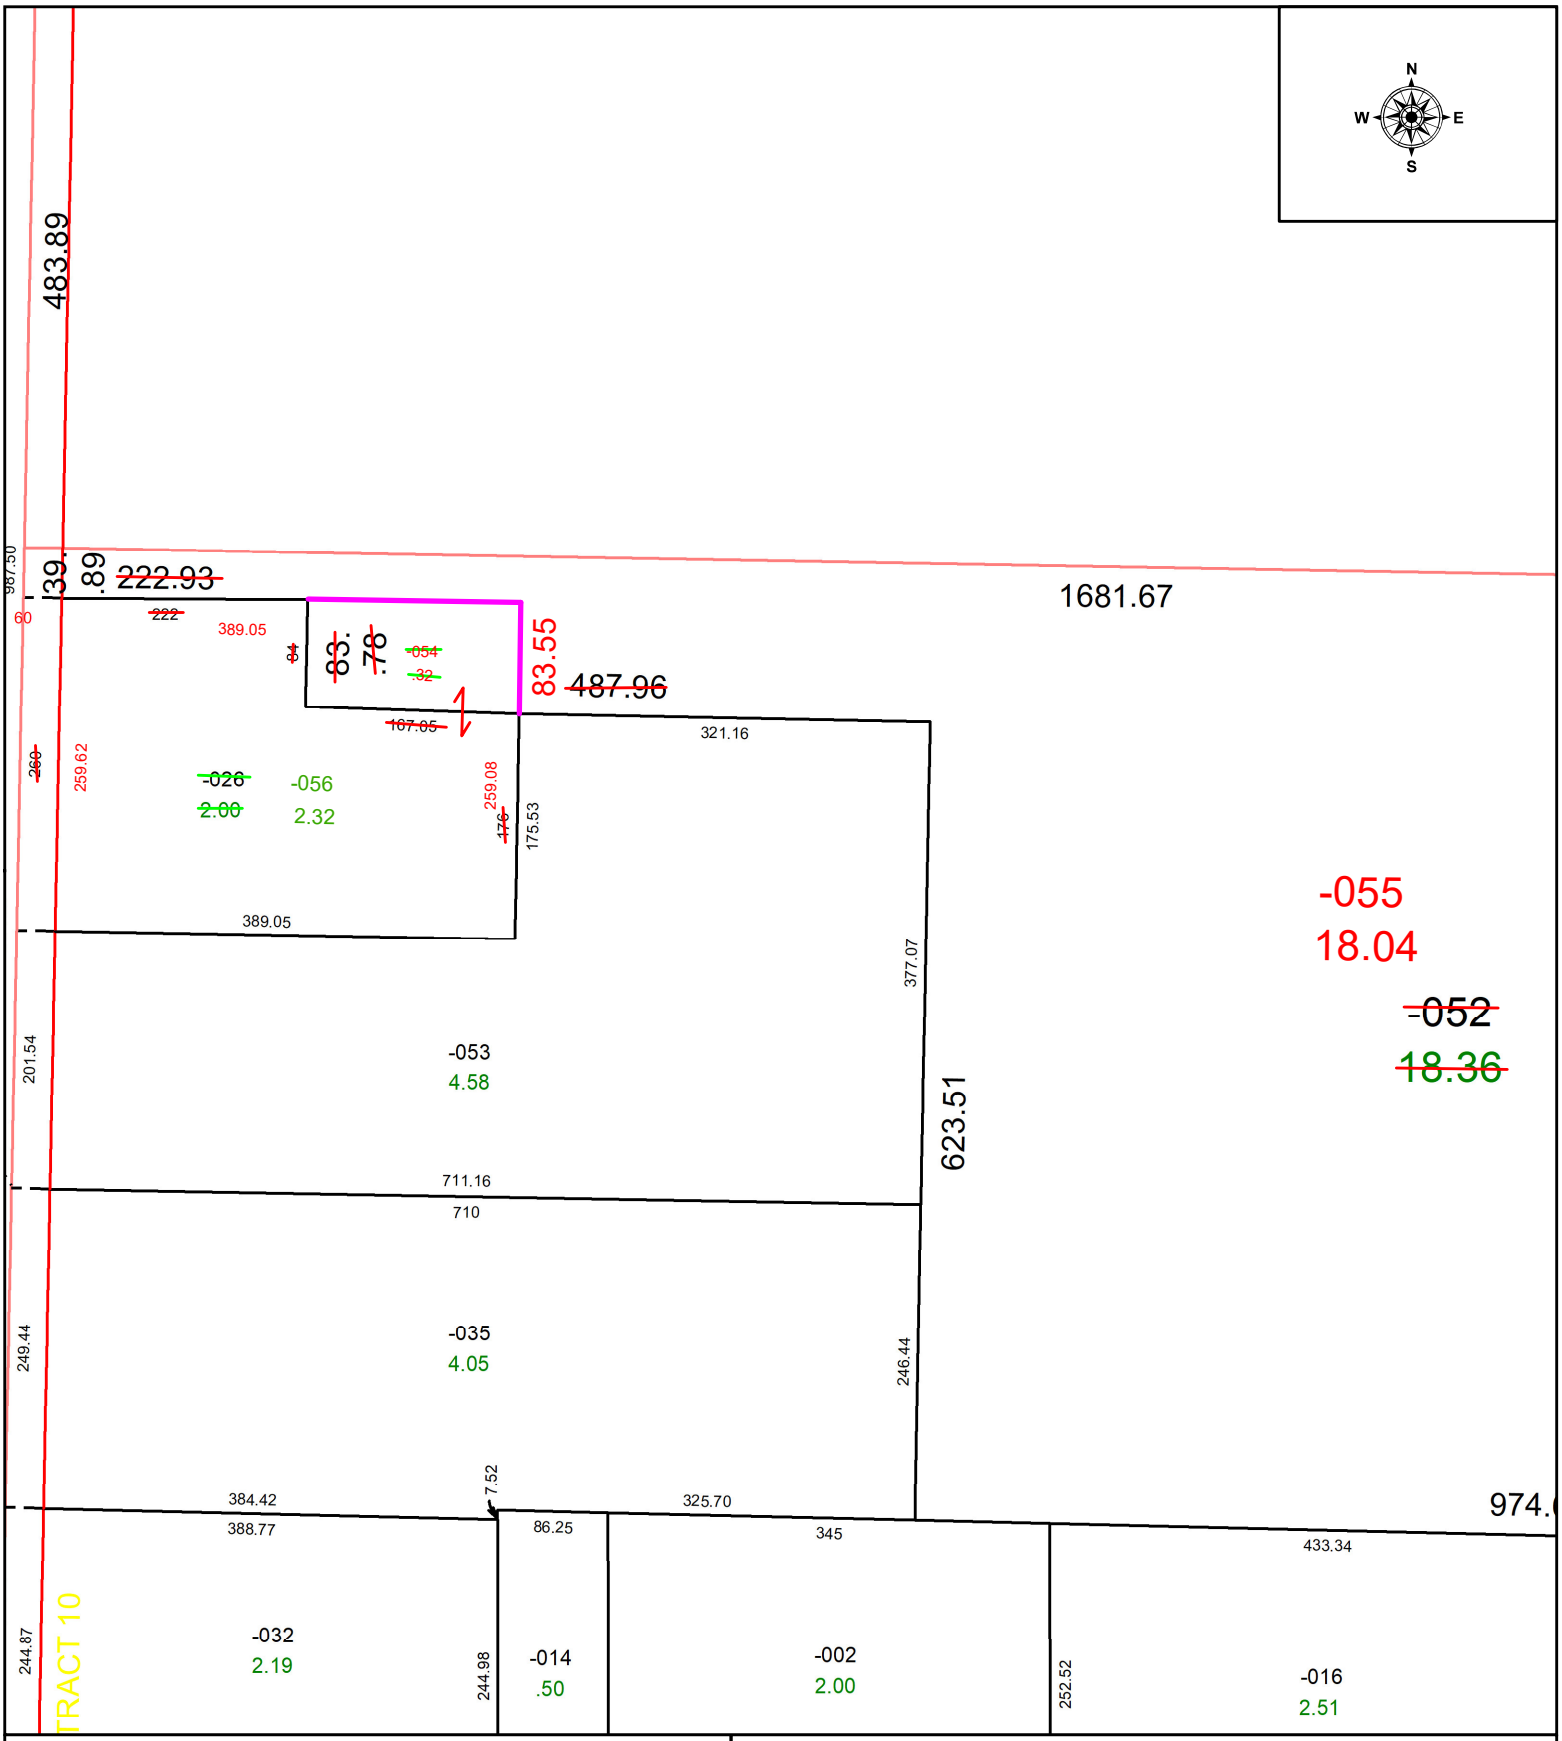

SPLITS/DEEDS PROCESSED
LORAIN COUNTY TAX MAP DEPARTMENT
226 MIDDLE AVE. ELYRIA, OH

SURVEYED BY: THOMAS SIMON SURVEY # 51191
CLOSURE: 1: 82501
MAP PAGE(S): 21-10-000
APPOVED BY: WRZ **DATE:** 5/21/2024
SCALE: 1" = 150 **PRIOR INSTRUMENT:** #2024-0008926