PARENT PARCEL: 01-00-002-108-006 & -007
CHILD PARCEL: 01-00-002-108-094
STARTING POINT: INTERSECTION OF C/LS OF EDGEWATER BLVD & FAIRFAX RD

24-04859

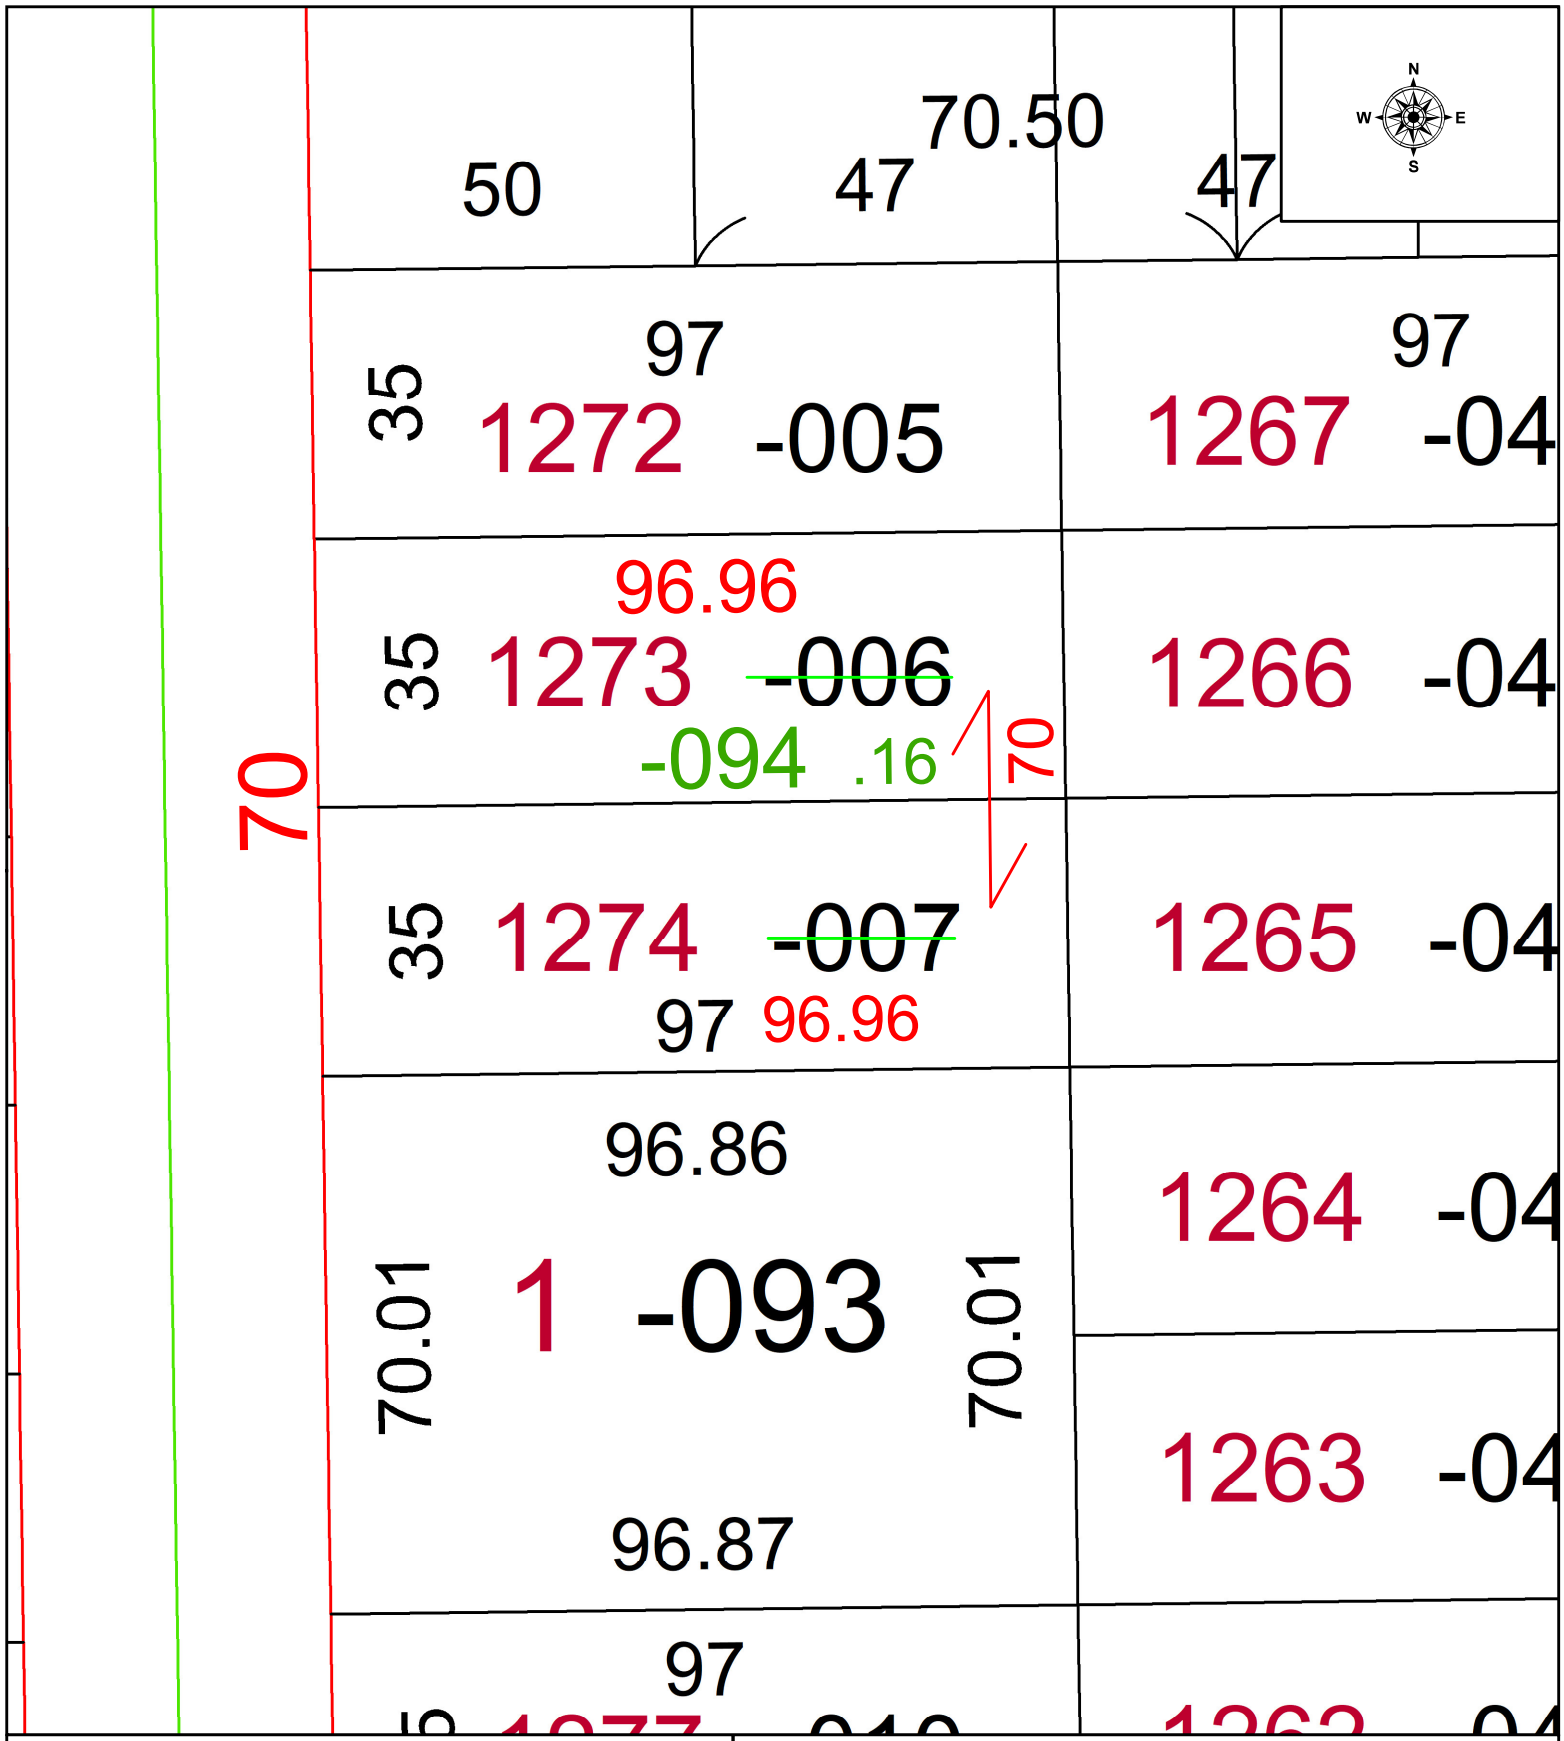

SPLITS/DEEDS PROCESSED
LORAIN COUNTY TAX MAP DEPARTMENT
226 MIDDLE AVE. ELYRIA, OH

SURVEYED BY: THEODORE SPILLMAN SURVEY # 51193
CLOSURE: 1: 163990
MAP PAGE(S): 01-00-002
APPOVED BY: WRZ **DATE:** 5/22/2024
SCALE: 1" = 25 **PRIOR INSTRUMENT:** #2023-0921535