PARENT PARCEL: ADD TO DUPLICATE - PER DV.1297/122

CHILD PARCEL: 04-00-017-103-396 0.01 A.

STARTING POINT: NA

22-04863-A

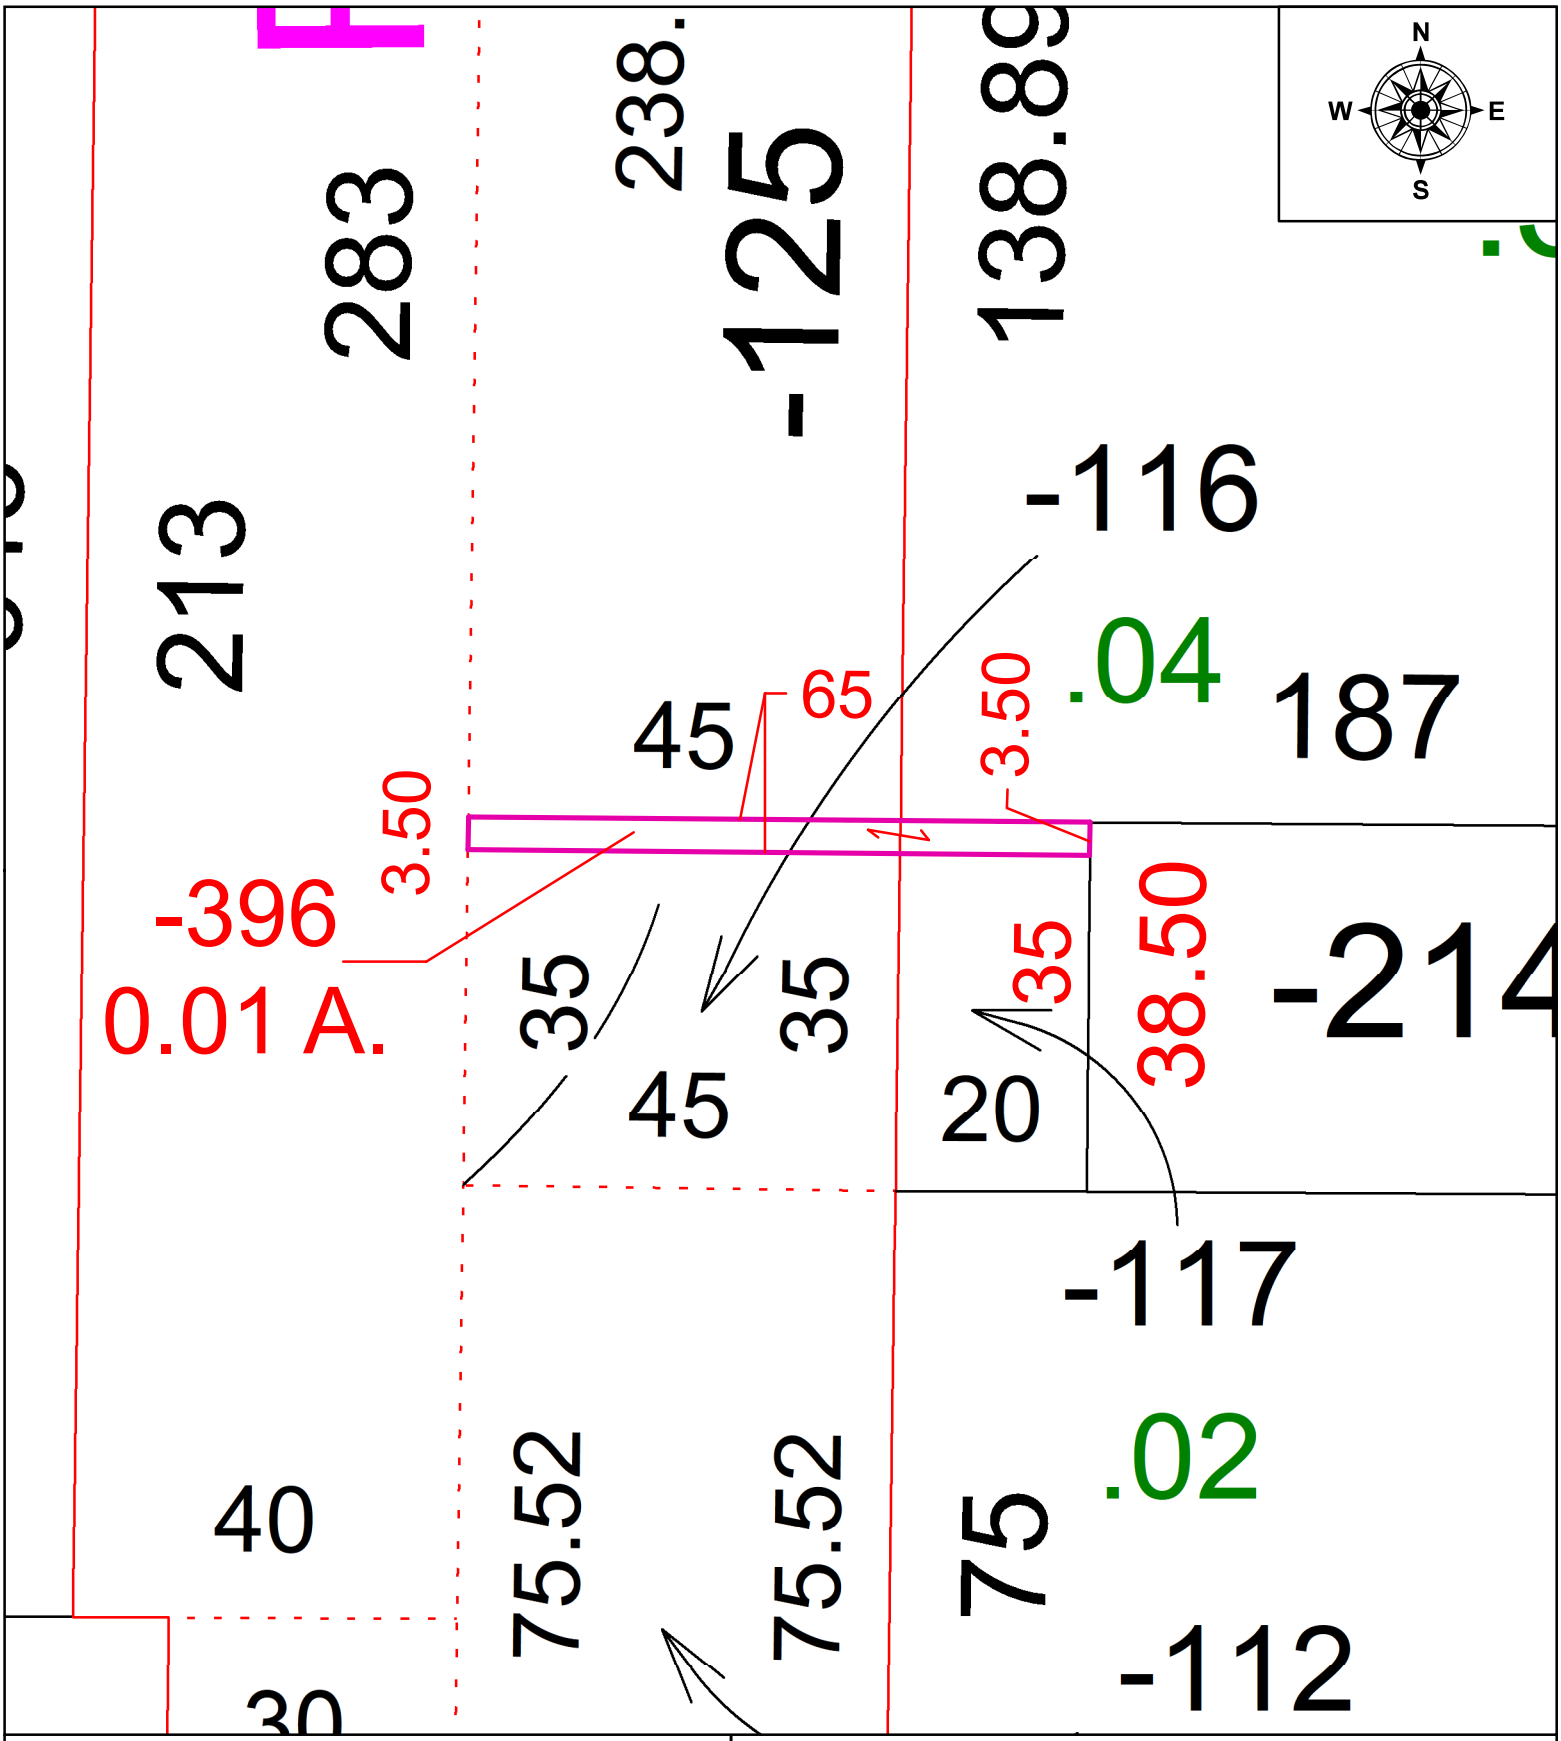

SPLITS/DEEDS PROCESSED

LORAIN COUNTY TAX MAP DEPARTMENT
226 MIDDLE AVE. ELYRIA, OH

SURVEYED BY: NA
CLOSURE: 1: 33,000
MAP PAGE(S): 4-00-017
APPOVED BY: TJS **DATE:** 5/18/2022
SCALE: 1" = 20' **PRIOR INSTRUMENT:** DV 1297/122