PARENT PARCEL: 04-00-023-102-024, -025, & -157

CHILD PARCEL: 04-00-023-102-159, -160, & -161

STARTING POINT: INTERSECTION OF C/LS OF SADDLE CREEK DR & JAYCOX RD

24-04863

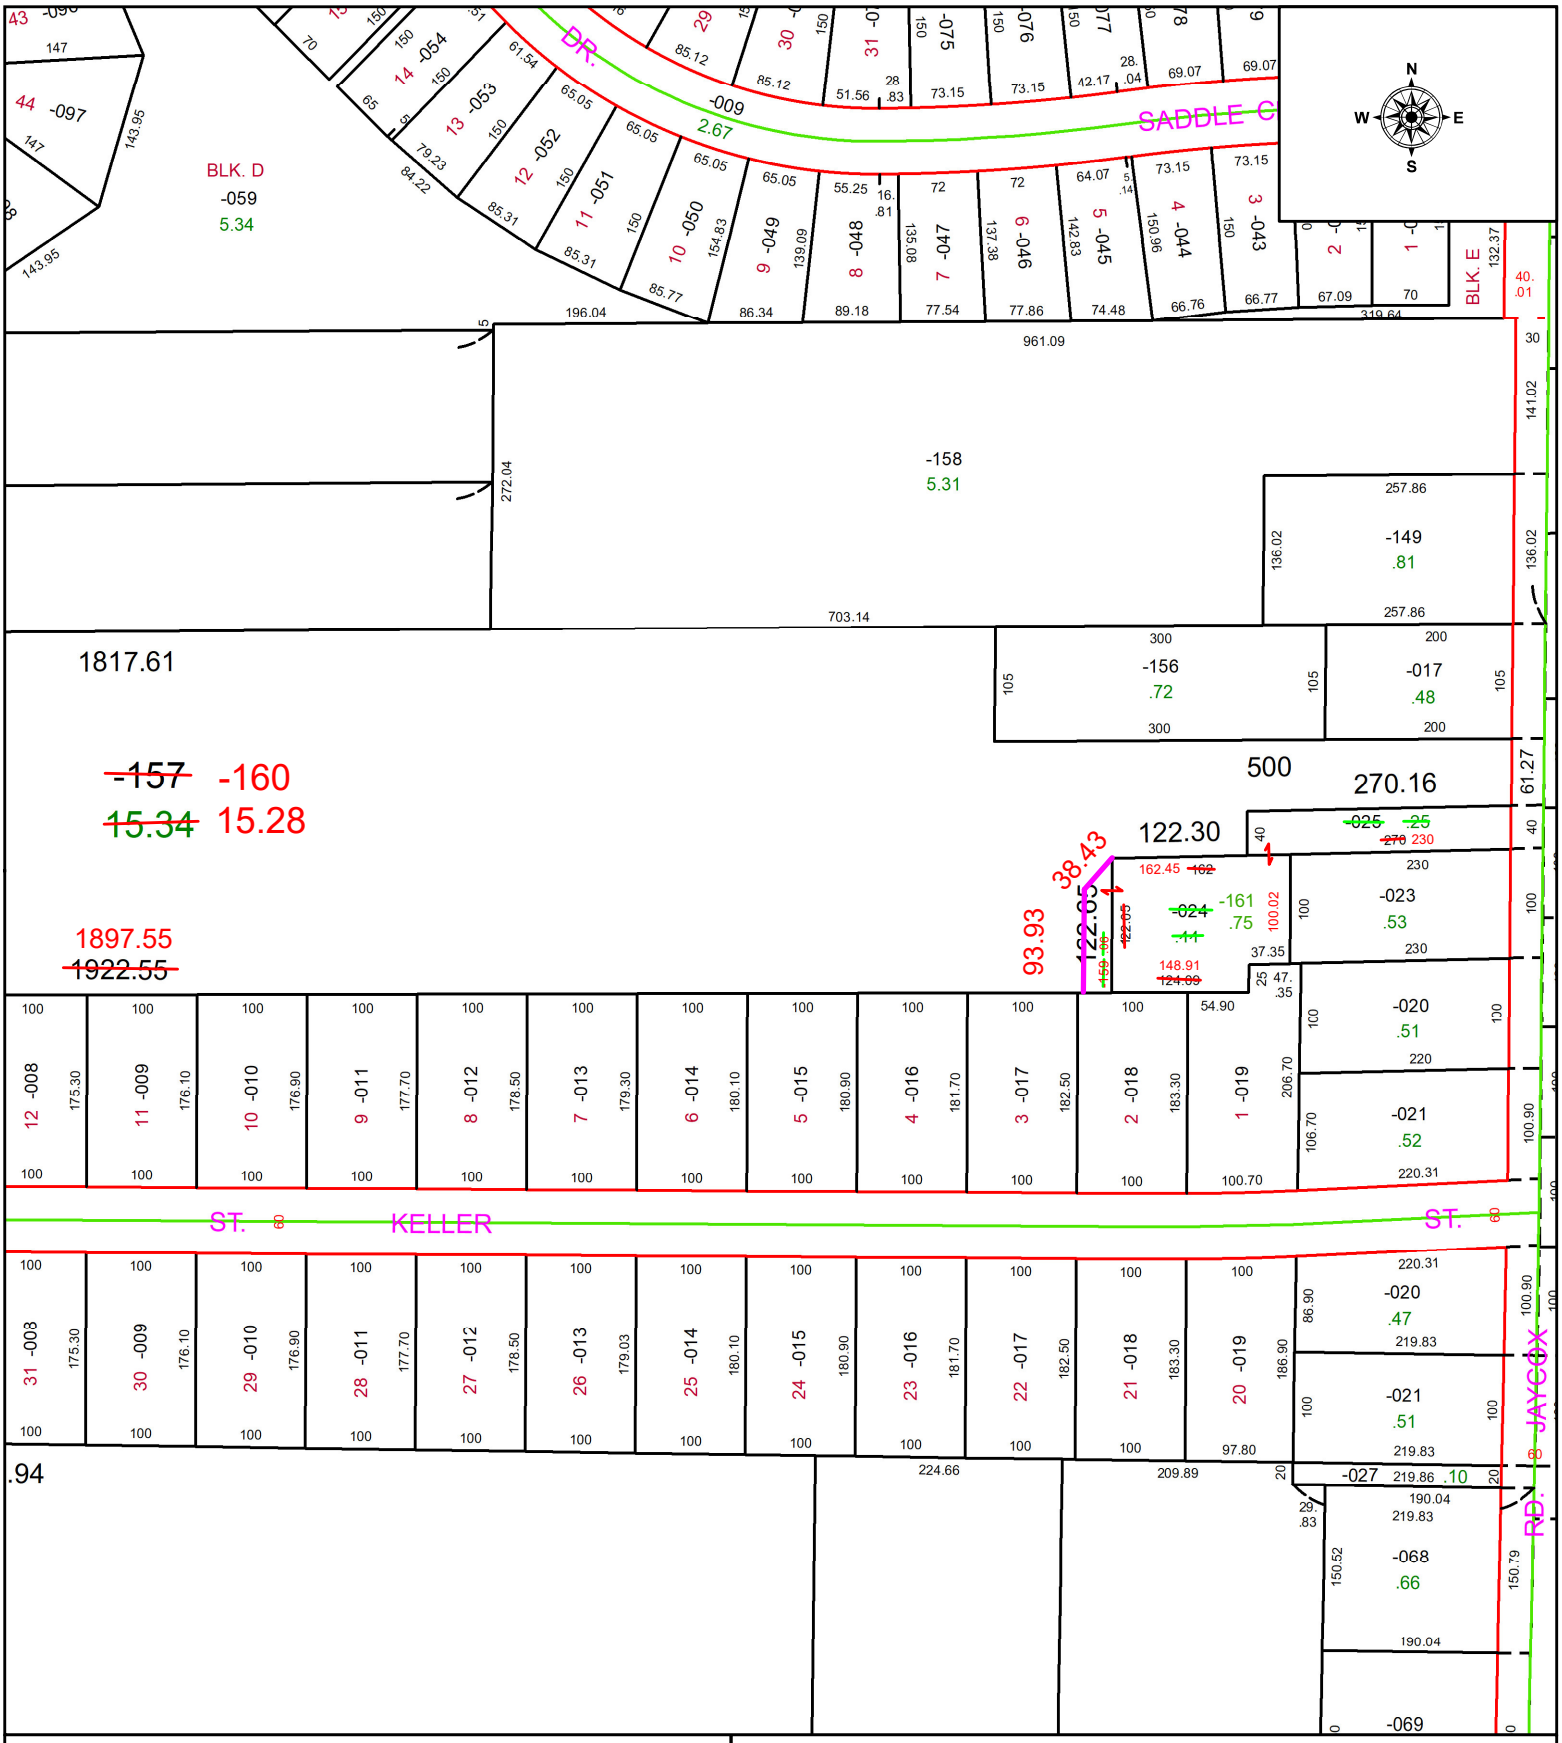

SPLITS/DEEDS PROCESSED

LORAIN COUNTY TAX MAP DEPARTMENT
226 MIDDLE AVE. ELYRIA, OH

SURVEYED BY: GUY HANEY SURVEY # 51202

CLOSURE: 1: 52666

MAP PAGE(S): 04-00-023

APPOVED BY: WRZ **DATE:** 6/10/2024

SCALE: 1" = 175 **PRIOR INSTRUMENT:** #2023-0907545