PARENT PARCEL: 06-26-006-102-036

CHILD PARCEL: AC CORR PER SURV BY THOMAS A. SIMON

STARTING POINT: NW CORNER OF S/L 19 IN FAXON'S SUB

22-04868-A

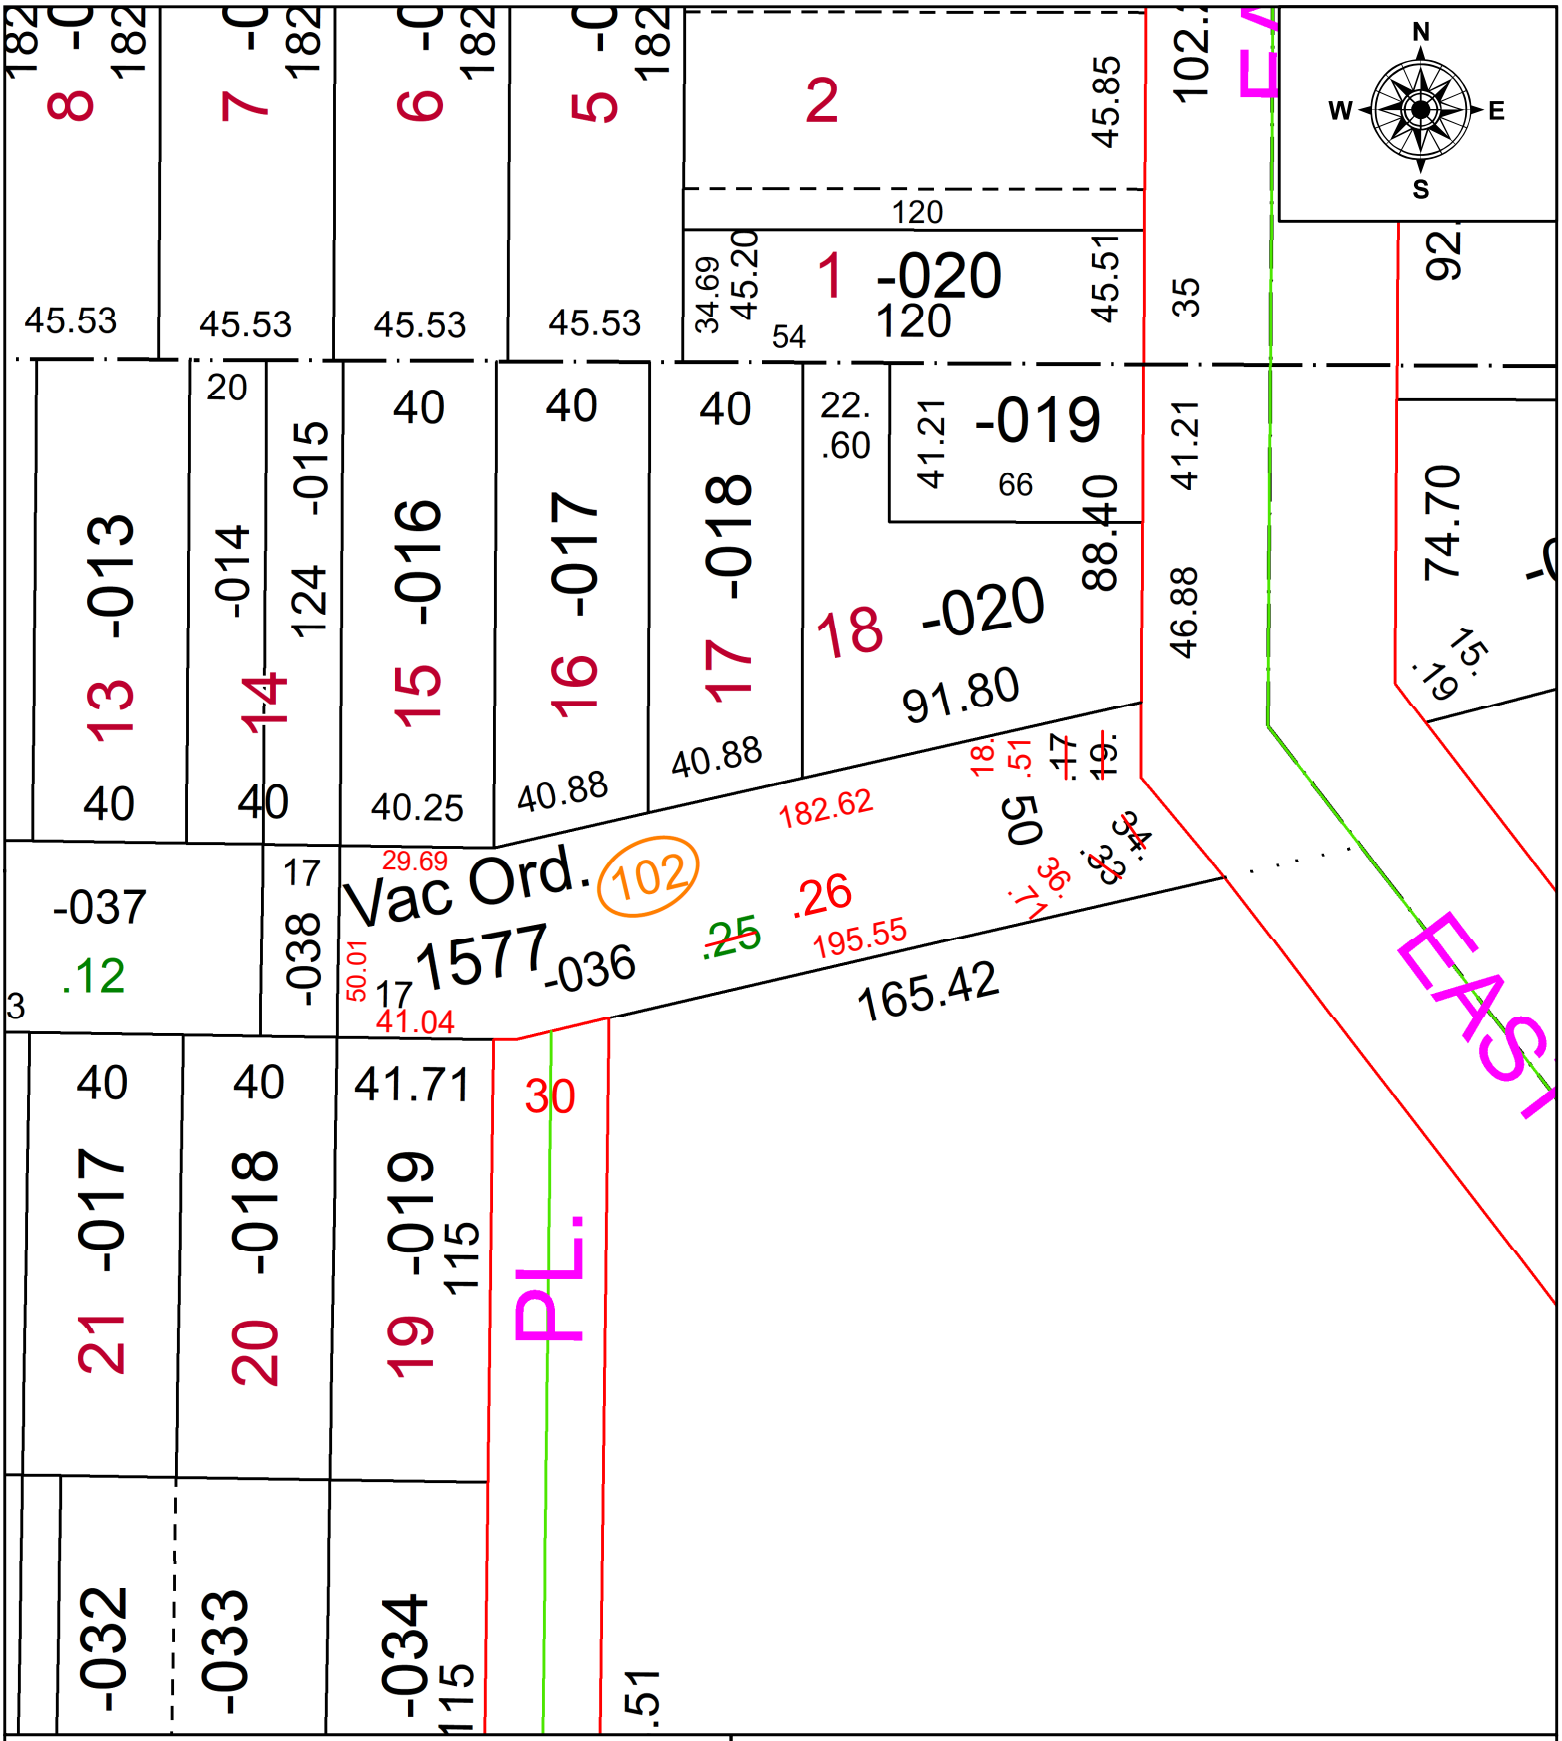

SPLITS/DEEDS PROCESSED

LORAIN COUNTY TAX MAP DEPARTMENT
226 MIDDLE AVE. ELYRIA, OH

SURVEYED BY: THOMAS A. SIMON
CLOSURE: 1: 146006
MAP PAGE(S): 06-26-006
APPOVED BY: AC **DATE:** 5/25/2022
SCALE: 1" = 50 **PRIOR INSTRUMENT:** 1989- 0076157