PARENT PARCEL: 15-00-046-101-259, -065, 15-00-046-105-005, -006, -016, -019, & -020

CHILD PARCEL: 15-00-046-101-262 & 15.00-046-105-023

STARTING POINT: FRONT & DEPTH AND AC CORR PER SURV BY JOHN A. DECHANT JR.

24-04868

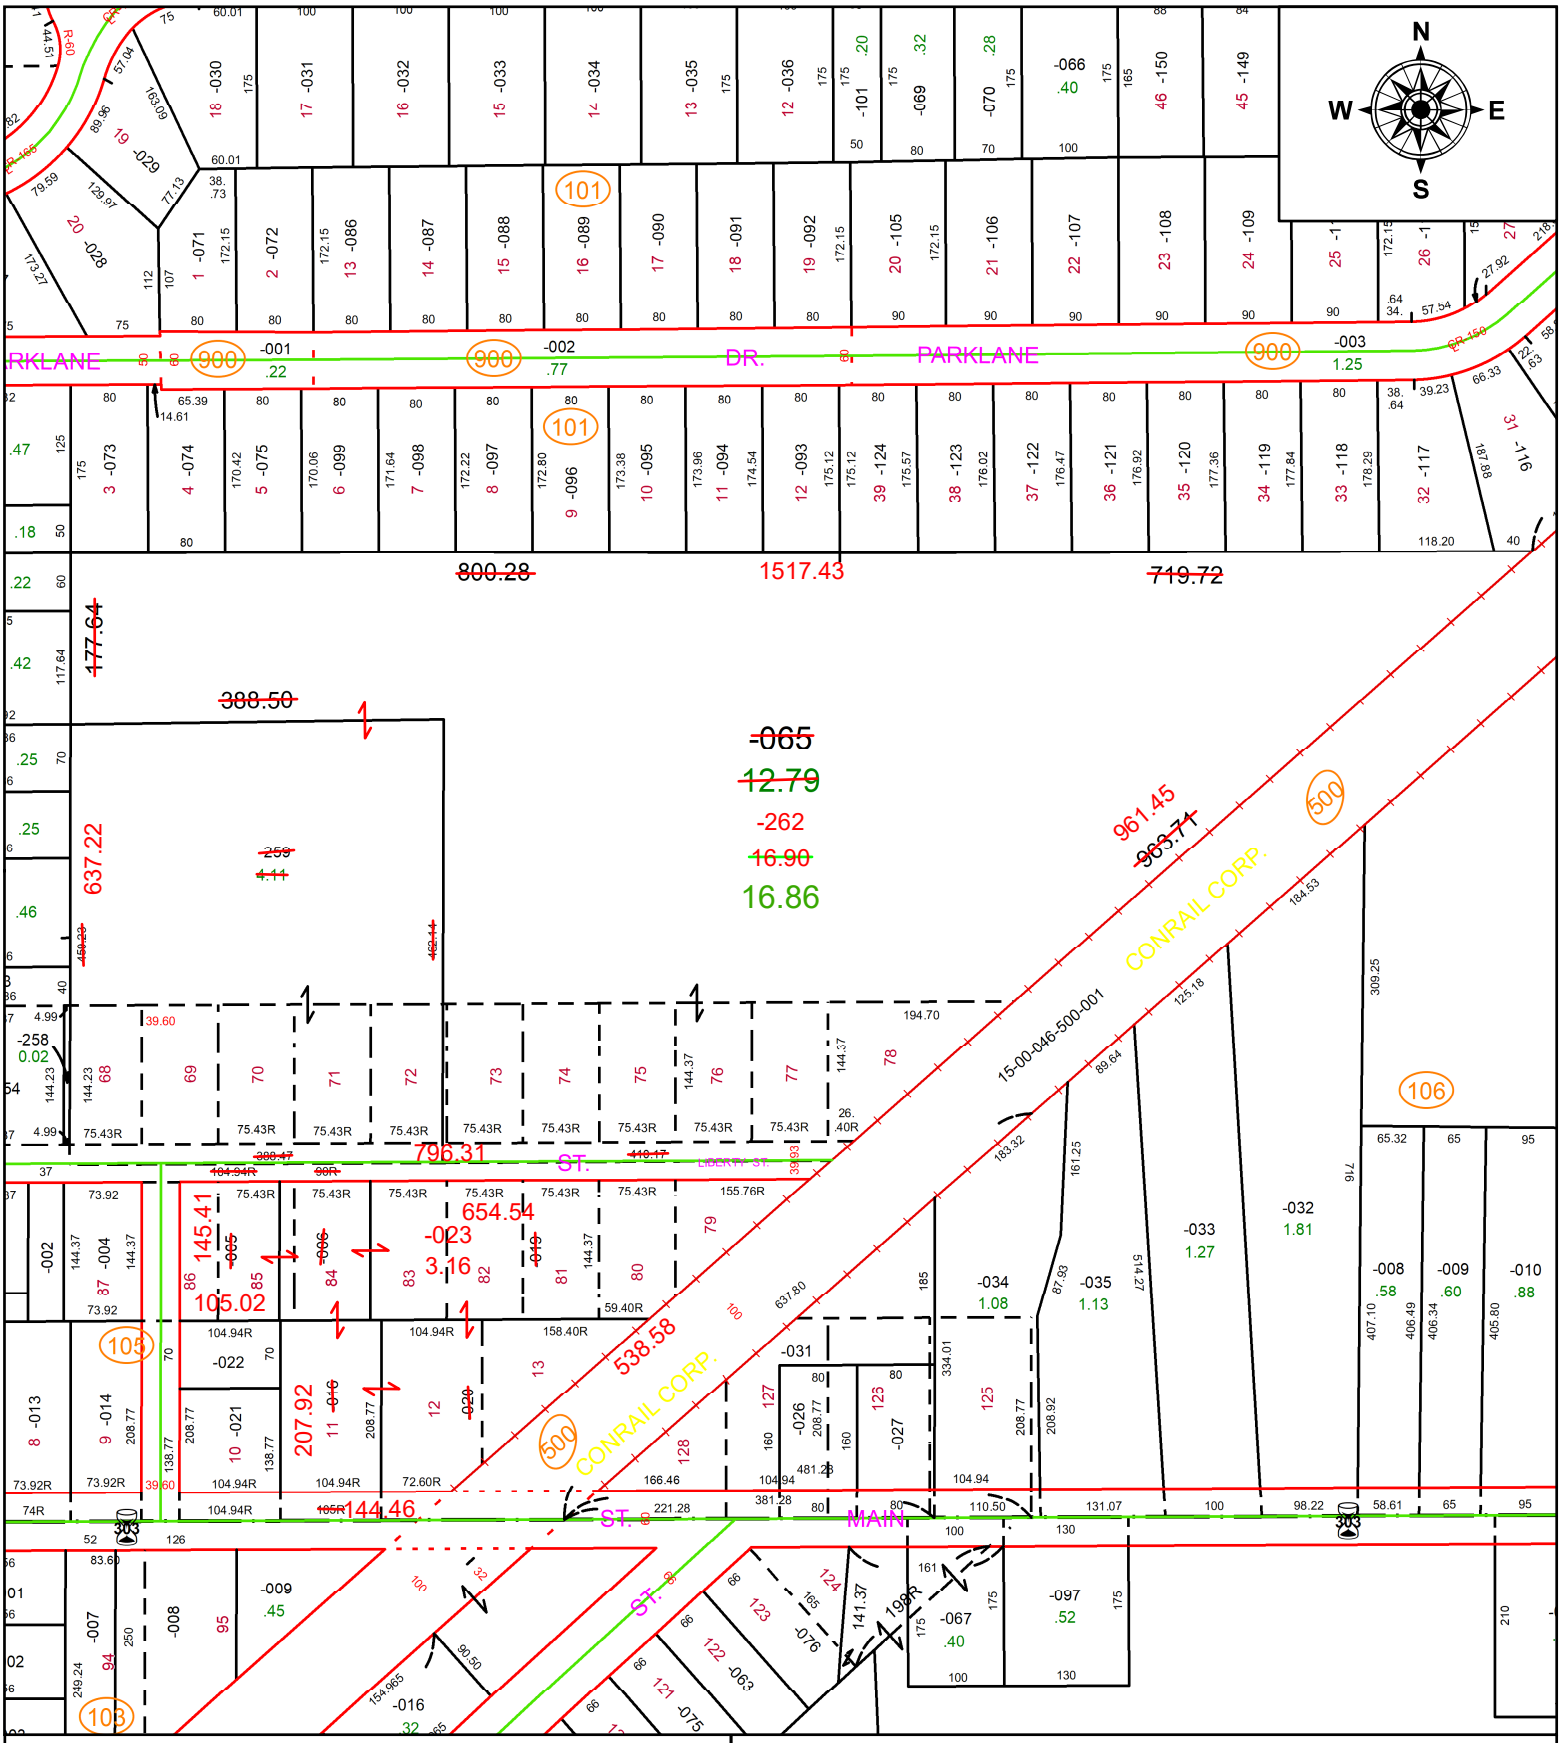

SPLITS/DEEDS PROCESSED

LORAIN COUNTY TAX MAP DEPARTMENT
226 MIDDLE AVE. ELYRIA, OH

SURVEYED BY: JOHN A. DECHANT JR **SURV # 51209**

CLOSURE: 1: 537205

MAP PAGE(S): 15-00-046

APPOVED BY: AC **DATE:** June 17, 2024

SCALE: 1 in = 200 ft **PRIOR INSTRUMENT:** 2017- 0618028