PARENT PARCEL: 19-01-025-000-016, -017 AC CORR PER SURVEYOR RICHARD METZKER

CHILD PARCEL: 19-01-025-000-020, -021, 19-01-026-000-005, (S.T.) & 19-01-027-000-004 (S.T.)

STARTING POINT: INTERSECTION OF C/LS SMITH RD & FOSTER RD

24-04871

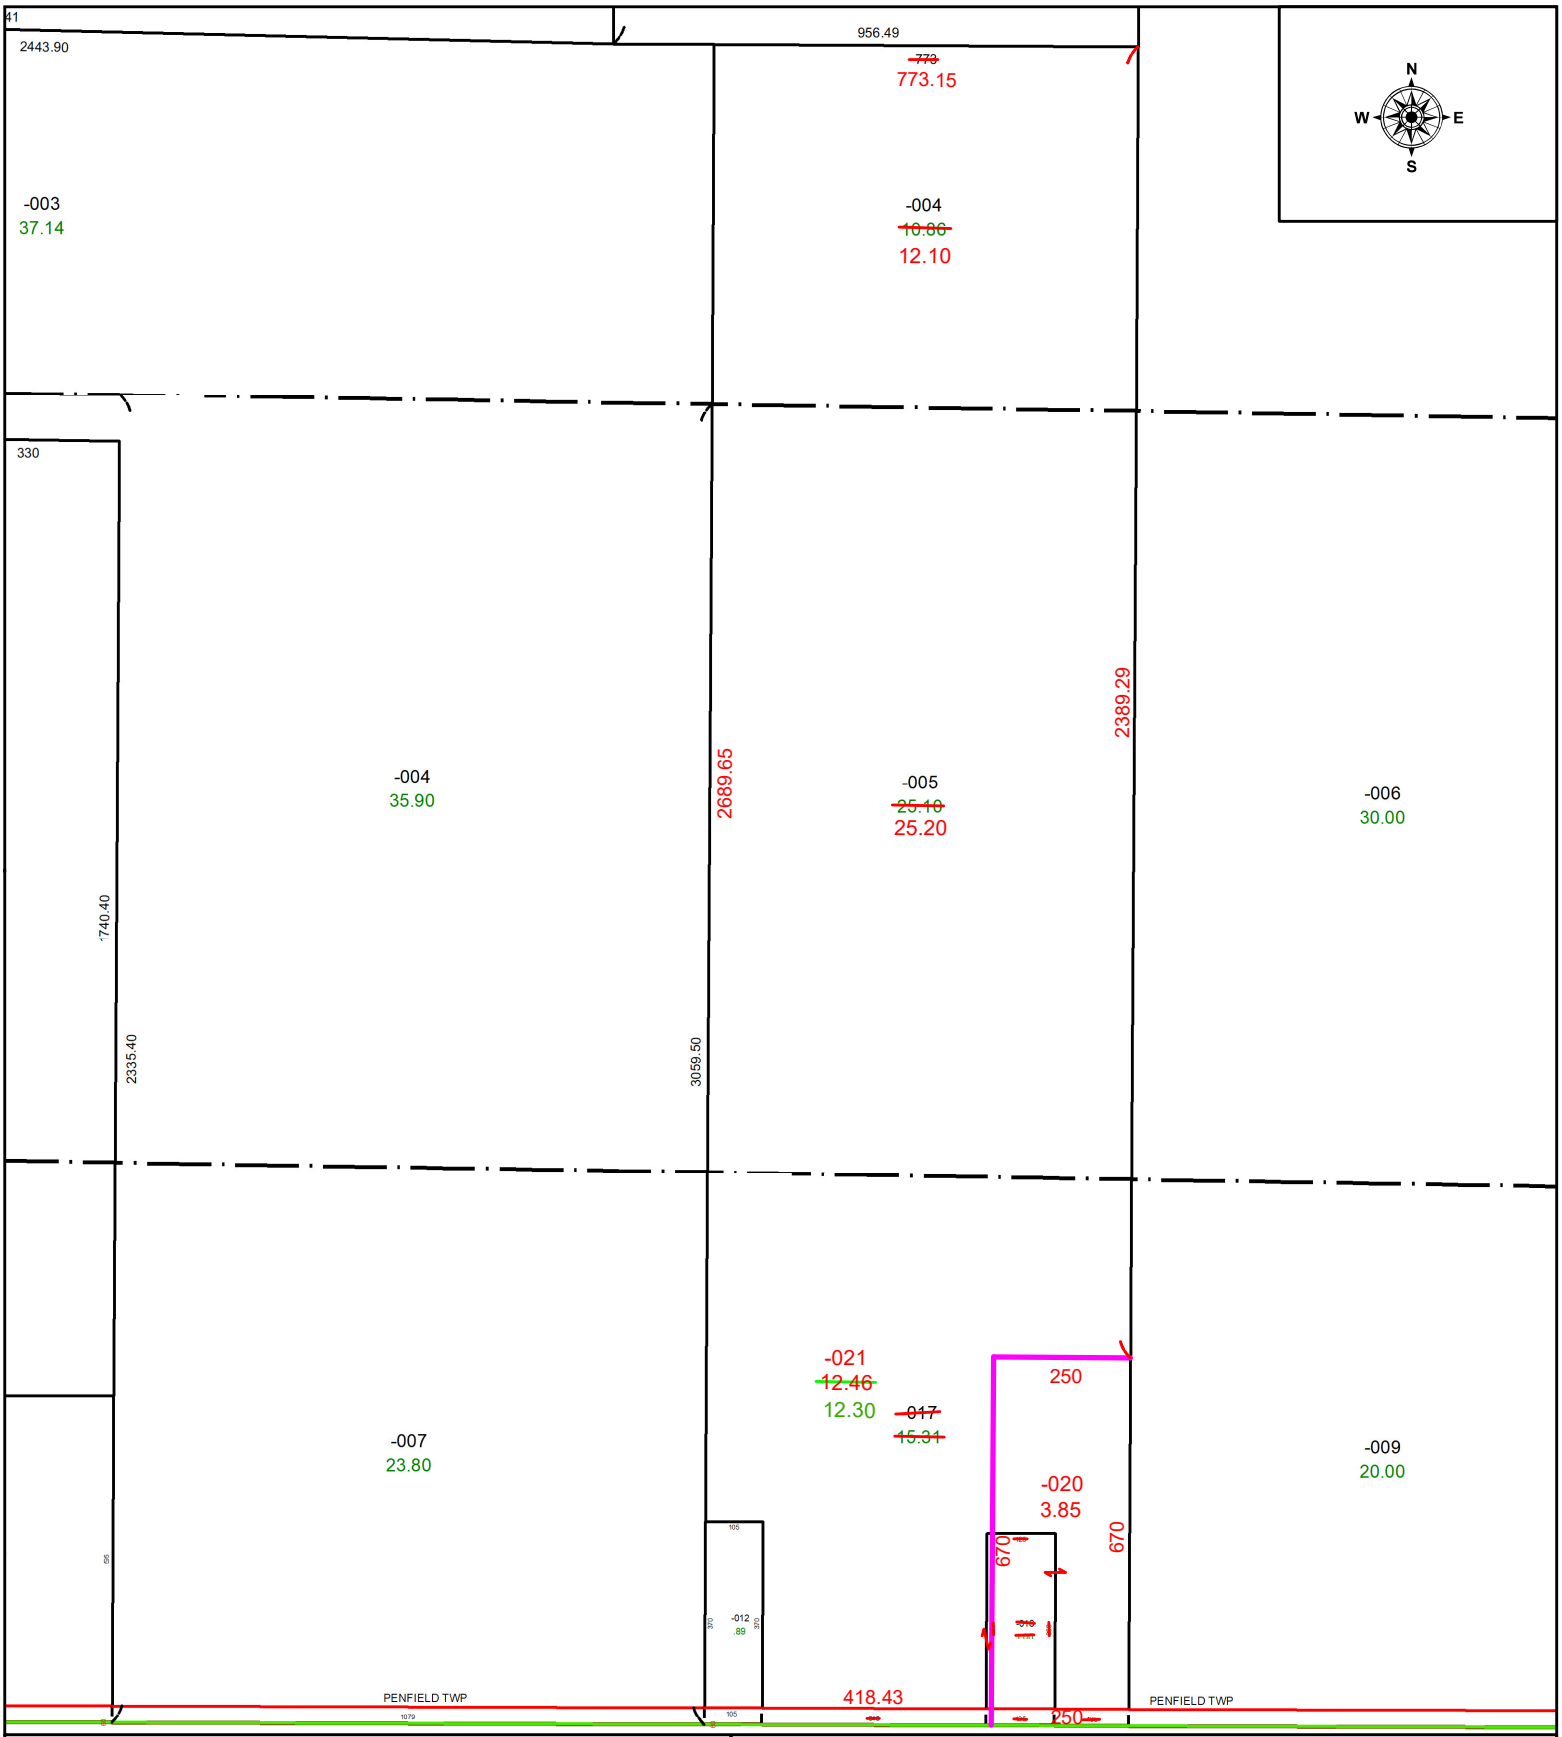

SPLITS/DEEDS PROCESSED

LORAIN COUNTY TAX MAP DEPARTMENT
226 MIDDLE AVE. ELYRIA, OH

SURVEYED BY: RICHARD METZKER SURVEY # 51213

CLOSURE: 1: INF

MAP PAGE(S): 19-01-025, -026, & -027

APPOVED BY: WRZ **DATE:** 6/21/2024

SCALE: 1" = 350 **PRIOR INSTRUMENT:** #2023-0906433