PARENT PARCEL: 06-25-163-000-027

CHILD PARCEL: AC CORR PER PRIOR DEED INSTU 1999- 0627493

STARTING POINT: C/L OF WHITEHEAD AND SR 303

22-04873-A

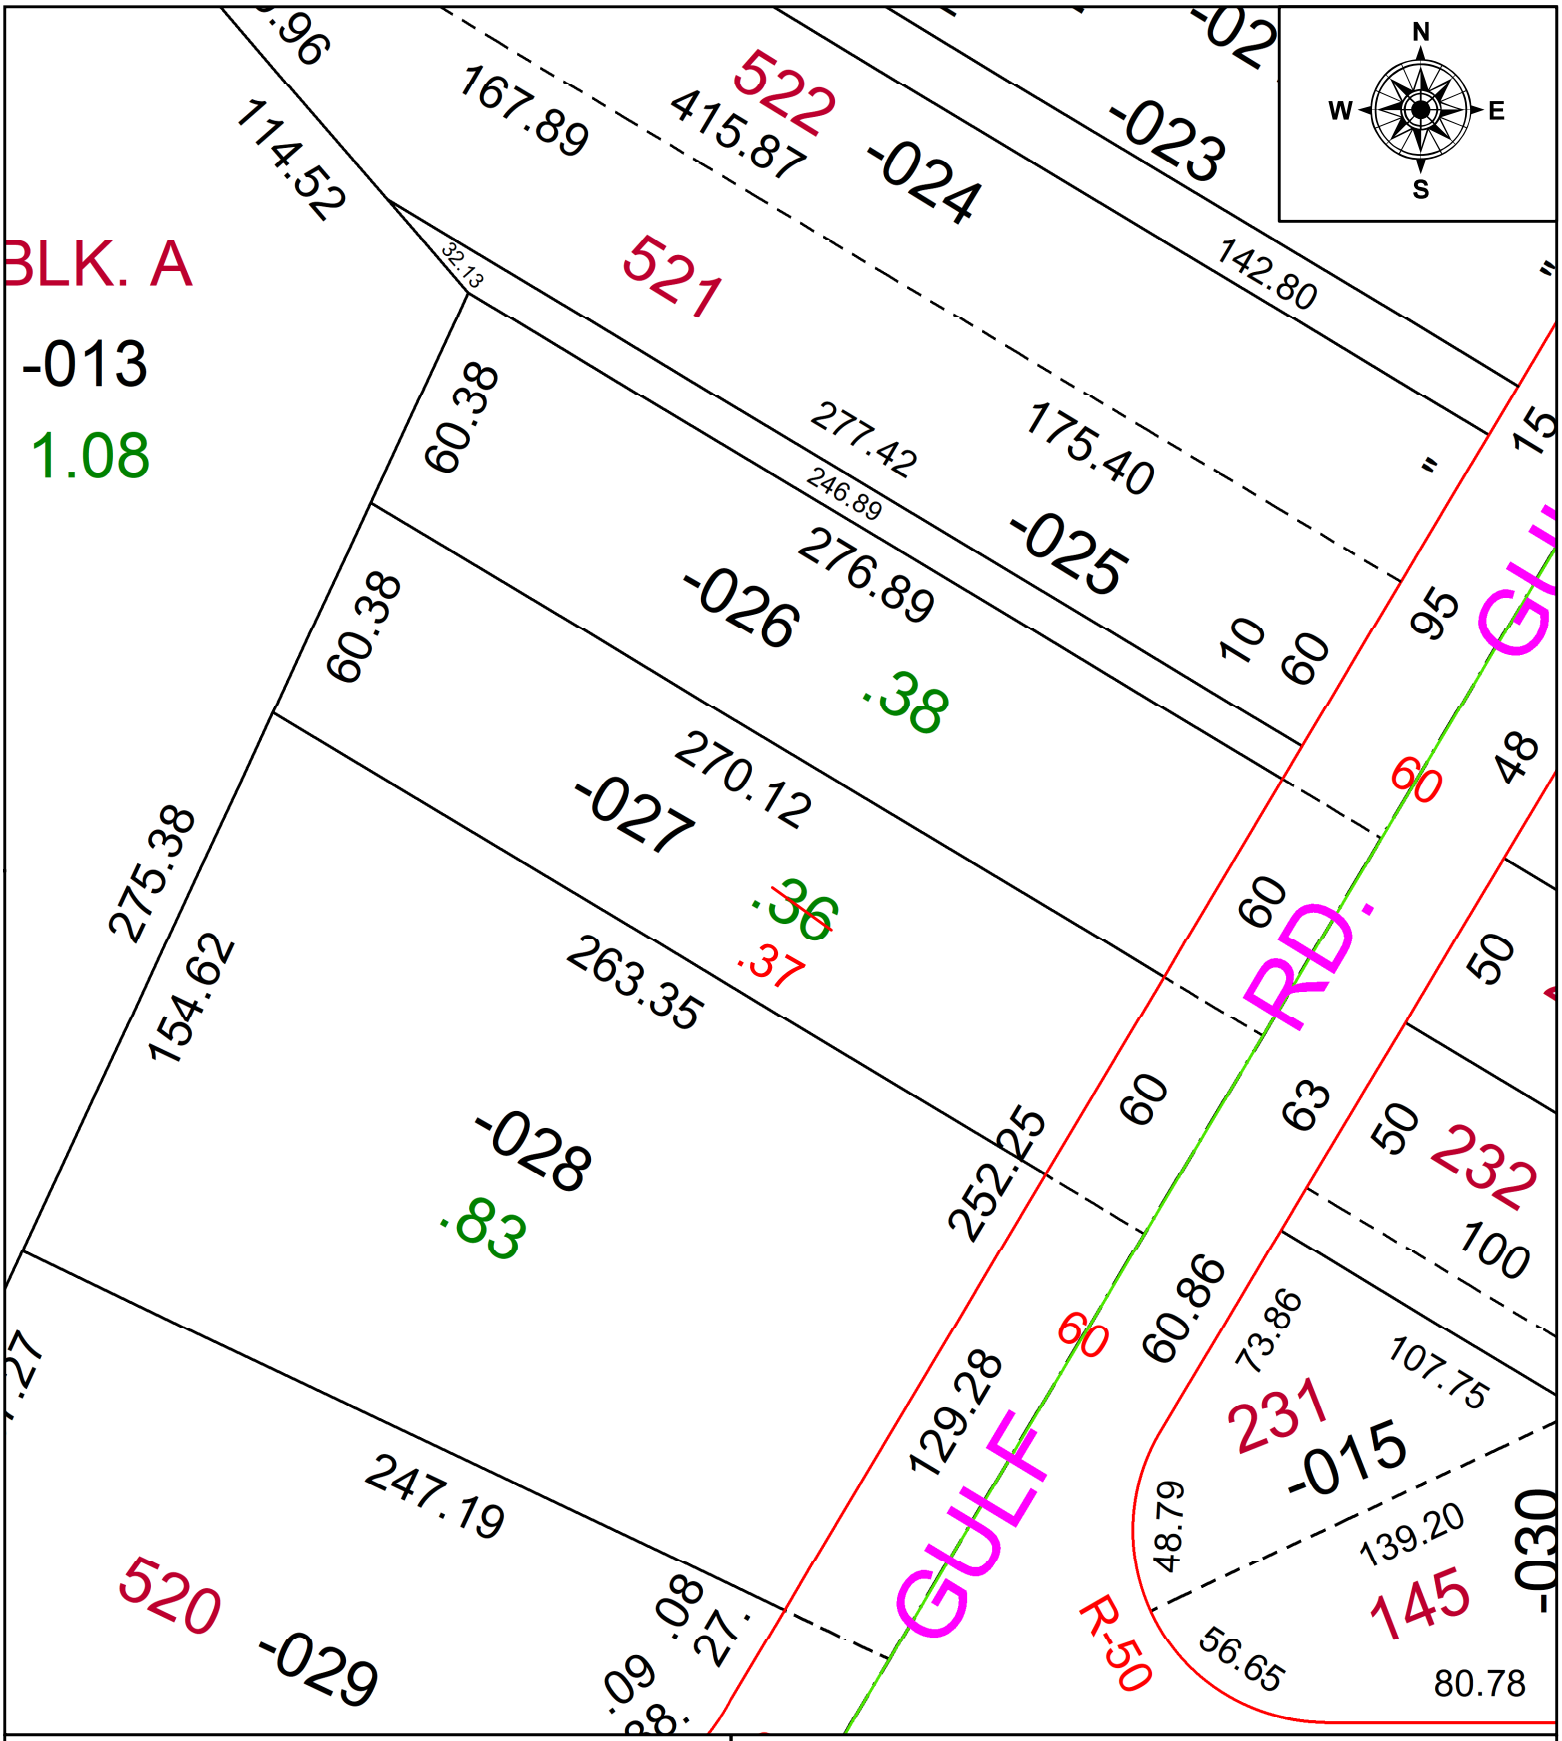

SPLITS/DEEDS PROCESSED

LORAIN COUNTY TAX MAP DEPARTMENT
226 MIDDLE AVE. ELYRIA, OH

SURVEYED BY: N/A
CLOSURE: N/A
MAP PAGE(S): N/A
APPOVED BY: AC **DATE:** 6/2/2022
SCALE: 1" = 50 **PRIOR INSTRUMENT:** 1999- 0627493