PARENT PARCEL: 06-24-102-000-027 & -028
CHILD PARCEL: 06-24-102-000-039
STARTING POINT: FRONT & DEPTH TO AC CORR PER SURV BY THOMAS A. SIMON

24-04875

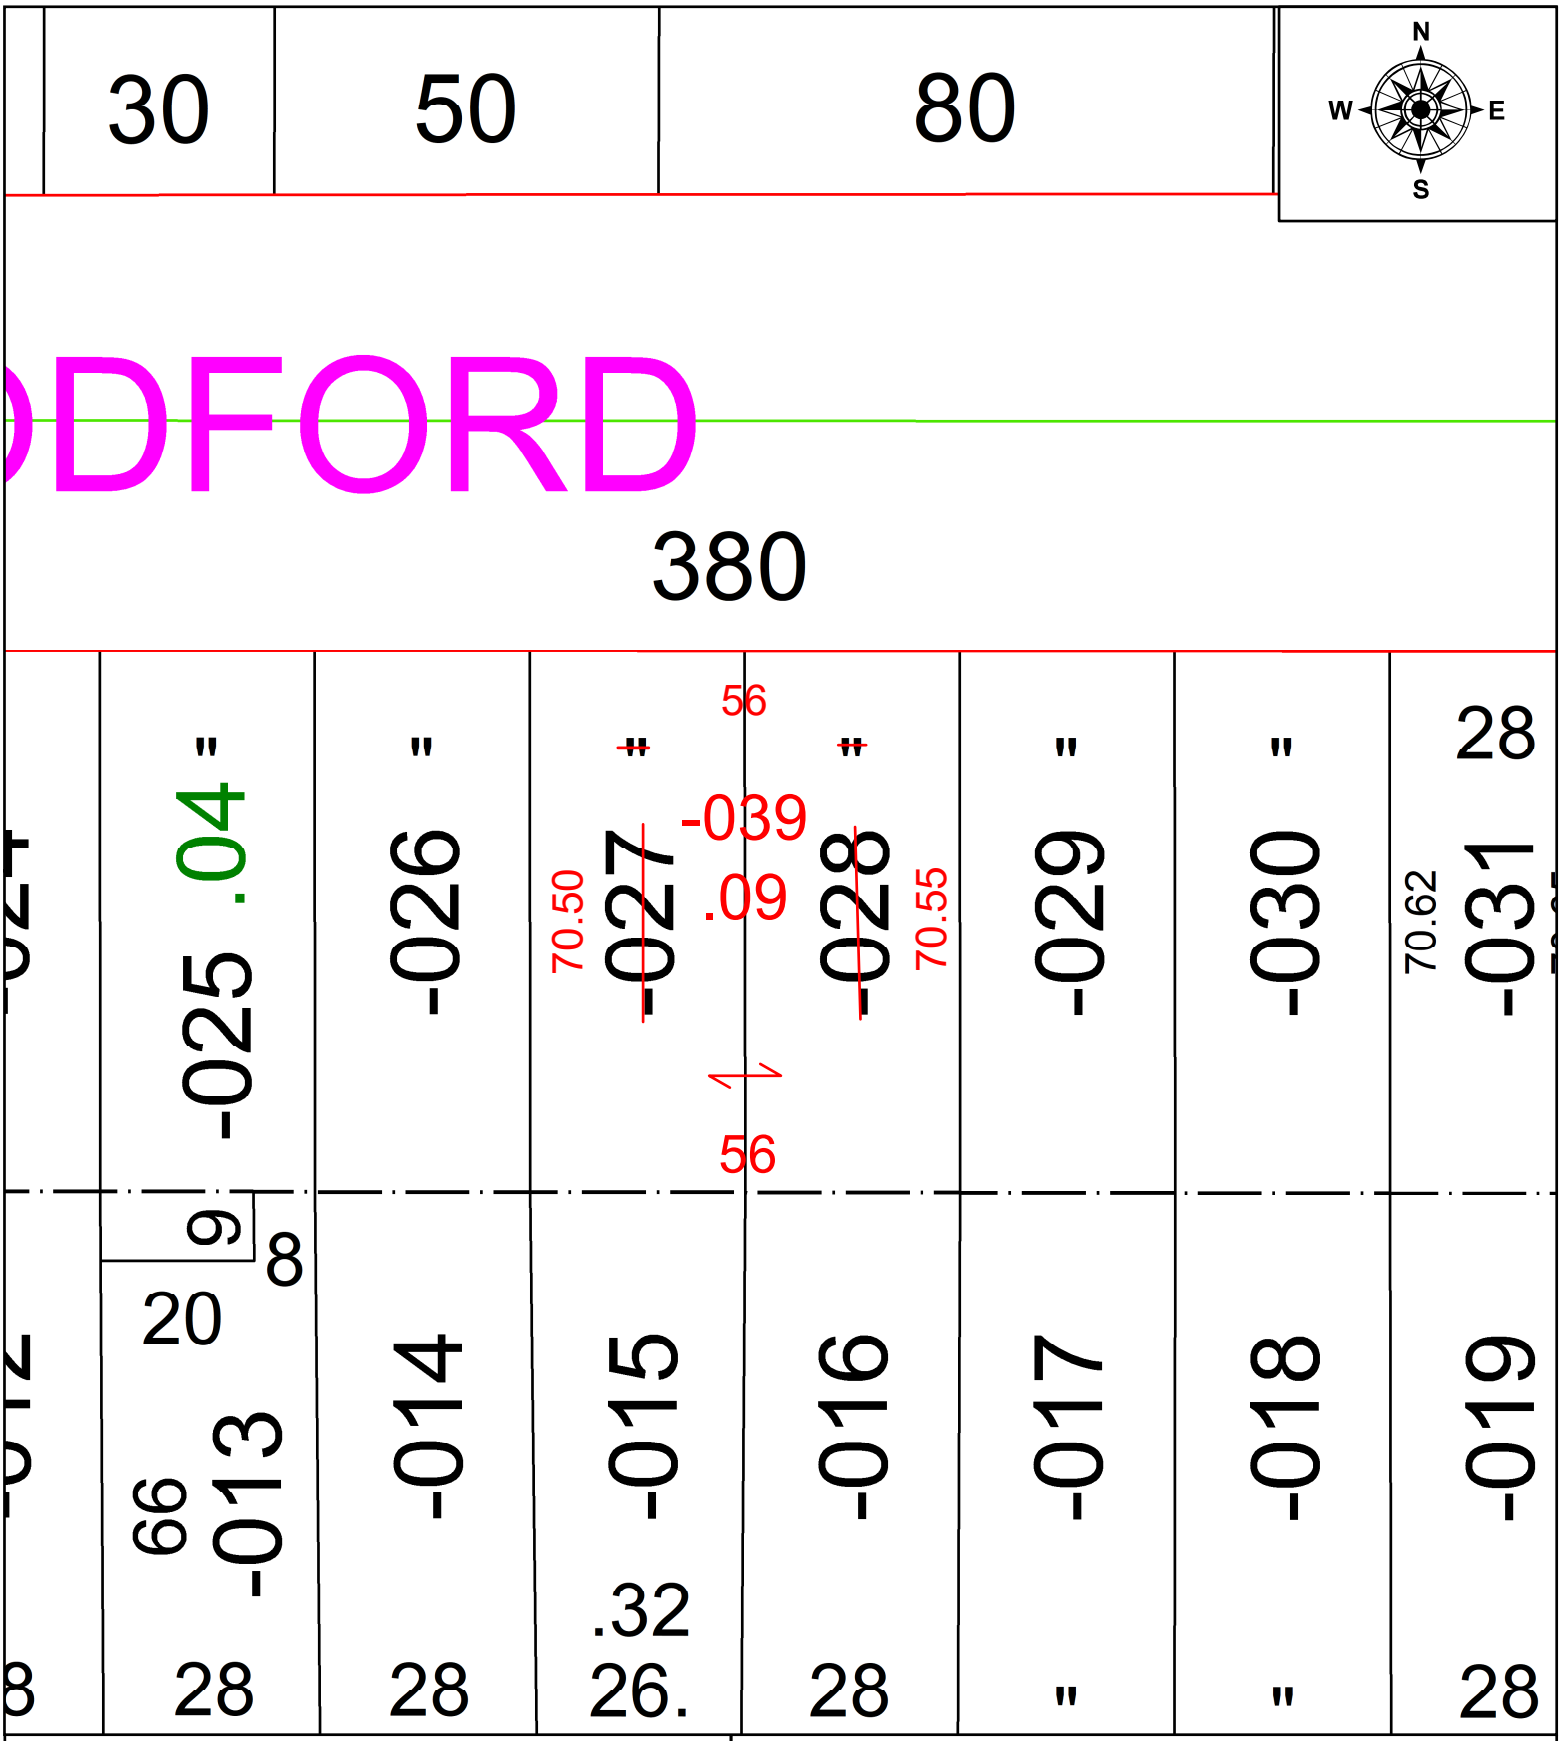

SPLITS/DEEDS PROCESSED
LORAIN COUNTY TAX MAP DEPARTMENT
226 MIDDLE AVE. ELYRIA, OH

SURVEYED BY: THOMAS A. SIMON **SURV # 51216**
CLOSURE: 1: 46990
MAP PAGE(S): 06-24
APPOVED BY: AC **DATE:** June 27, 2024
SCALE: 1 in = 25 ft **PRIOR INSTRUMENT:** 2023- 0932583