PARENT PARCEL: 05-00-090-000-016
CHILD PARCEL: 05-00-090-000-017 THRU -021
STARTING POINT: INTERSECTION OF C/LS ALBRECHT RD & FOWL RD

24-04876

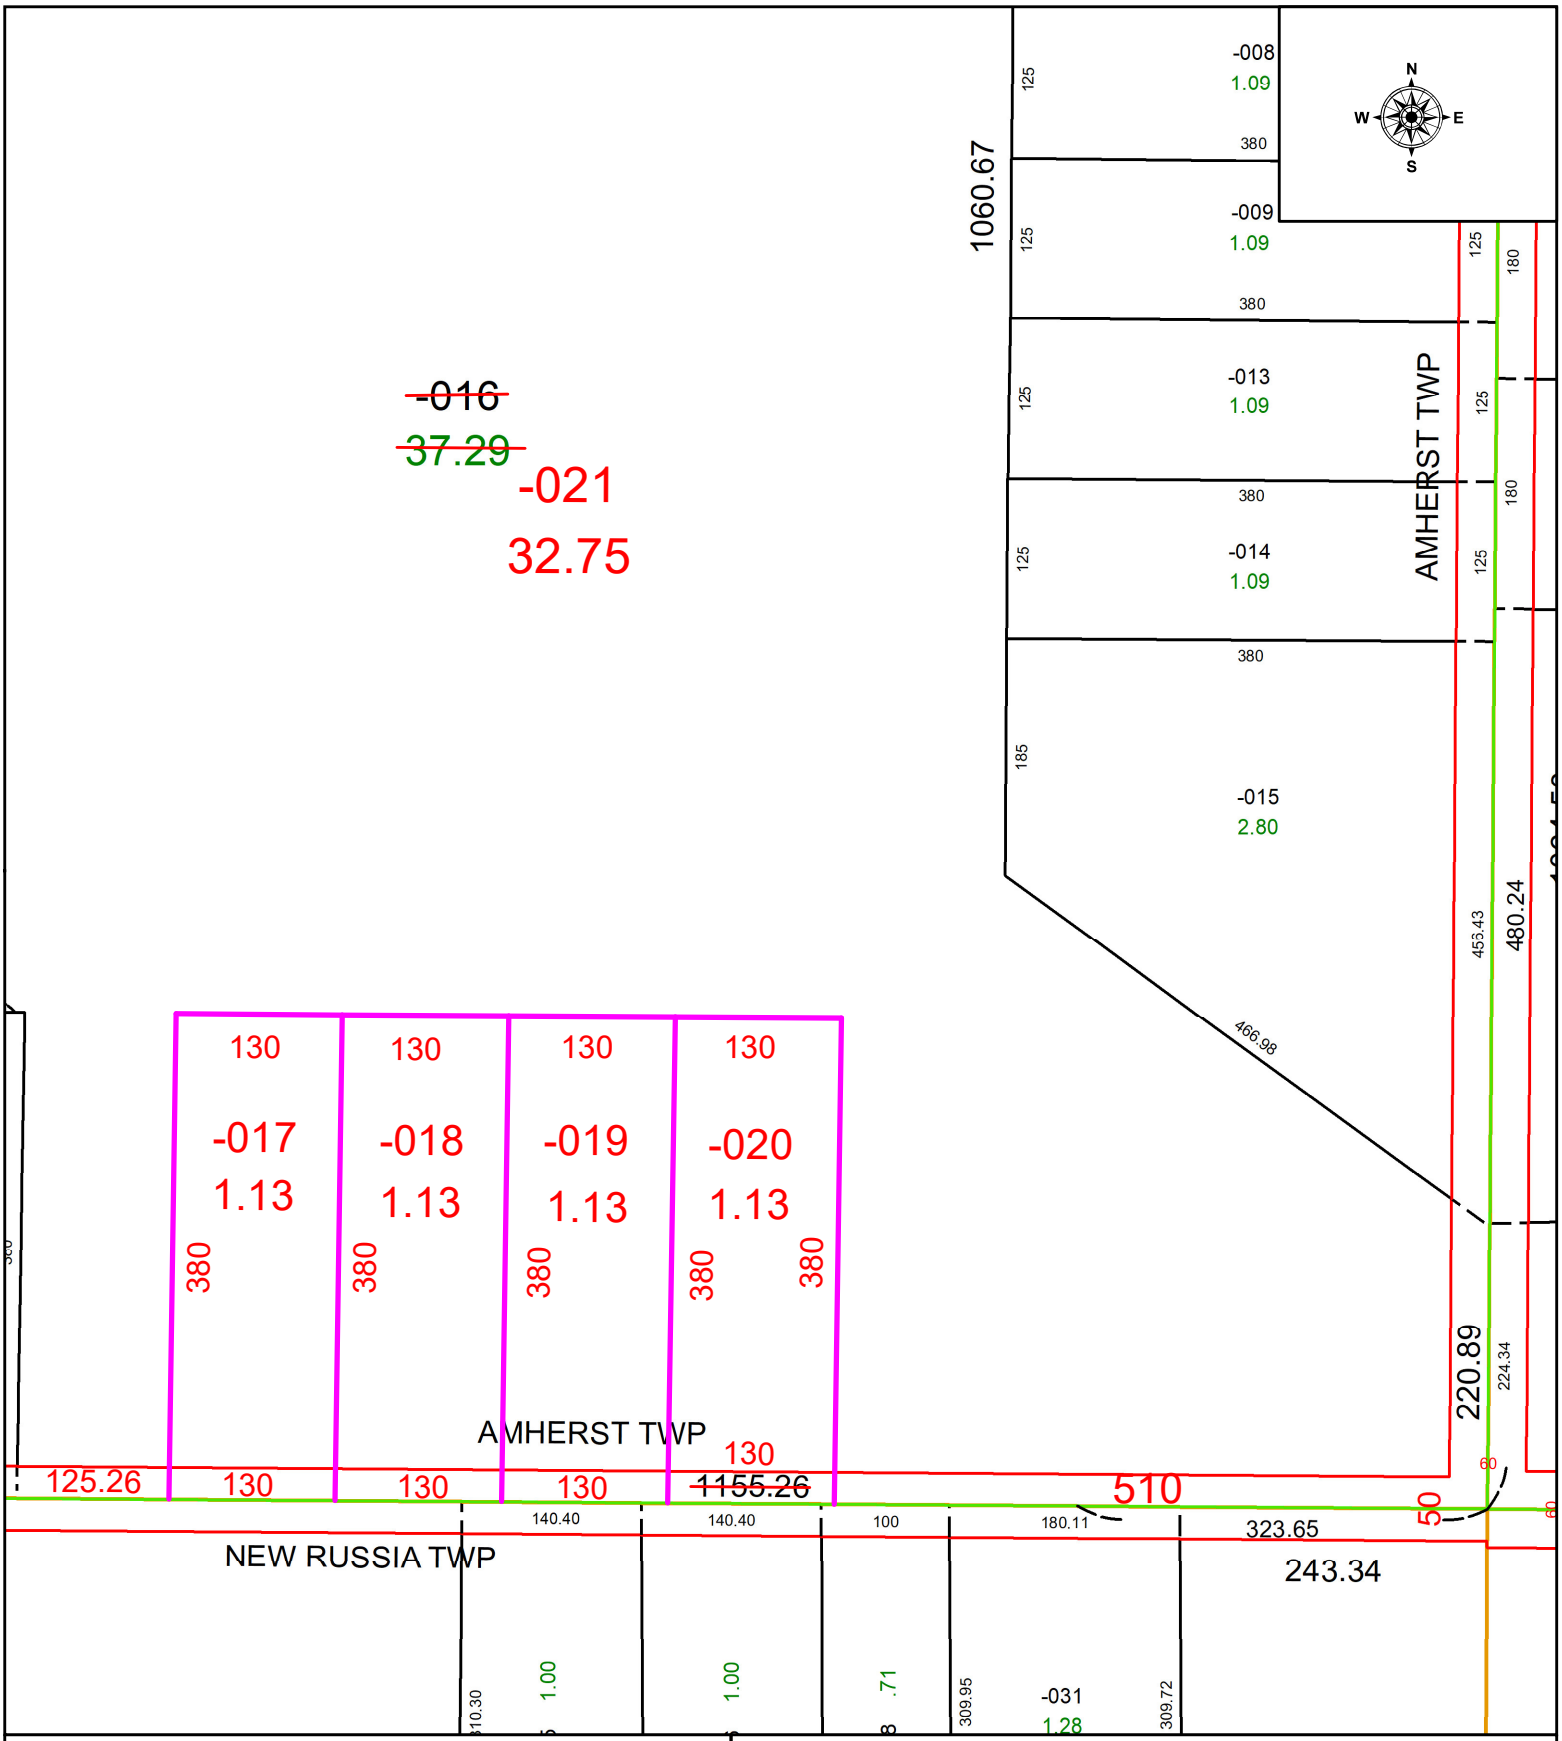

SPLITS/DEEDS PROCESSED
LORAIN COUNTY TAX MAP DEPARTMENT
226 MIDDLE AVE. ELYRIA, OH

SURVEYED BY: THOMAS SIMON SURVEY # 51219
CLOSURE: 1: INF
MAP PAGE(S): 05-00-090
APPOVED BY: WRZ **DATE:** 7/2/2024
SCALE: 1" = 150 **PRIOR INSTRUMENT:** #2024-0013435