PARENT PARCEL: 01-00-059-000-026, 01-00-059-000-022 (S.T.) & -023 (S.T.)

CHILD PARCEL: 01-00-059-000-033, -034, -022 (S.T.) & -023 (S.T.)

STARTING POINT: SOUTHWESTERLY CORNER OF O.L. 59

24-04877

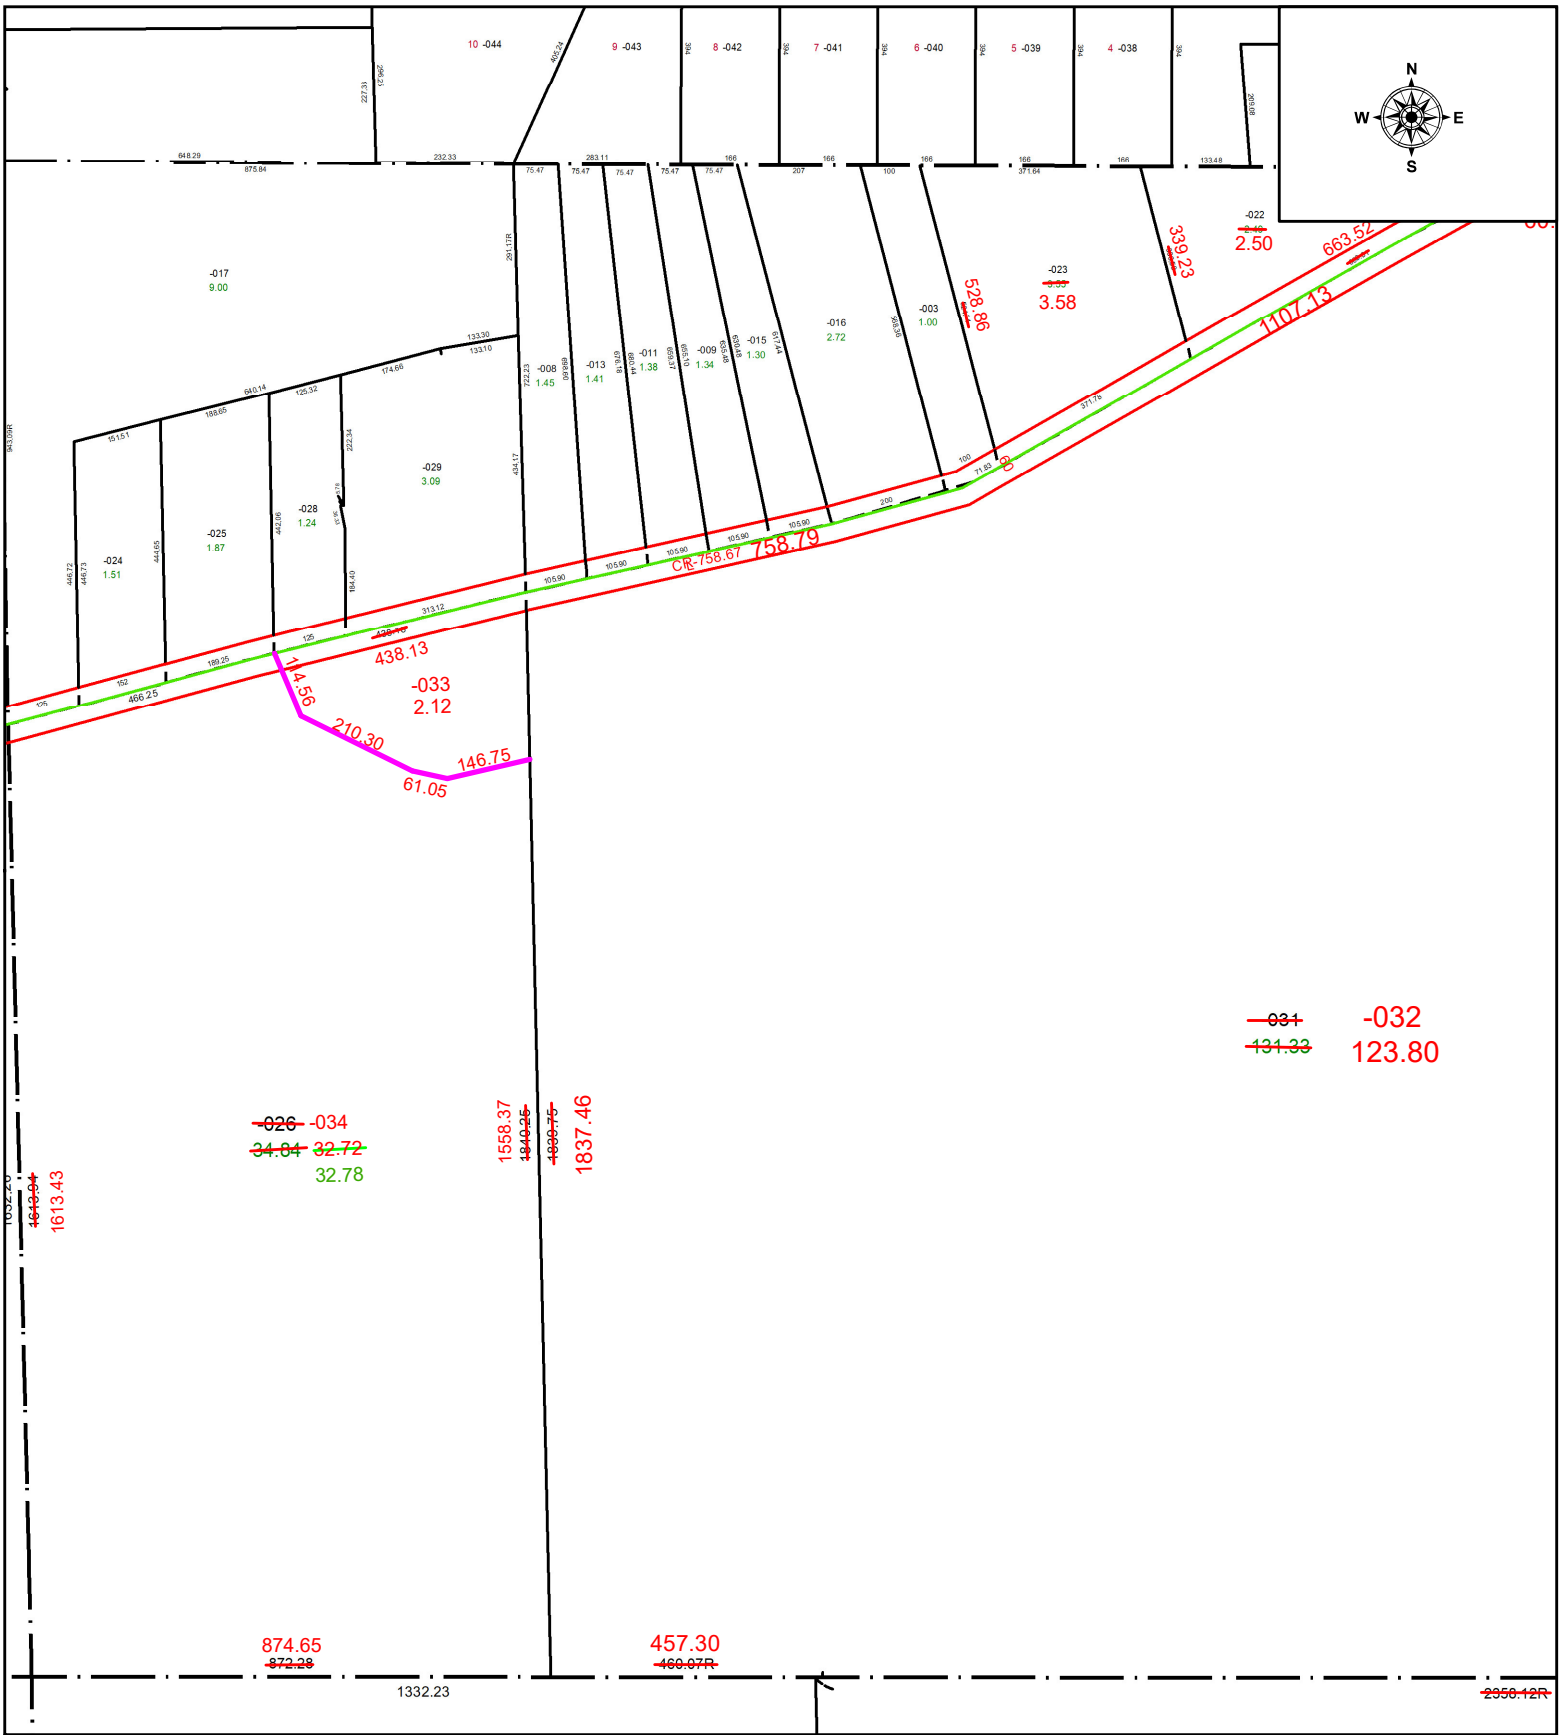

SPLITS/DEEDS PROCESSED

LORAIN COUNTY TAX MAP DEPARTMENT
226 MIDDLE AVE. ELYRIA, OH

SURVEYED BY: THOMAS SIMON SURVEY # 51177 & 51220

CLOSURE: 1: 179279

MAP PAGE(S): 01-00-059

APPOVED BY: WRZ **DATE:** 7/5/2024

SCALE: 1" = 325 **PRIOR INSTRUMENT:** #2020-0770752