PARENT PARCEL: 01-00-039-000-014 & -008

CHILD PARCEL: 01-00-039-000-070

STARTING POINT: INTERSECTION OF C/LS OF NORTH RIDGE RD & EASTERLY LINE OF O.L. 39

24-04879

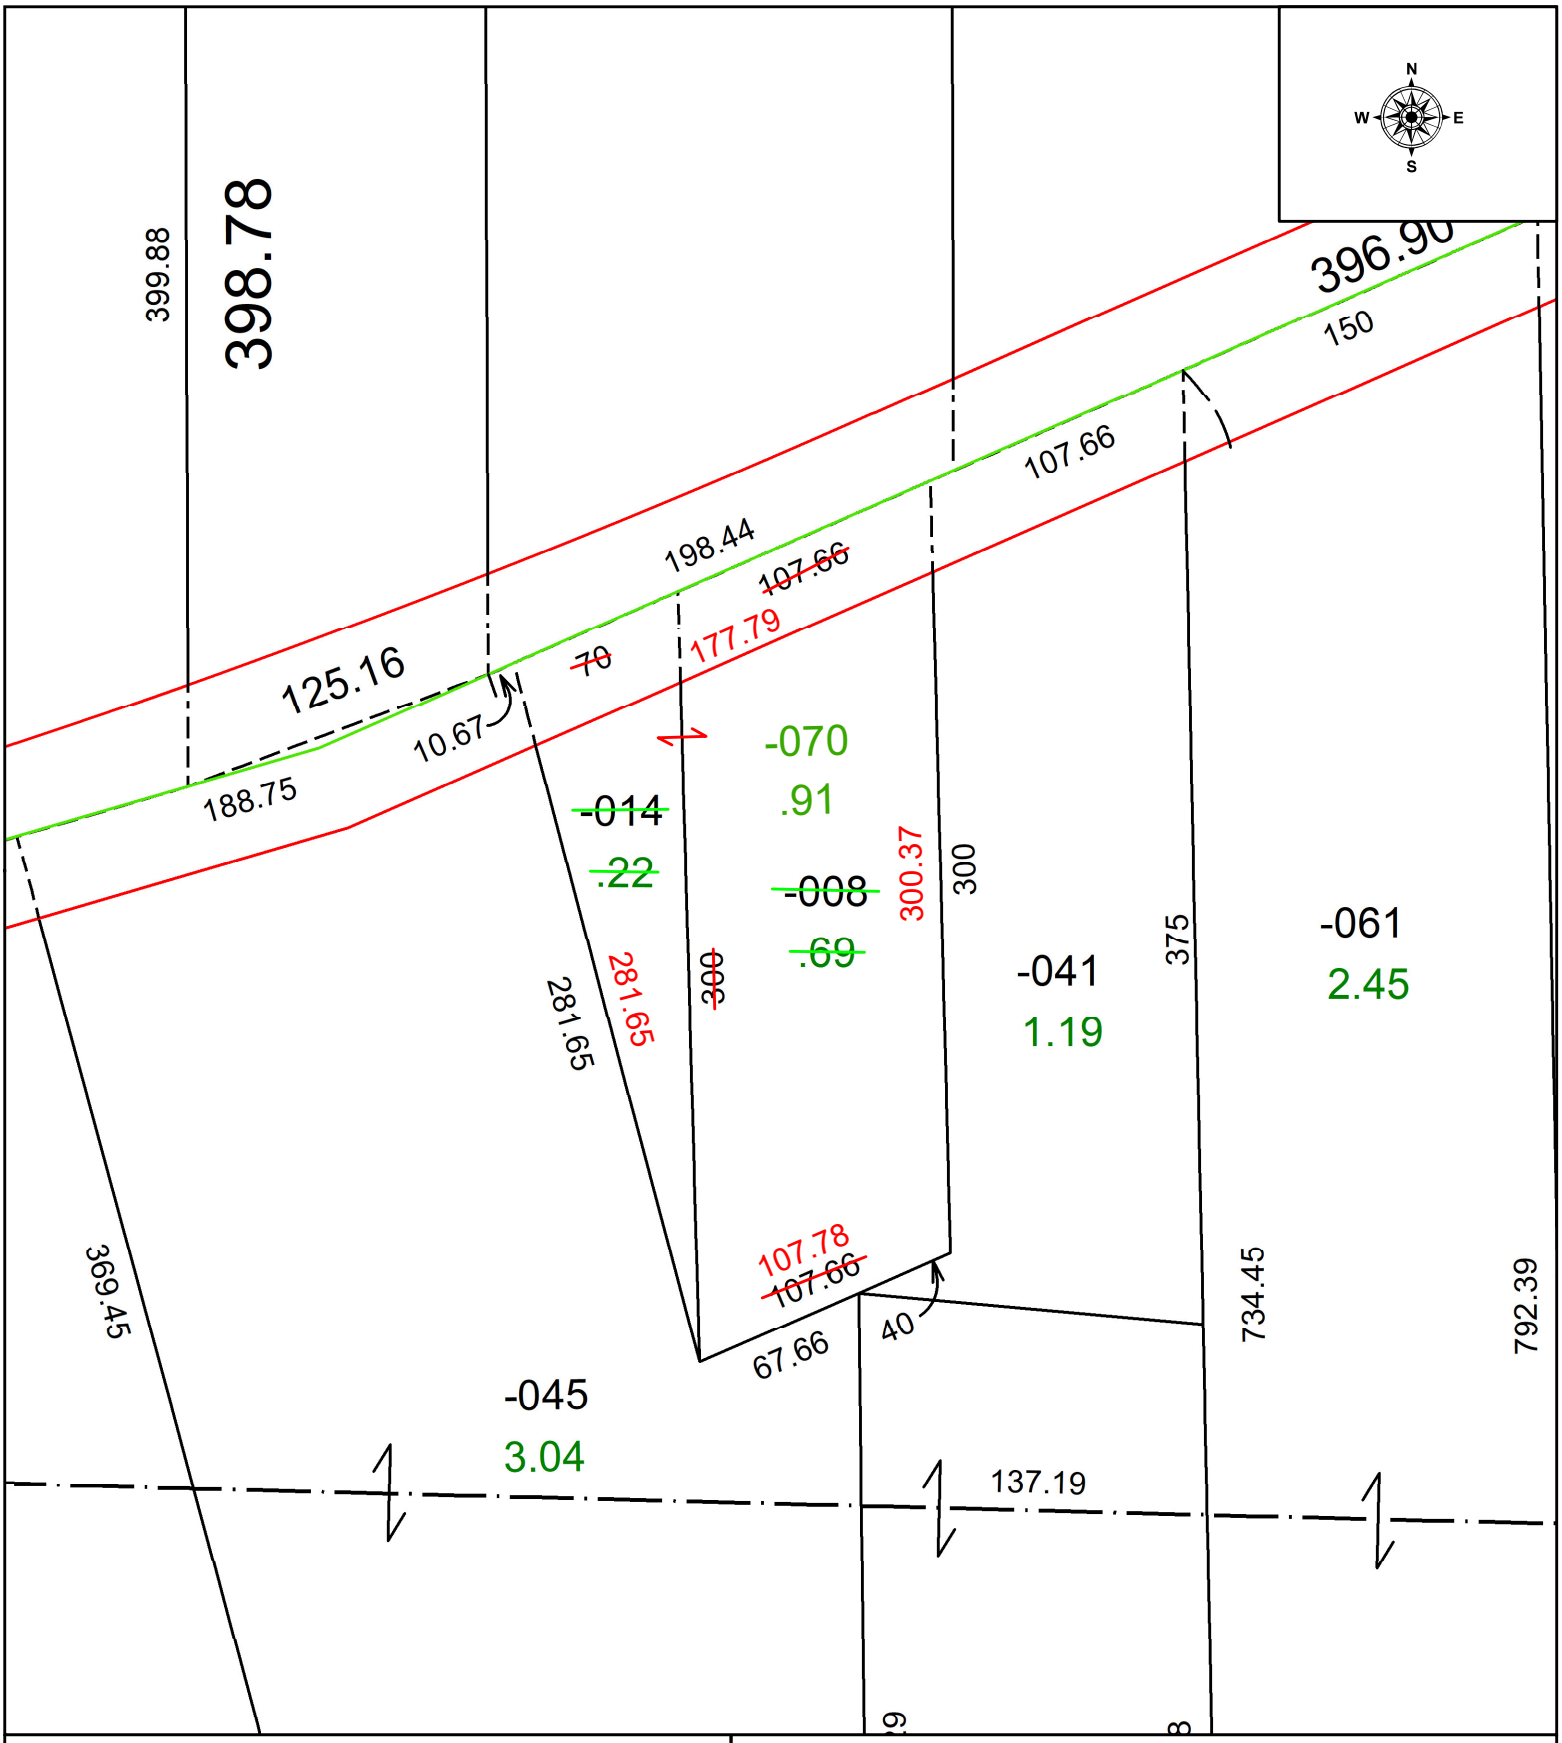

SPLITS/DEEDS PROCESSED

LORAIN COUNTY TAX MAP DEPARTMENT
226 MIDDLE AVE. ELYRIA, OH

SURVEYED BY: JOHN DECHANT JR. SURVEY # 51222

CLOSURE: 1: 171996

MAP PAGE(S): 01-00-039

APPOVED BY: WRZ **DATE:** 7/8/2024

SCALE: 1" = 75 **PRIOR INSTRUMENT:** #2016-0588508