PARENT PARCEL: 05-00-100-000-105

CHILD PARCEL: 05-00-100-000-106 & -107

STARTING POINT: INTERSECTION OF C/LS OF STAG HORN LN & BUCK HORN BLVD

24-04884

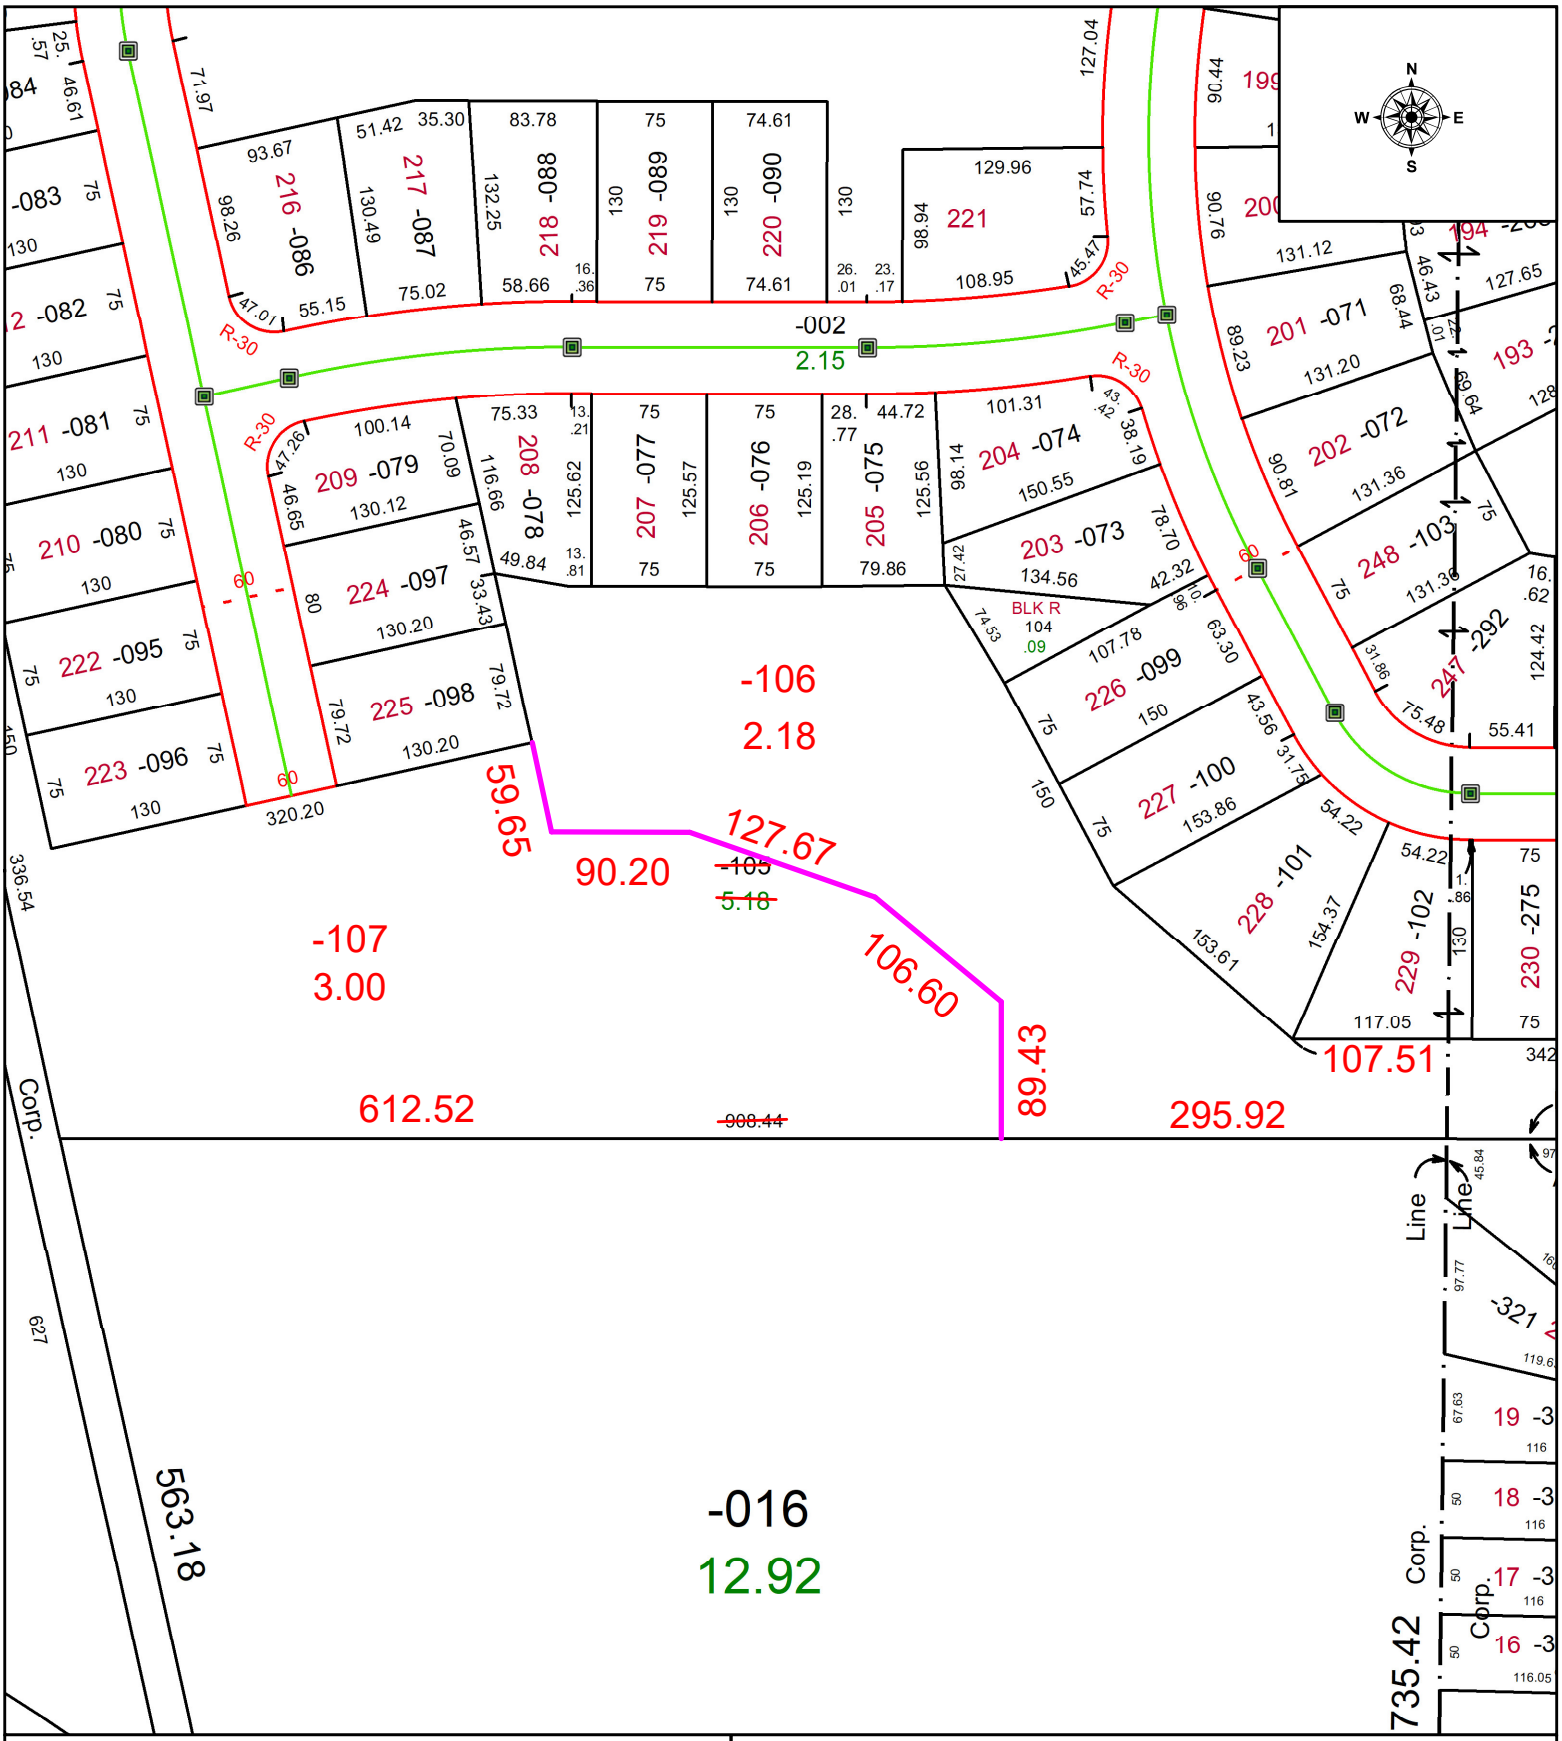

SPLITS/DEEDS PROCESSED

LORAIN COUNTY TAX MAP DEPARTMENT
226 MIDDLE AVE. ELYRIA, OH

SURVEYED BY: RICHARD THOMPSON JR. SURVEY # 51235

CLOSURE: 1: 145150

MAP PAGE(S): 05-00-100

APPOVED BY: WRZ **DATE:** 7/24/2024

SCALE: 1" = 125 **PRIOR INSTRUMENT:** #2016-093434