PARENT PARCEL: 03-00-068-000-007 AC. CORR. & ADD TO DUP.

CHILD PARCEL: ADD TO DUP. 03-00-068-000-028 & -029 PER DV 933/585, & #2016-0590533

STARTING POINT: CL OF EAST RIVER RD. & NORTH LINE OF O.L. 68

22-04886-A

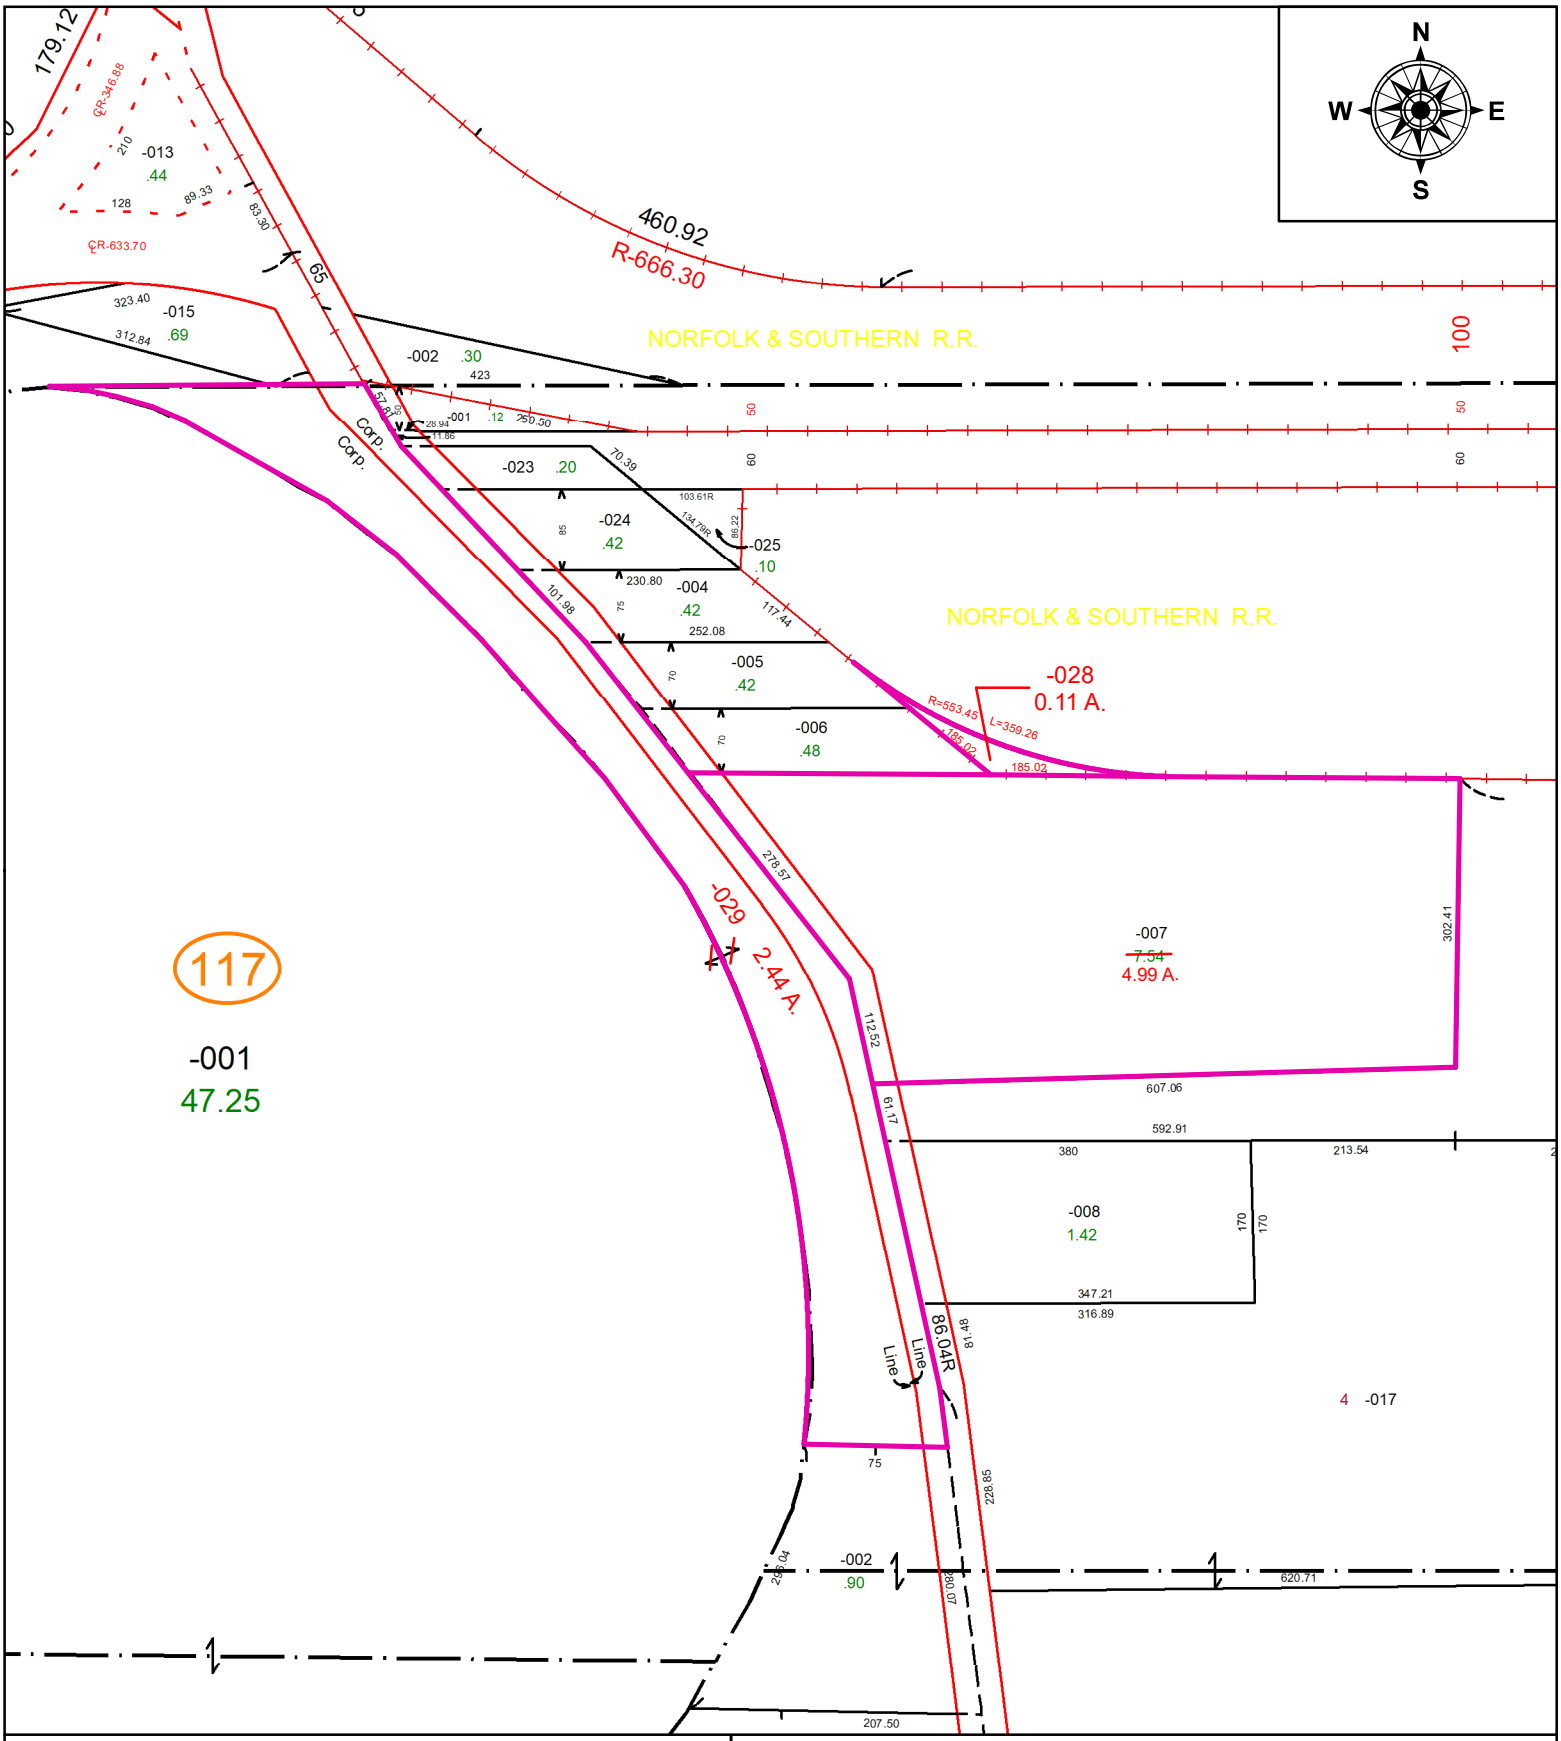

SPLITS/DEEDS PROCESSED

LORAIN COUNTY TAX MAP DEPARTMENT
226 MIDDLE AVE. ELYRIA, OH

SURVEYED BY: NA
CLOSURE: 1: 3100
MAP PAGE(S): 3-00-068
APPOVED BY: TJS **DATE:** 6/27/2022
SCALE: 1" = 200 **PRIOR INSTRUMENT:** DV XXXX/XXXX