PARENT PARCEL: 06-24-025-105-021

CHILD PARCEL: 06-24-025-105-029 & -030 AC CORR PER SURVEYOR THOMAS SIMON

STARTING POINT: SOUTHWESTERLY CORNER OF S/L 22 IN KAISER BROTHERS SUB.

24-04888

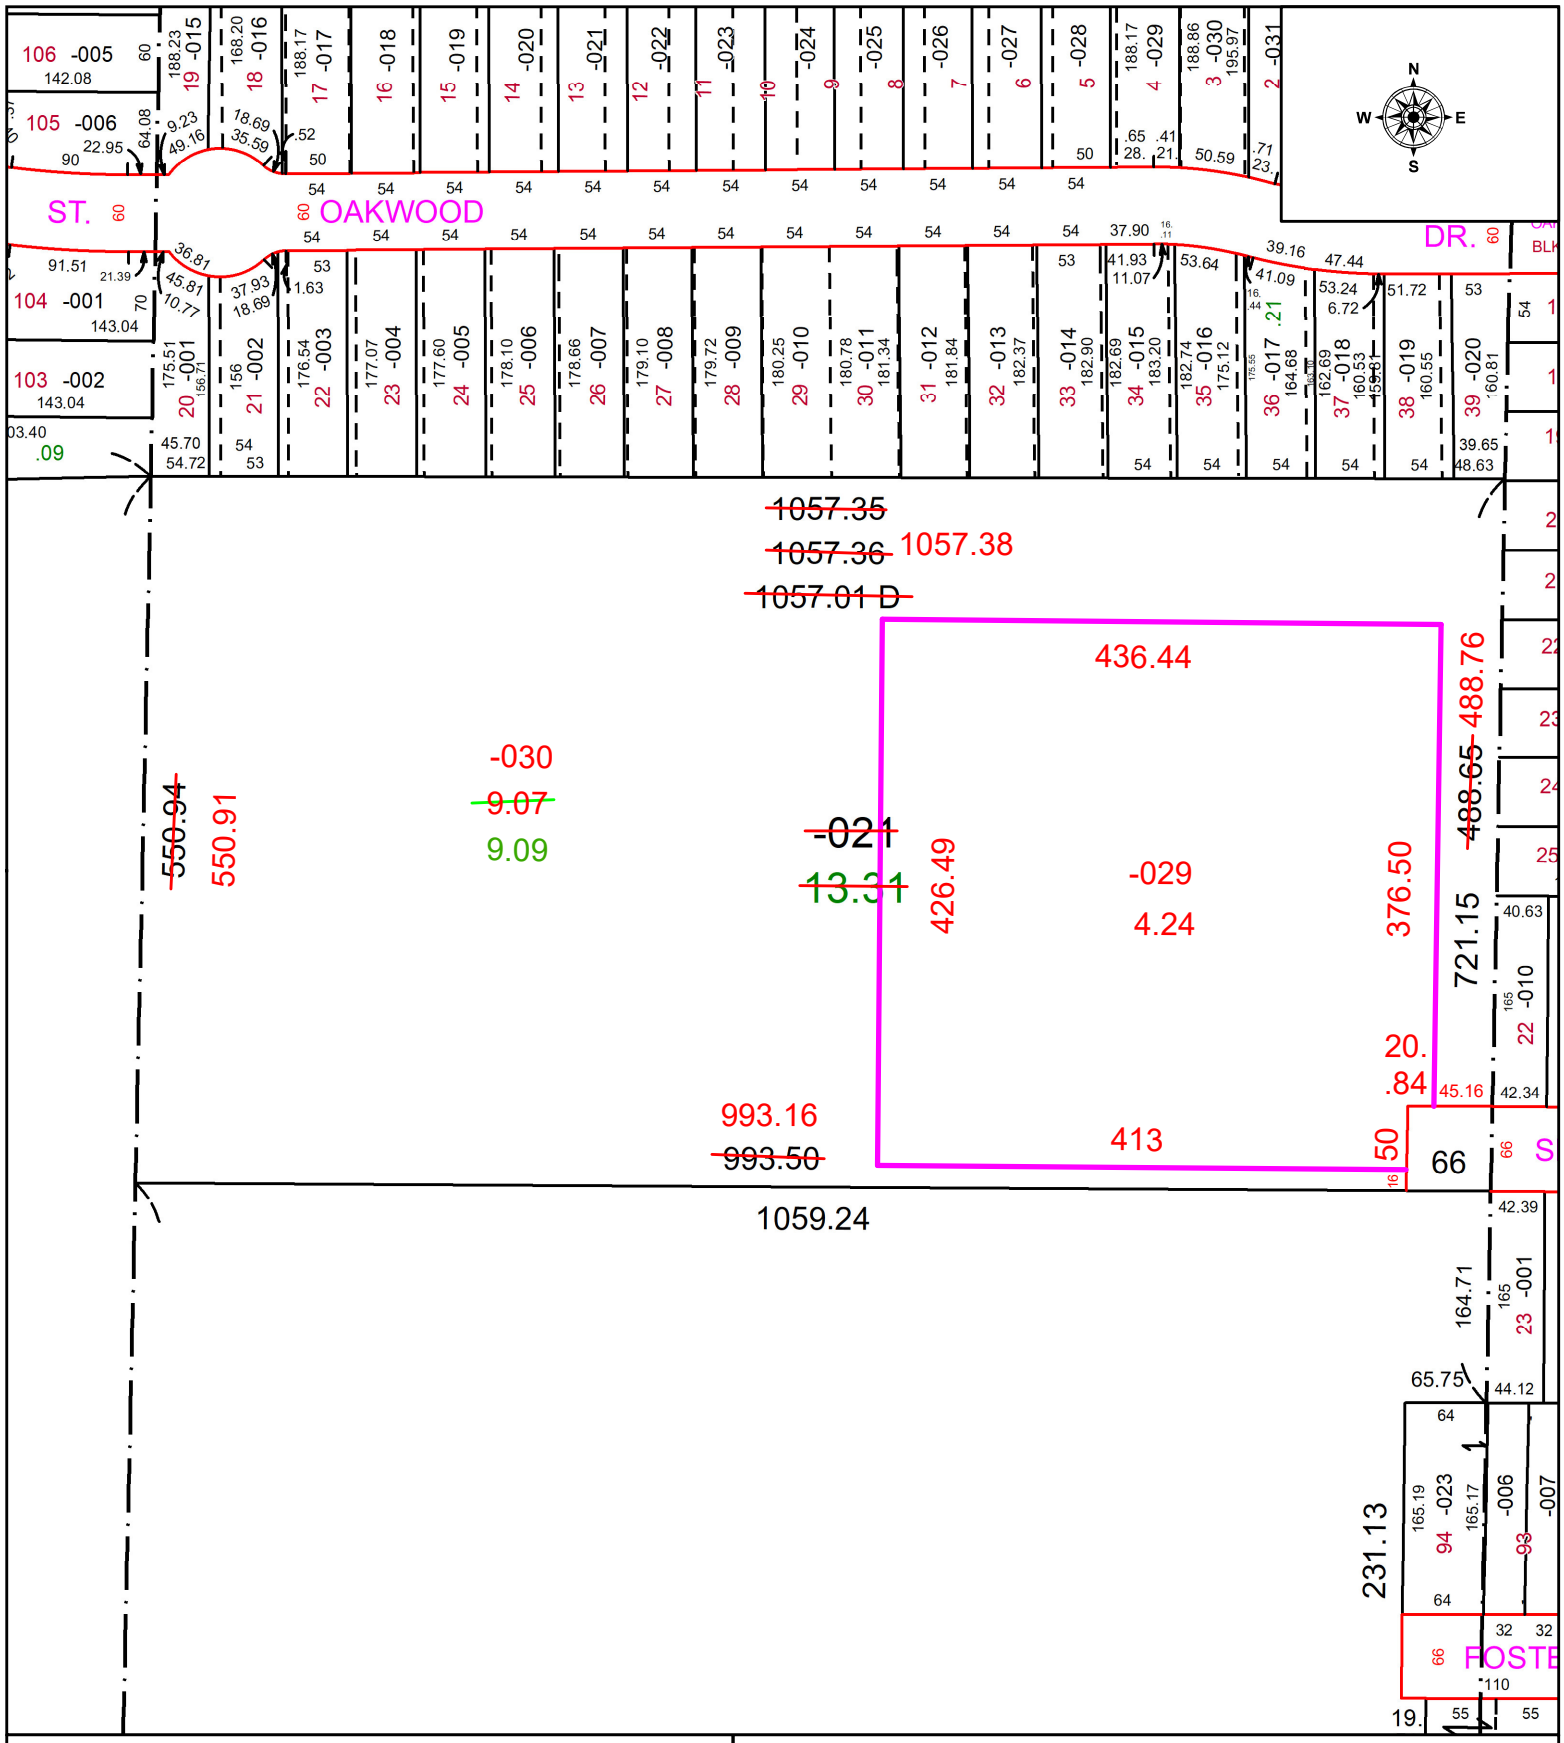

SPLITS/DEEDS PROCESSED

LORAIN COUNTY TAX MAP DEPARTMENT
226 MIDDLE AVE. ELYRIA, OH

SURVEYED BY: THOMAS SIMON SURVEY # 51241

CLOSURE: 1: 150534

MAP PAGE(S): 06-24-025

APPOVED BY: WRZ **DATE:** 7/30/2024

SCALE: 1" = 150 **PRIOR INSTRUMENT:** #2021-0848206