PARENT PARCEL: 03-00-103-127-010 & 03-00-102-115-005

CHILD PARCEL: N/A — ACREAGE CORRECTION PER ELTON COOPER

STARTING POINT: INTSECTION OF C/L OF RUSSELL AVE & PROJECTION OF NORTH LINE OF GRACE ST

22-04891-C

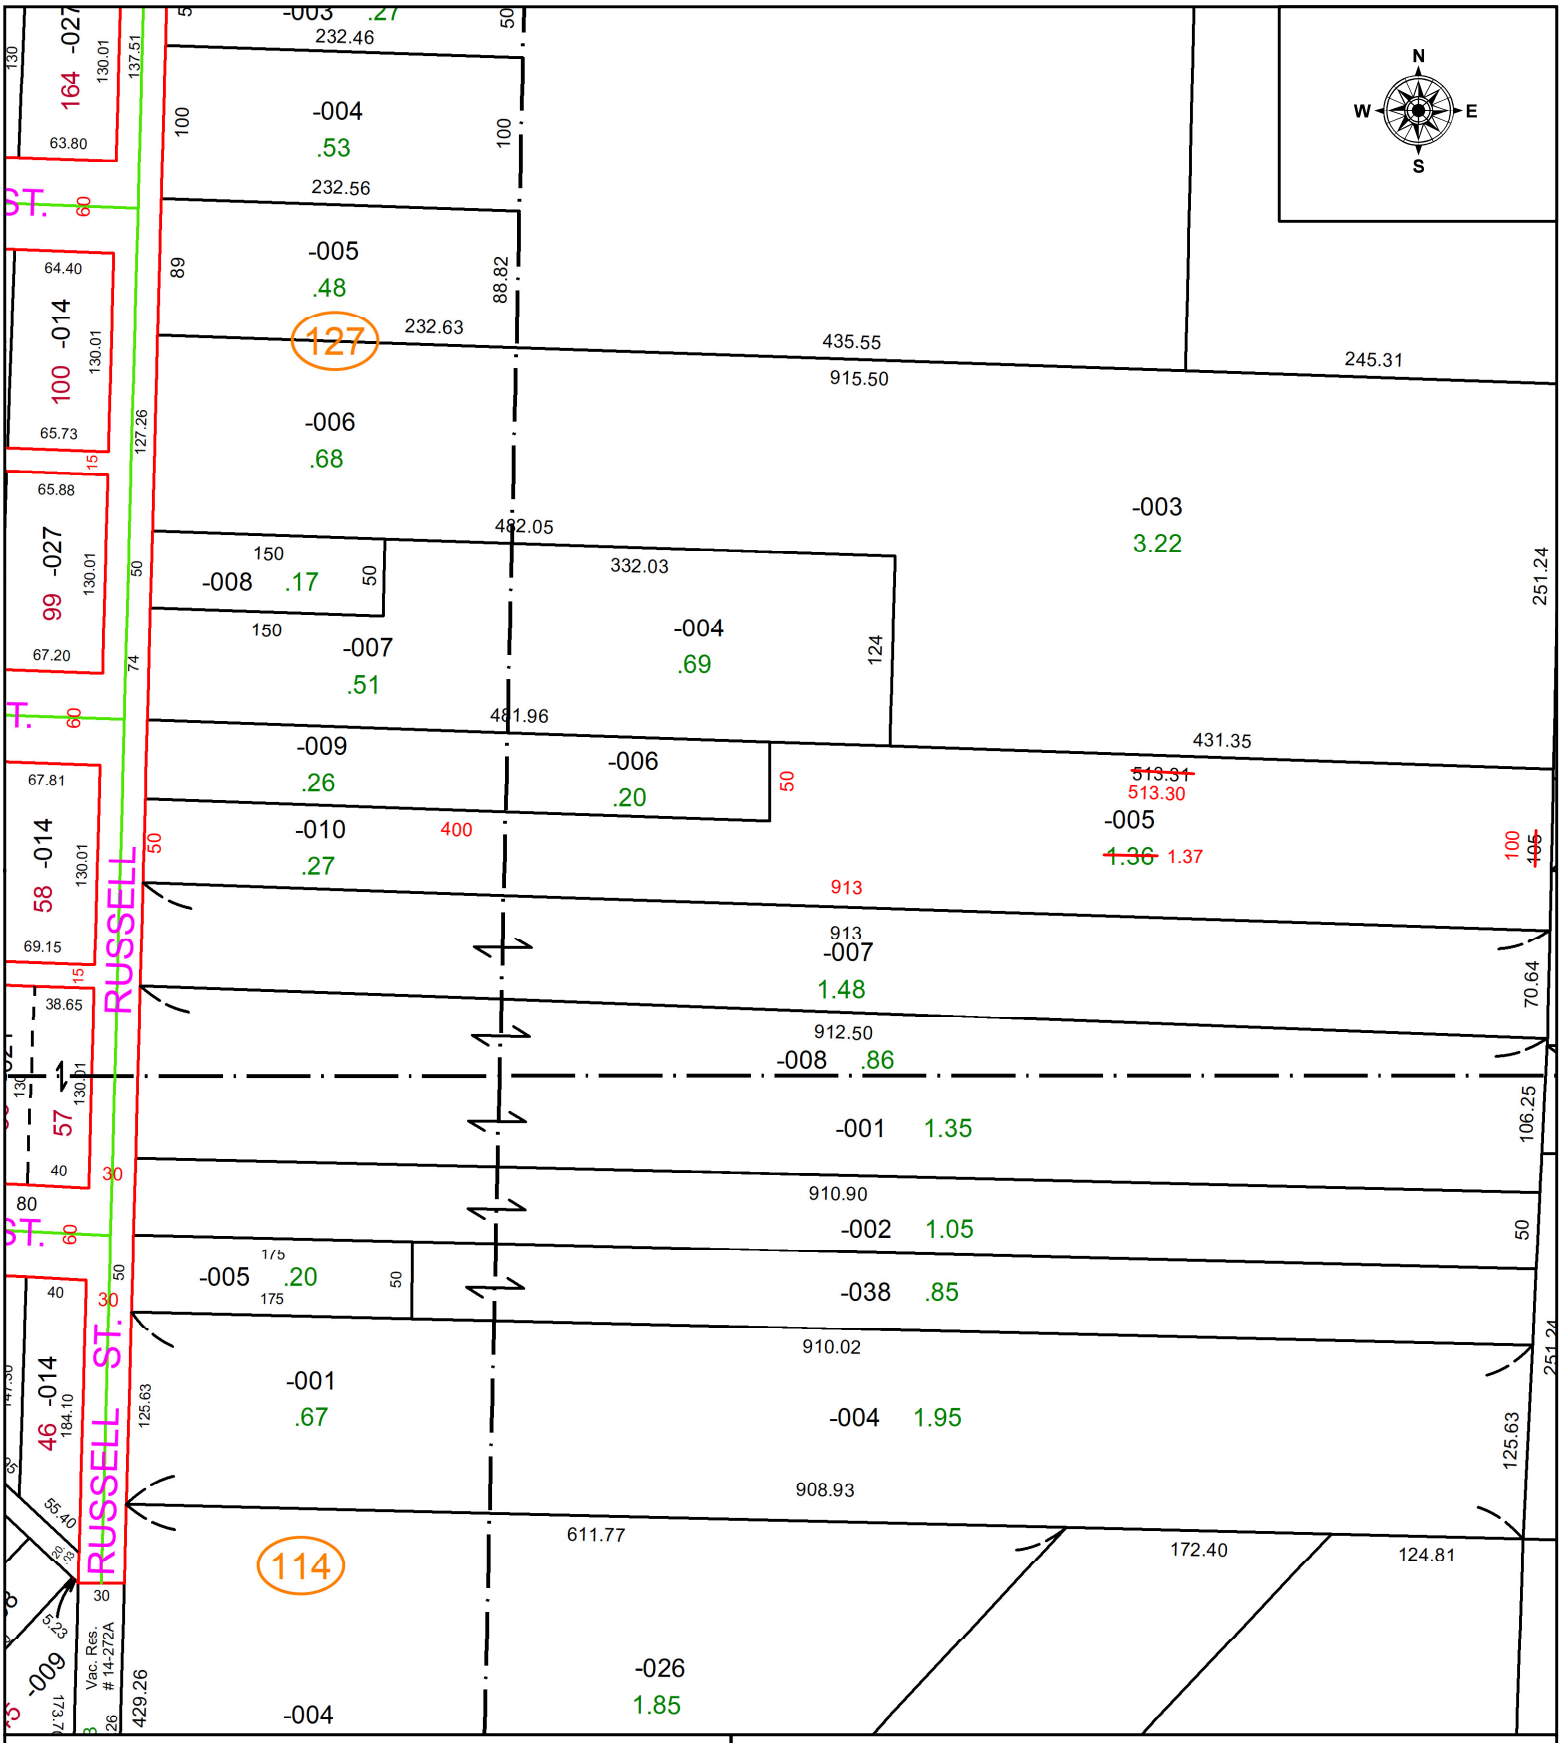

SPLITS/DEEDS PROCESSED

LORAIN COUNTY TAX MAP DEPARTMENT
226 MIDDLE AVE. ELYRIA, OH

SURVEYED BY: ELTON COOPER — SURVEY # 50631

CLOSURE: 1: 499048

MAP PAGE(S): 03-00-102 & 03-00-103

APPOVED BY: WRZ **DATE:** 7/8/2022

SCALE: 1" = 100 **PRIOR INSTRUMENT:** 2021-0834777