PARENT PARCEL: 10-00-005-107-222 & -223

CHILD PARCEL: 10-00-005-107-726 COMBINATION PER PRIOR INSTR. # 2022-0879744

STARTING POINT: WESTERLY LINE OF WYNNE AVE. & S.E. CORNER OF S/L 2 ROBIN PARK SUB. # 1.

22-04893-C

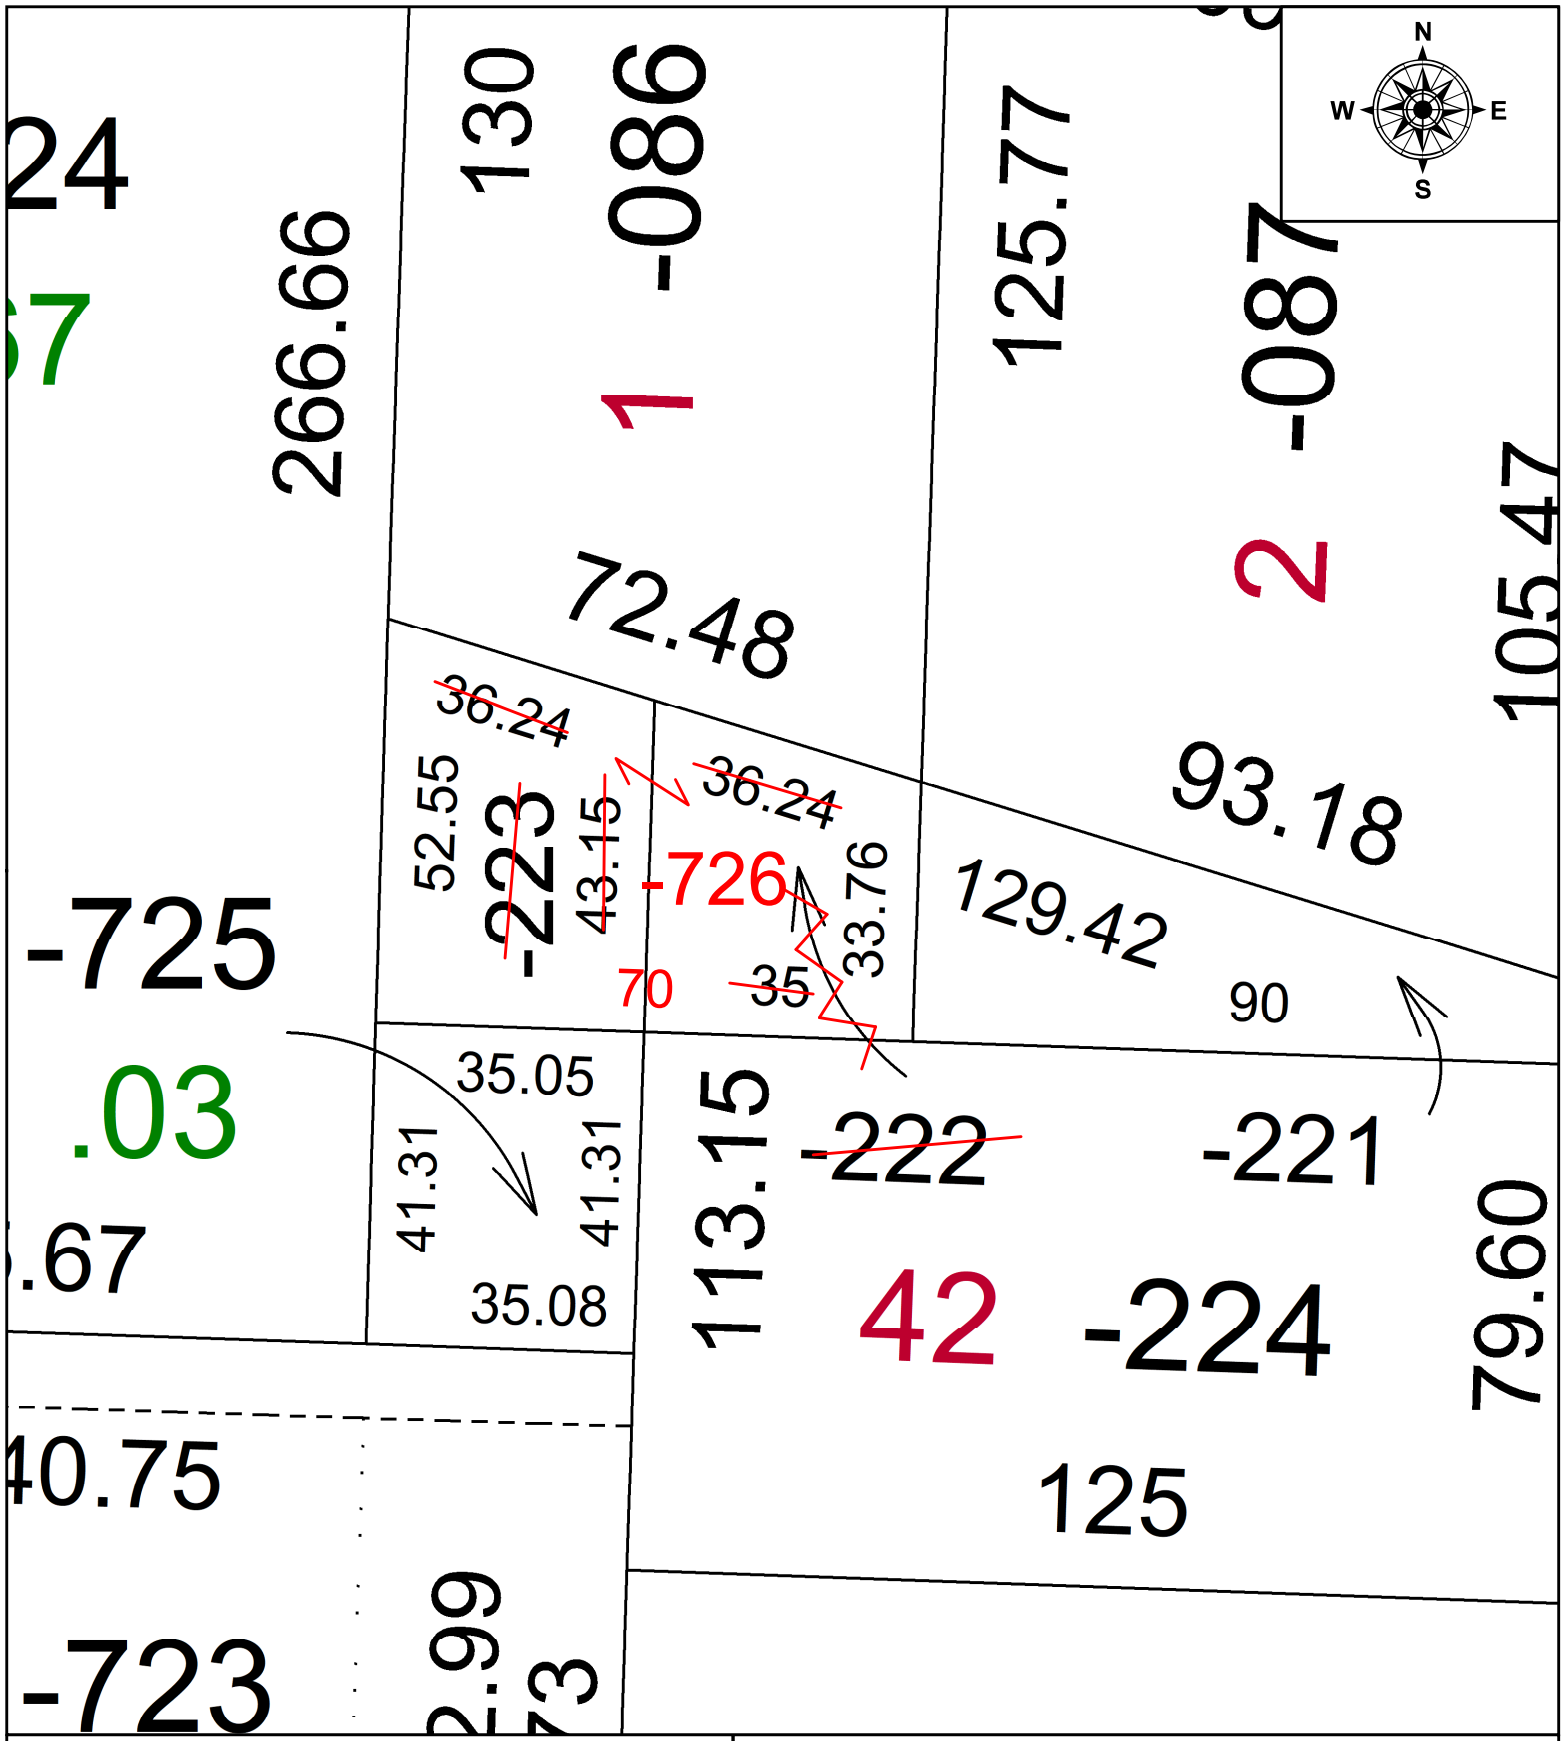

SPLITS/DEEDS PROCESSED

LORAIN COUNTY TAX MAP DEPARTMENT
226 MIDDLE AVE. ELYRIA, OH

SURVEYED BY: RODGER SIMON
CLOSURE: 1:100326
MAP PAGE(S): 10-00-005
APPOVED BY: DMA **DATE:** 7/6/2022
SCALE: 1" = 25' **PRIOR INSTRUMENT:** 2022-0879744