**PARENT PARCEL:** 05-00-037-110-014, -015, & -017 THRU -026

**CHILD PARCEL:** 05-00-037-110-040 AC CORR PER SURVEYOR DANIEL ENGLE

**STARTING POINT:** INTERSECTION OF C/LS OF S. LEAVITT RD & RICE INDUSTRIAL PKWY

# 24-04893

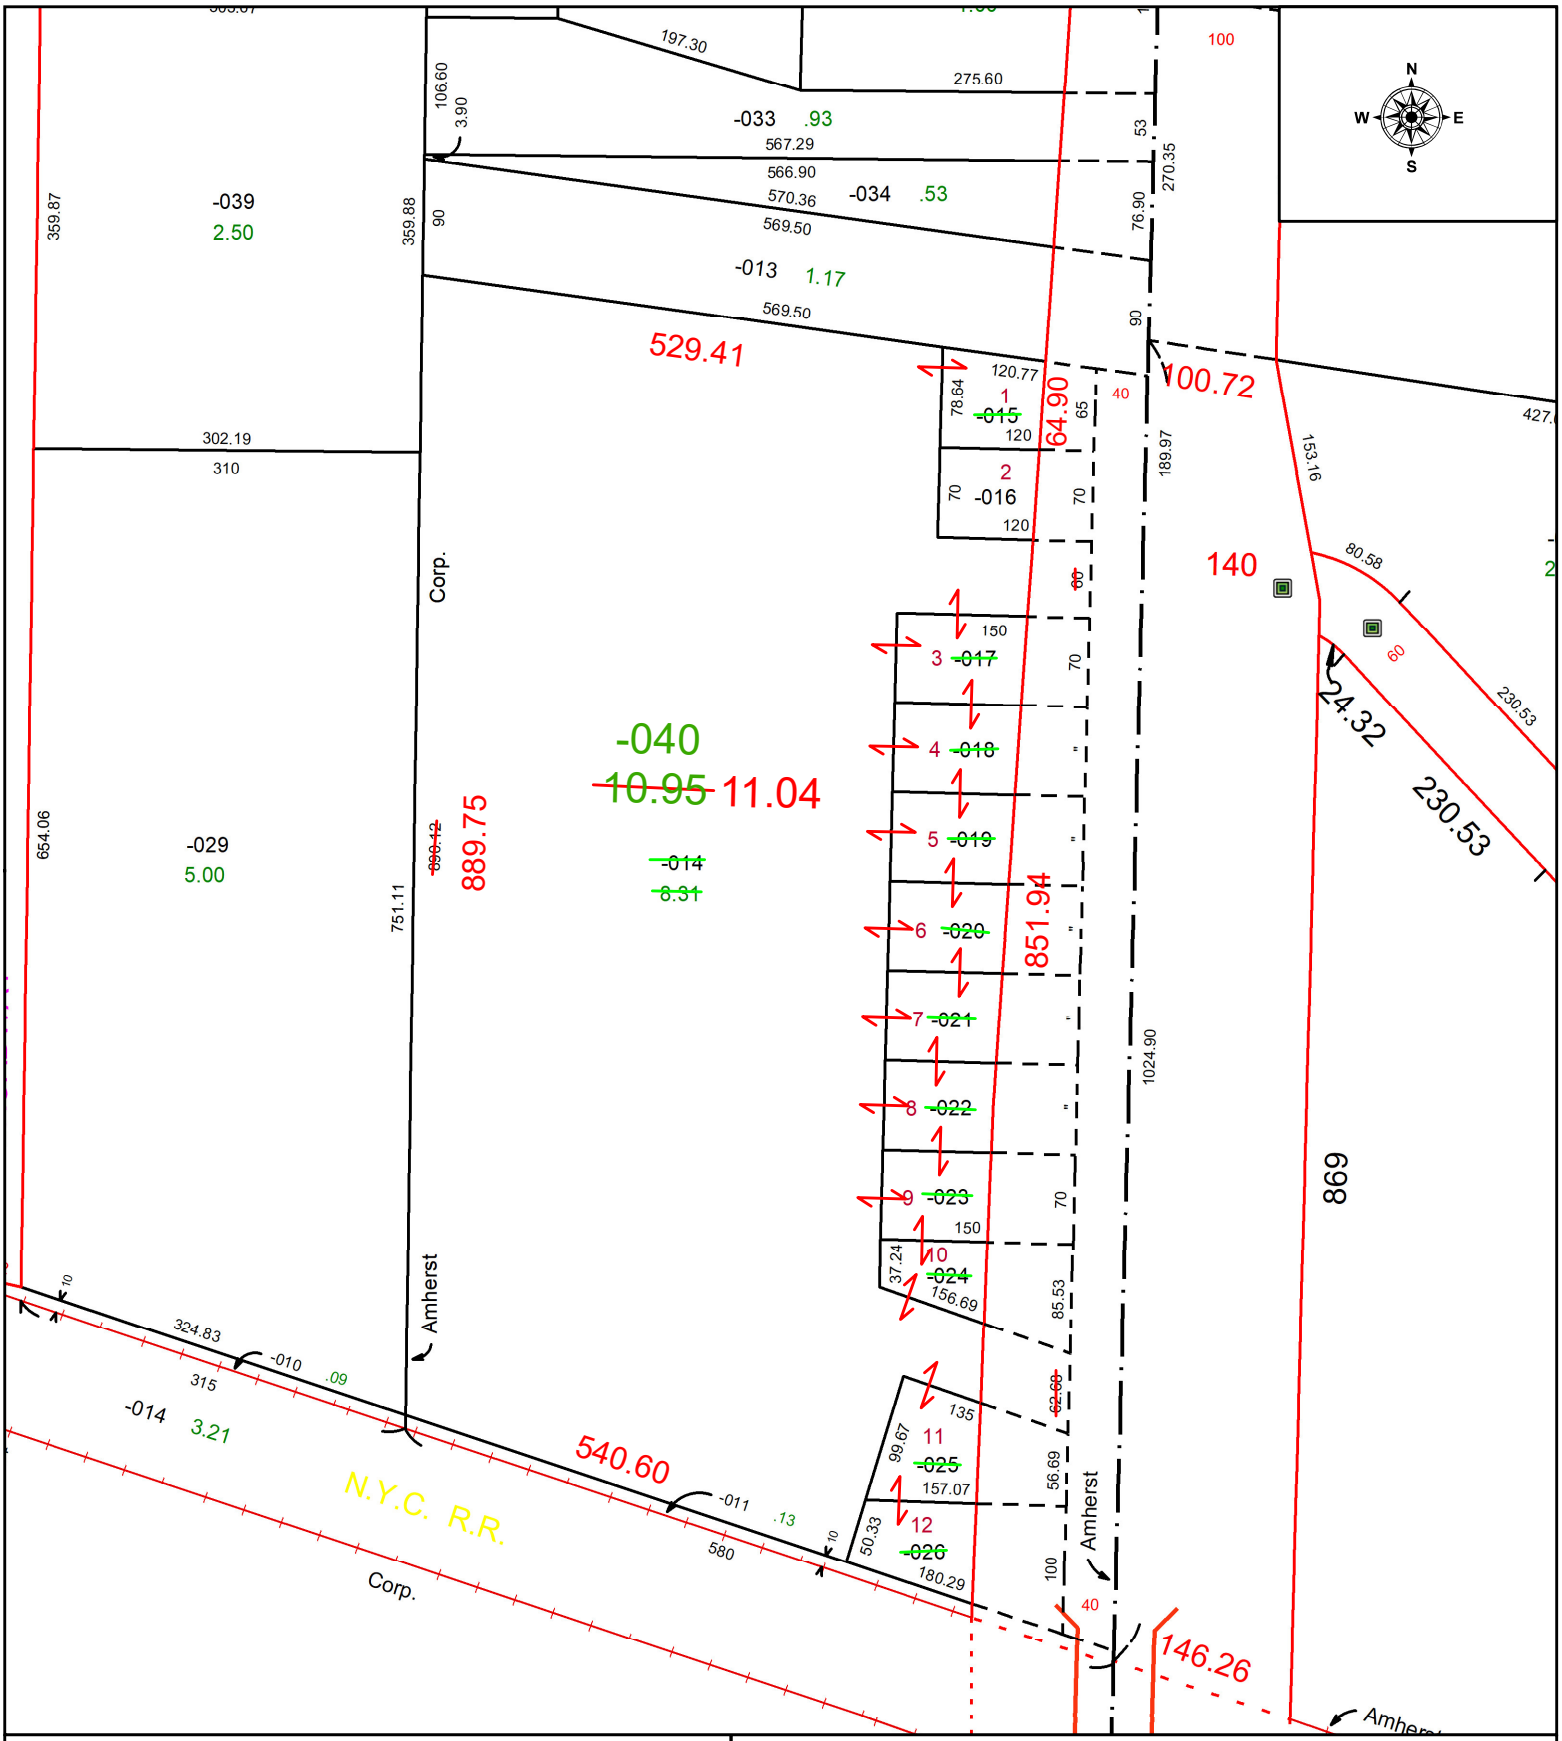


**SPLITS/DEEDS PROCESSED**

LORAIN COUNTY TAX MAP DEPARTMENT
226 MIDDLE AVE. ELYRIA, OH

**SURVEYED BY:** DANIEL ENGLE SURVEY # 51268

**CLOSURE:** 1: 469398

**MAP PAGE(S):** 05-00-037

**APPOVED BY:** WRZ **DATE:** 9/6/2024

**SCALE:** 1" = 150 **PRIOR INSTRUMENT:** #2007-0219658