PARENT PARCEL: 19-02-029-000-045

CHILD PARCEL: 19-02-029-000-047,-048,-049 and 19-02-030-000-060, -061

STARTING POINT: INSTERSECTION C/L OF SOOY RD AND JONES RD

24-04894

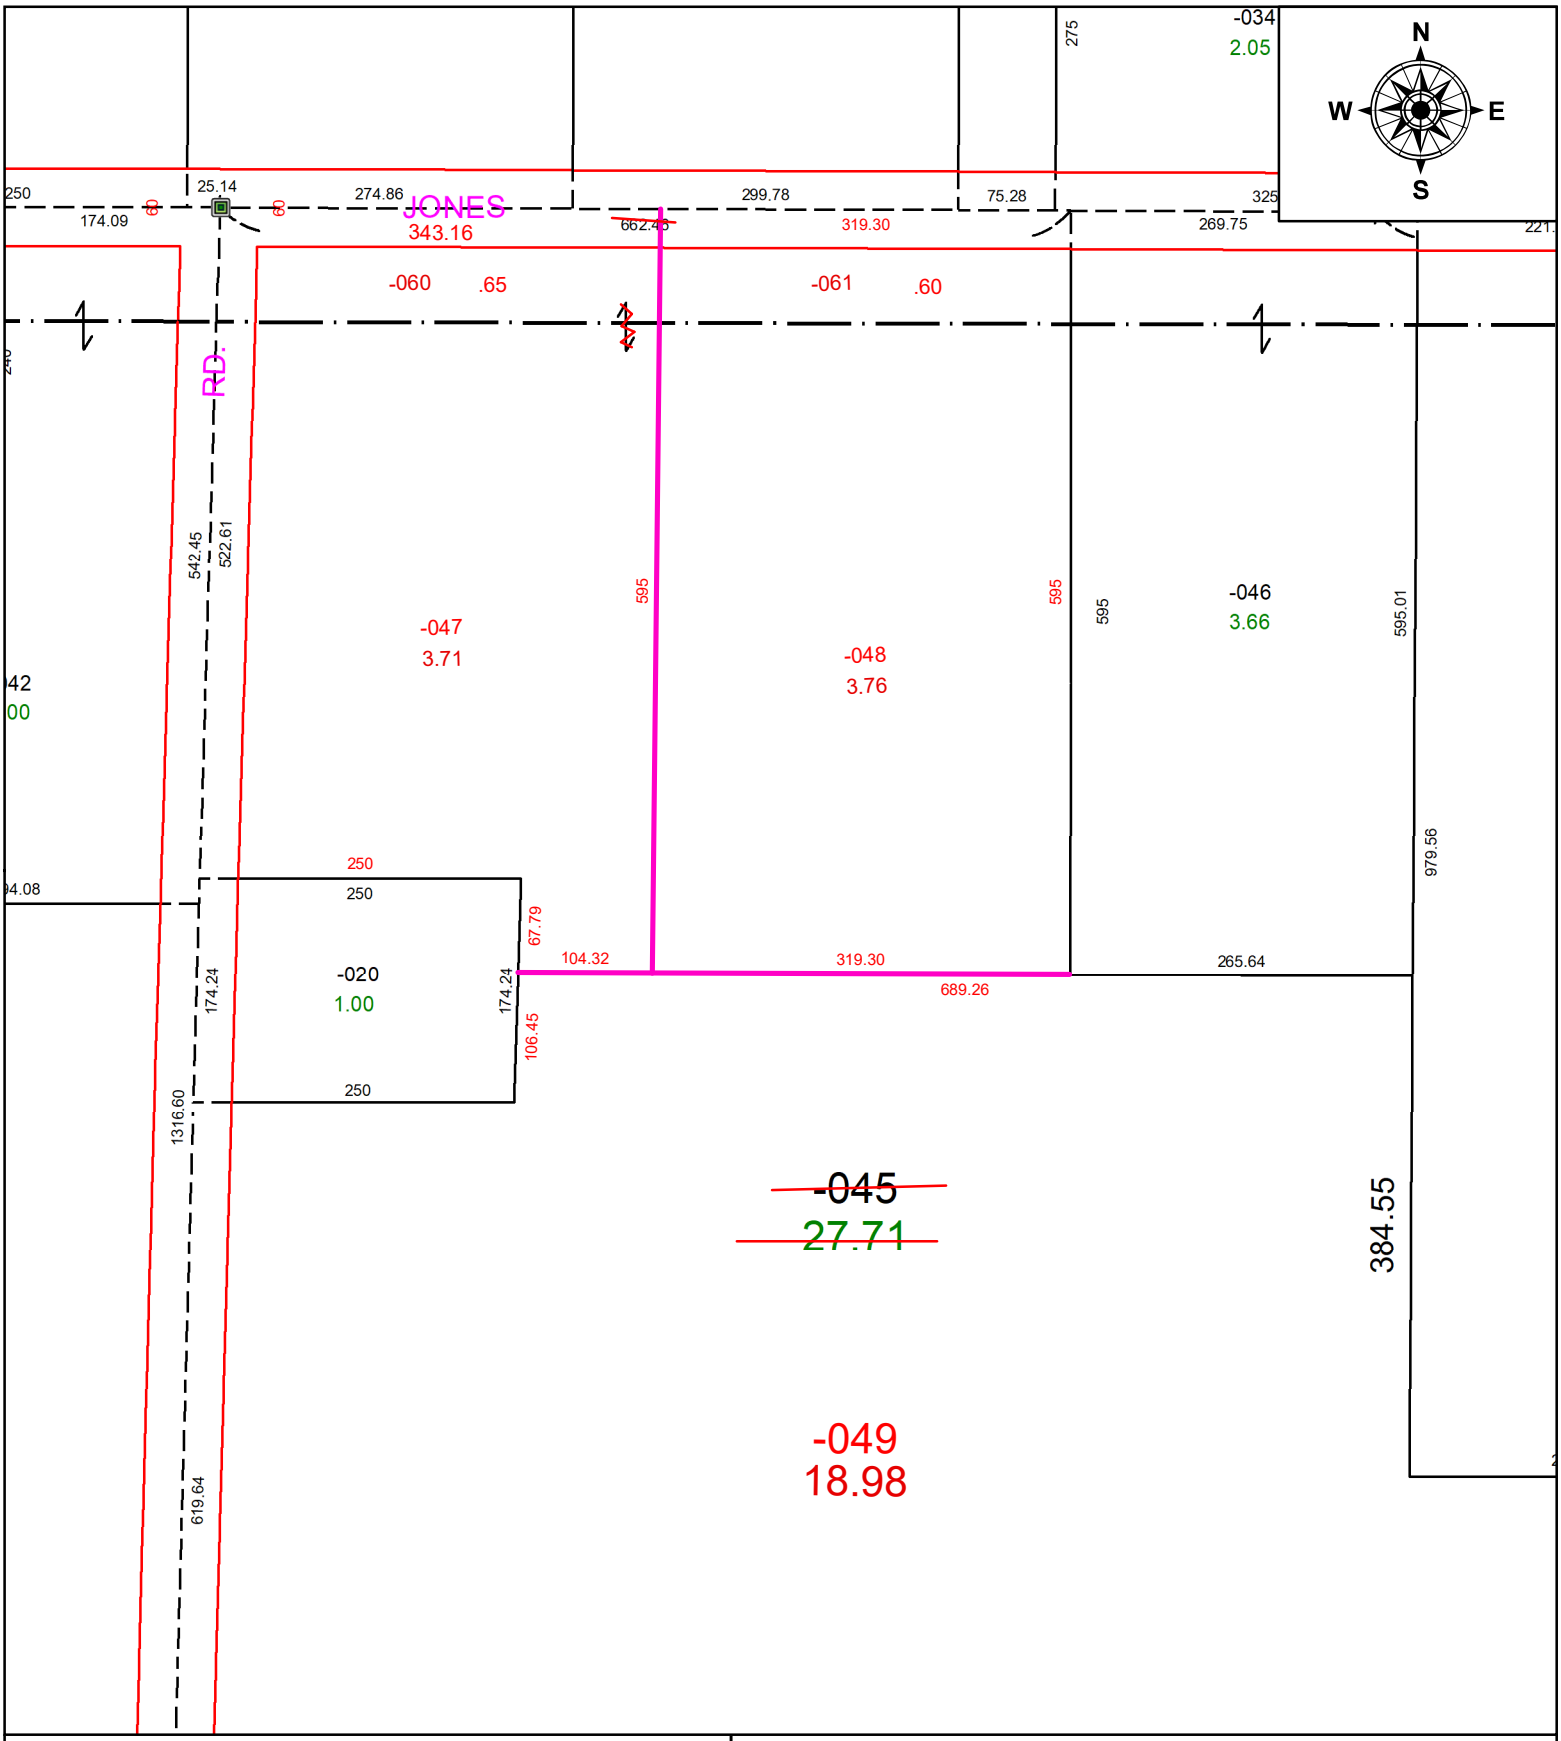

SPLITS/DEEDS PROCESSED

LORAIN COUNTY TAX MAP DEPARTMENT
226 MIDDLE AVE. ELYRIA, OH

SURVEYED BY: JAMES A. COTTRELL **SURVEY #:** 51254
CLOSURE: 1:792298
MAP PAGE(S): 1902029 AND 1902030
APPOVED BY: BB **DATE:** 8/20/2024
SCALE: 1" = 25' **PRIOR INSTRUMENT:** #20190741907