PARENT PARCEL: 03-00-113-106-049, -050, & -051

CHILD PARCEL: 03-00-113-106-063 & -064

STARTING POINT: NORTHEAST CORNER OF S/L 74 IN HILL'S ALLOTMENT

24-04895

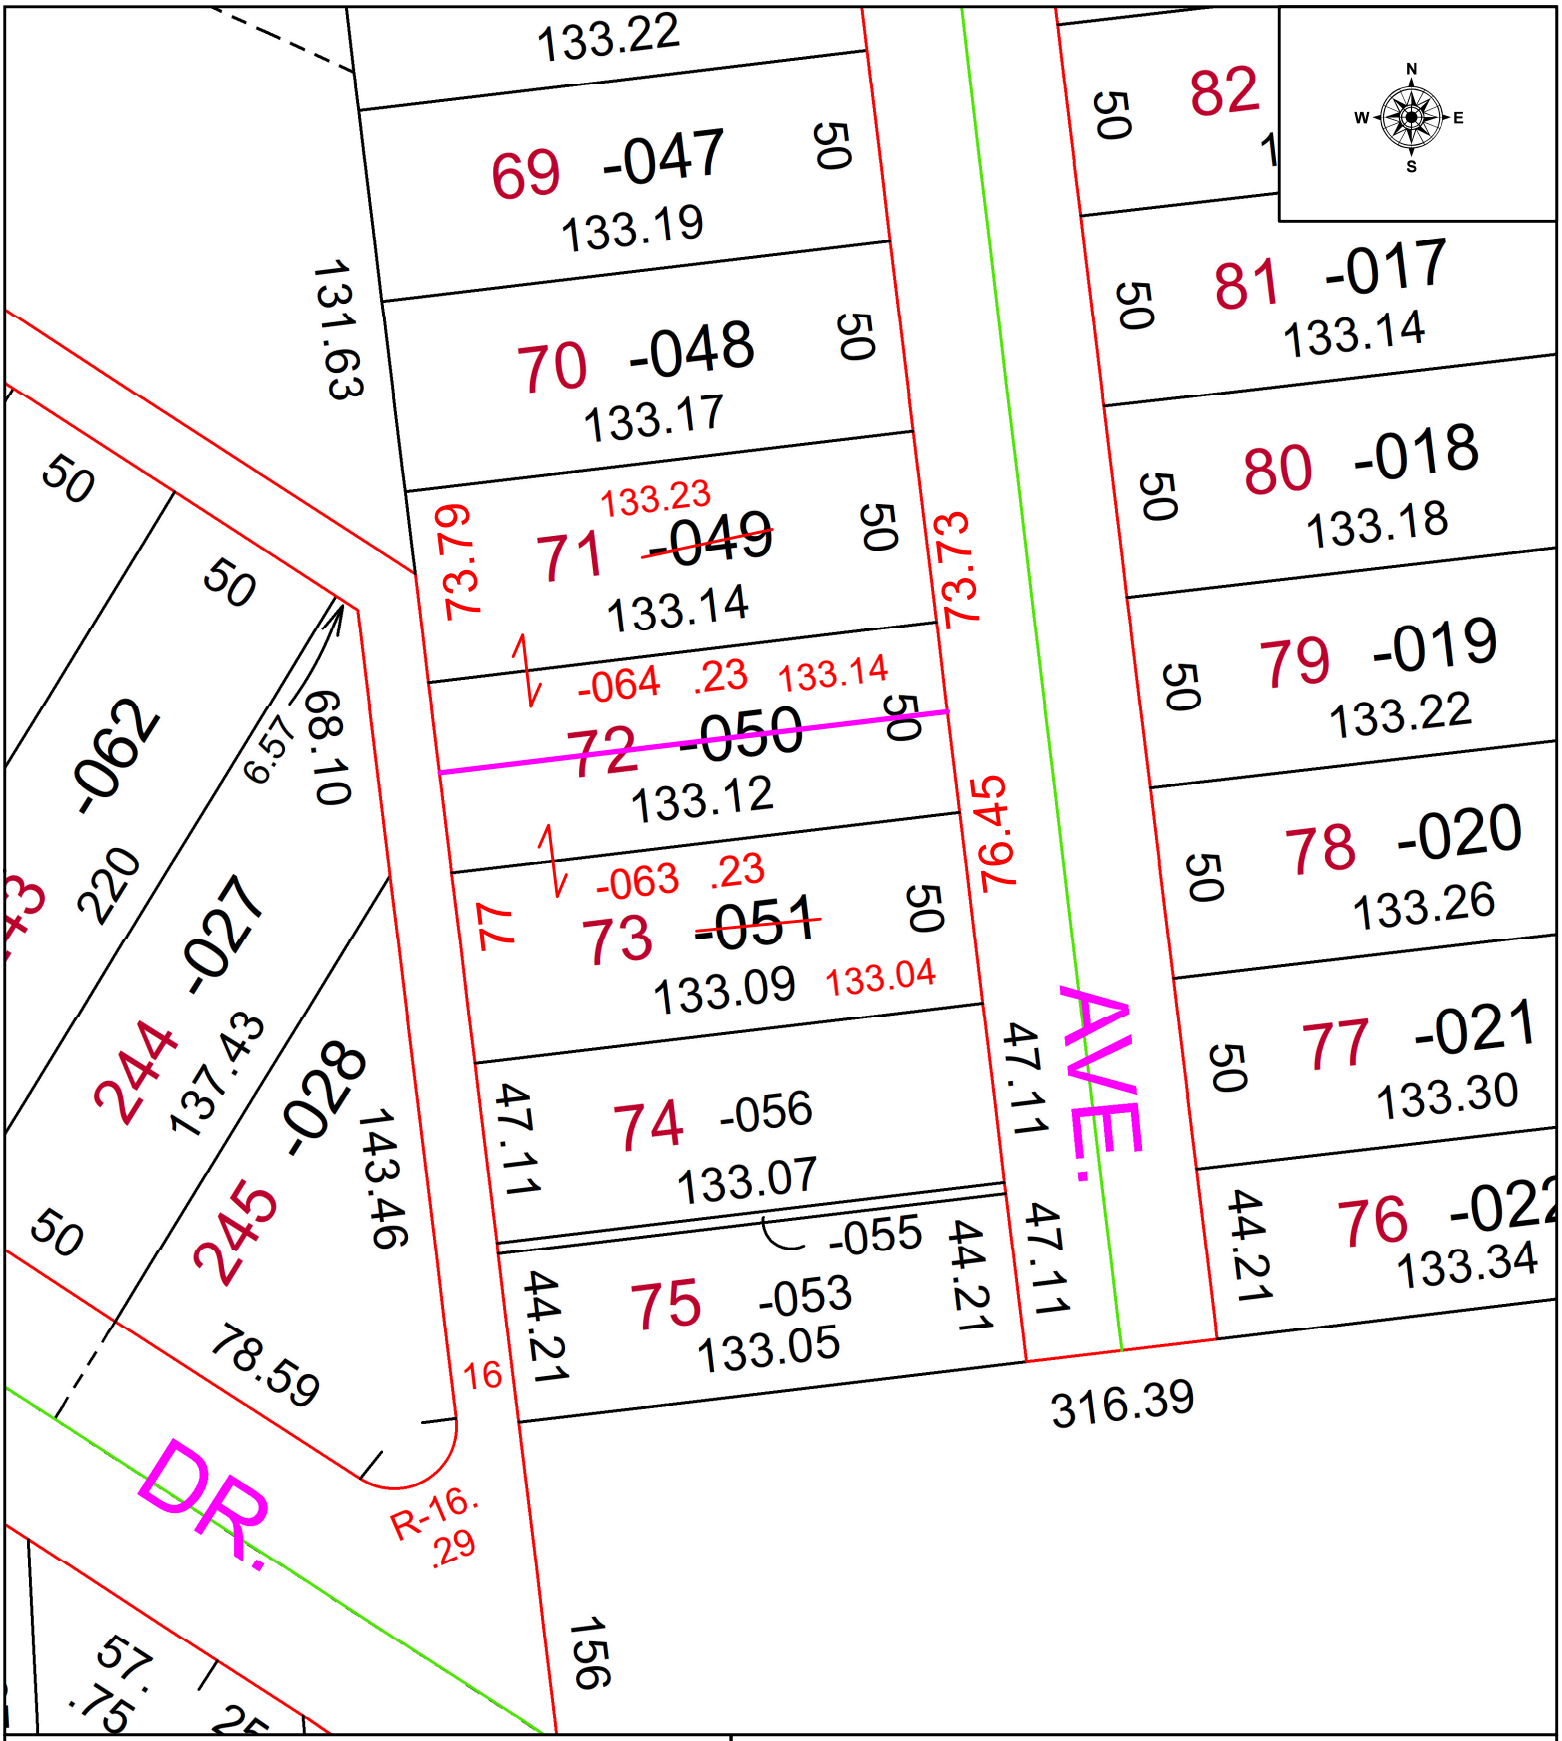

SPLITS/DEEDS PROCESSED

LORAIN COUNTY TAX MAP DEPARTMENT
226 MIDDLE AVE. ELYRIA, OH

SURVEYED BY: ADAM WEAVER SURVEY # 51255

CLOSURE: 1: 55563

MAP PAGE(S): 03-00-113

APPOVED BY: WRZ **DATE:** 8/21/2024

SCALE: 1" = 50 **PRIOR INSTRUMENT:** #2014-0511534