PARENT PARCEL: 01-00-070-000-016, 01-00-071-000-005, -015, 01-00-074-000-001

CHILD PARCEL: N/A ACREAGE CORRECTION PER MATTHEW HILDEBRANDT

STARTING POINT: MONUMENT BOX @ INTERSECTION OF SOUTHERLY LINE OF O.L. 71 & C/L OF BAUMHART RD

22-04913-D

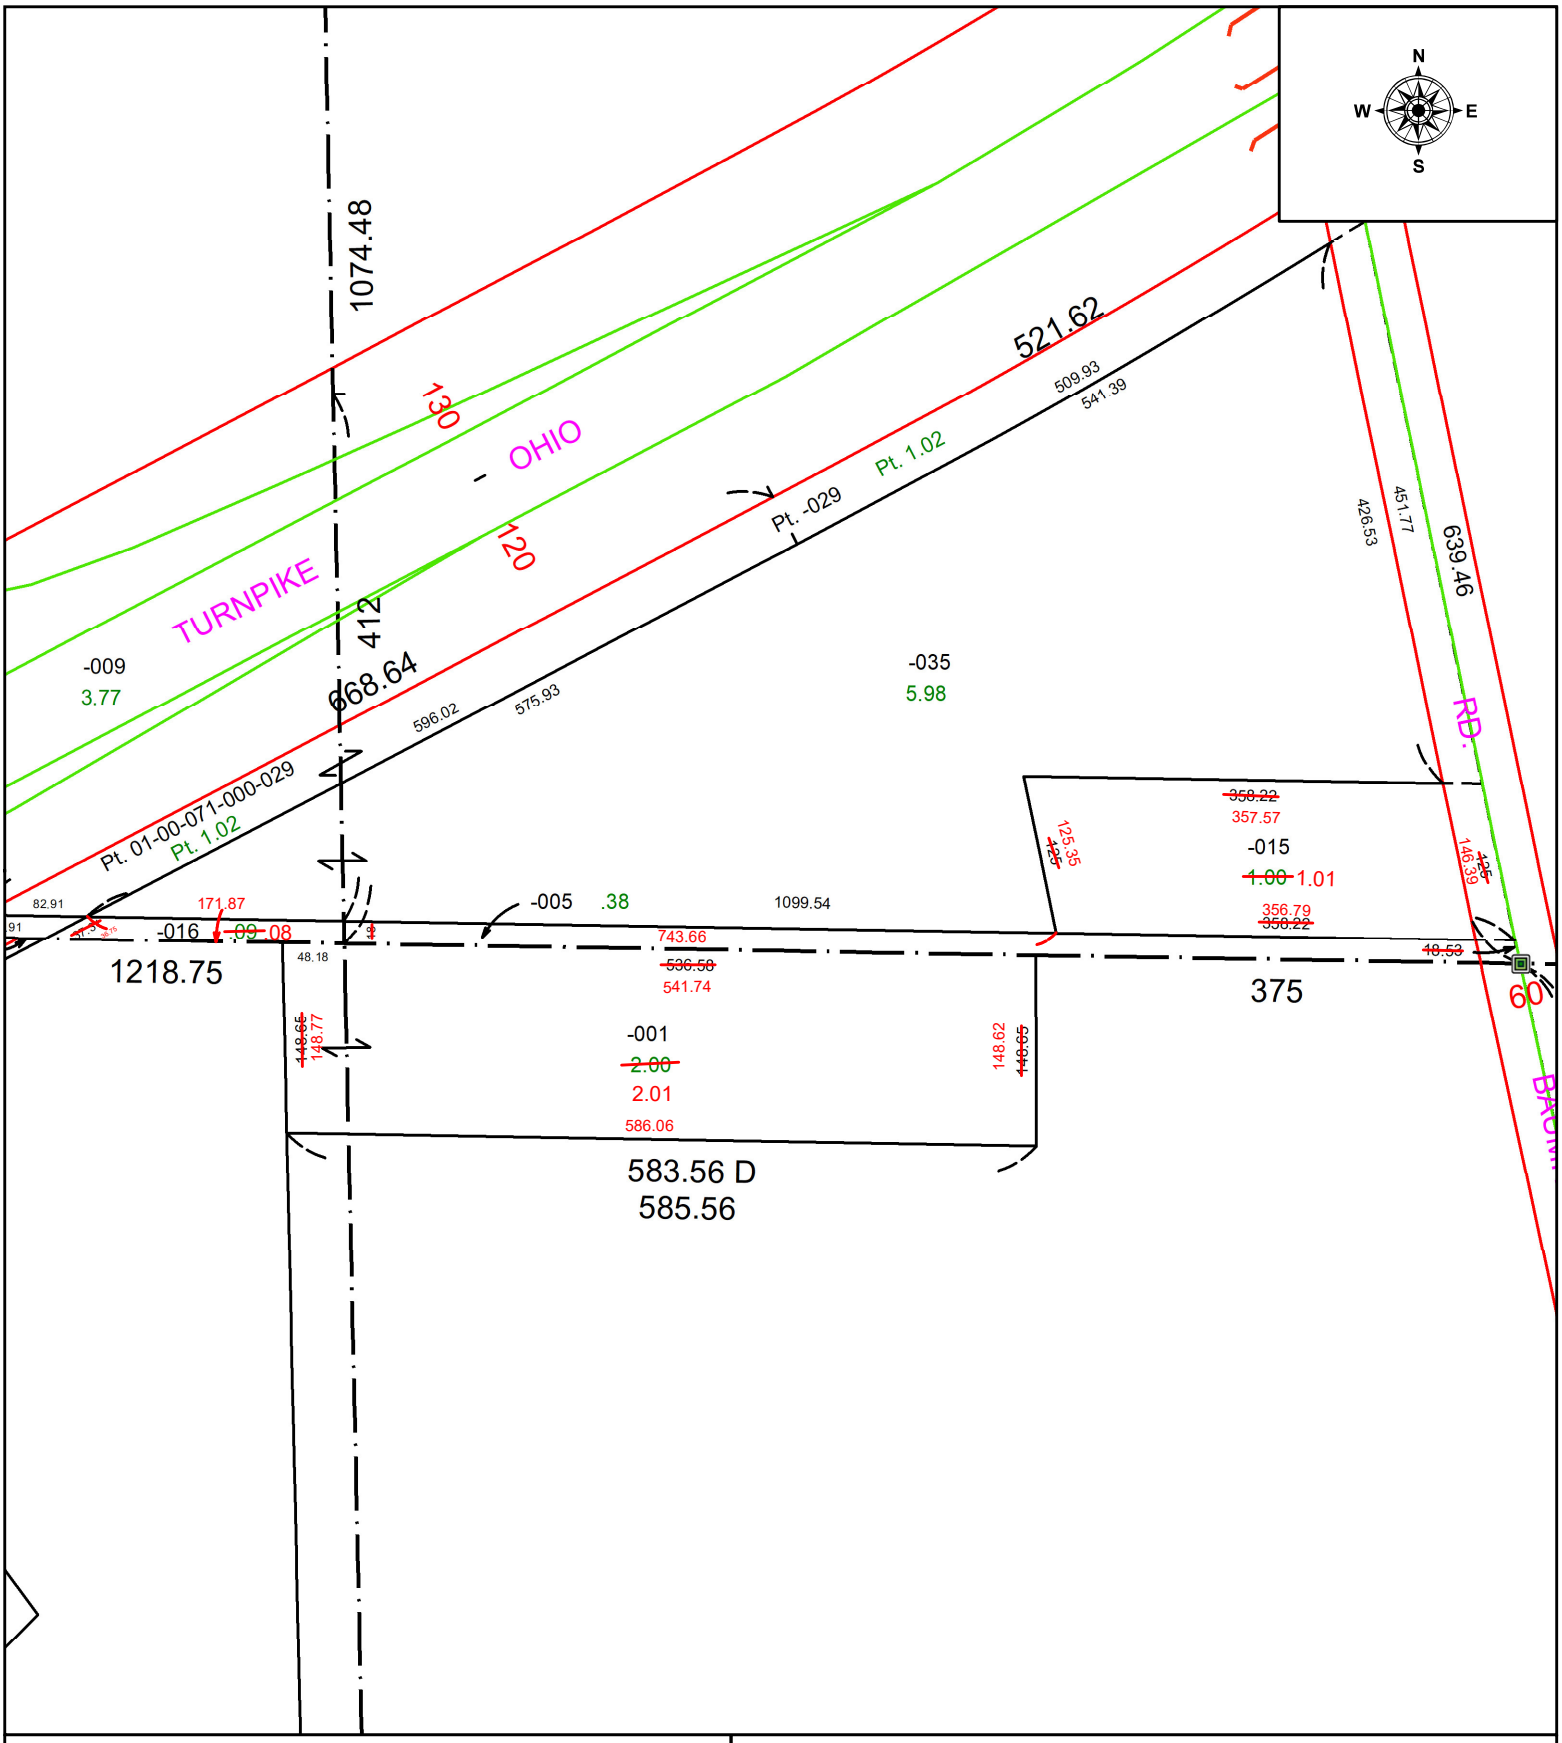

SPLITS/DEEDS PROCESSED

LORAIN COUNTY TAX MAP DEPARTMENT
226 MIDDLE AVE. ELYRIA, OH

SURVEYED BY: MATTHEW HILDEBRANDT SURVEY # 50664

CLOSURE: 1:453147

MAP PAGE(S): 01-00-070, 01-00-071, & 01-00-074

APPOVED BY: WRZ **DATE:** 8/8/2022

SCALE: 1" = 150 **PRIOR INSTRUMENT:** 2022-0870205