PARENT PARCEL: 04-00-030-108-016 & -017

CHILD PARCEL: 04-00-030-108-028

STARTING POINT: FRONT & DEPTH TO AC CORR PER SURV BY ROBERT M. RUFFING

24-04913

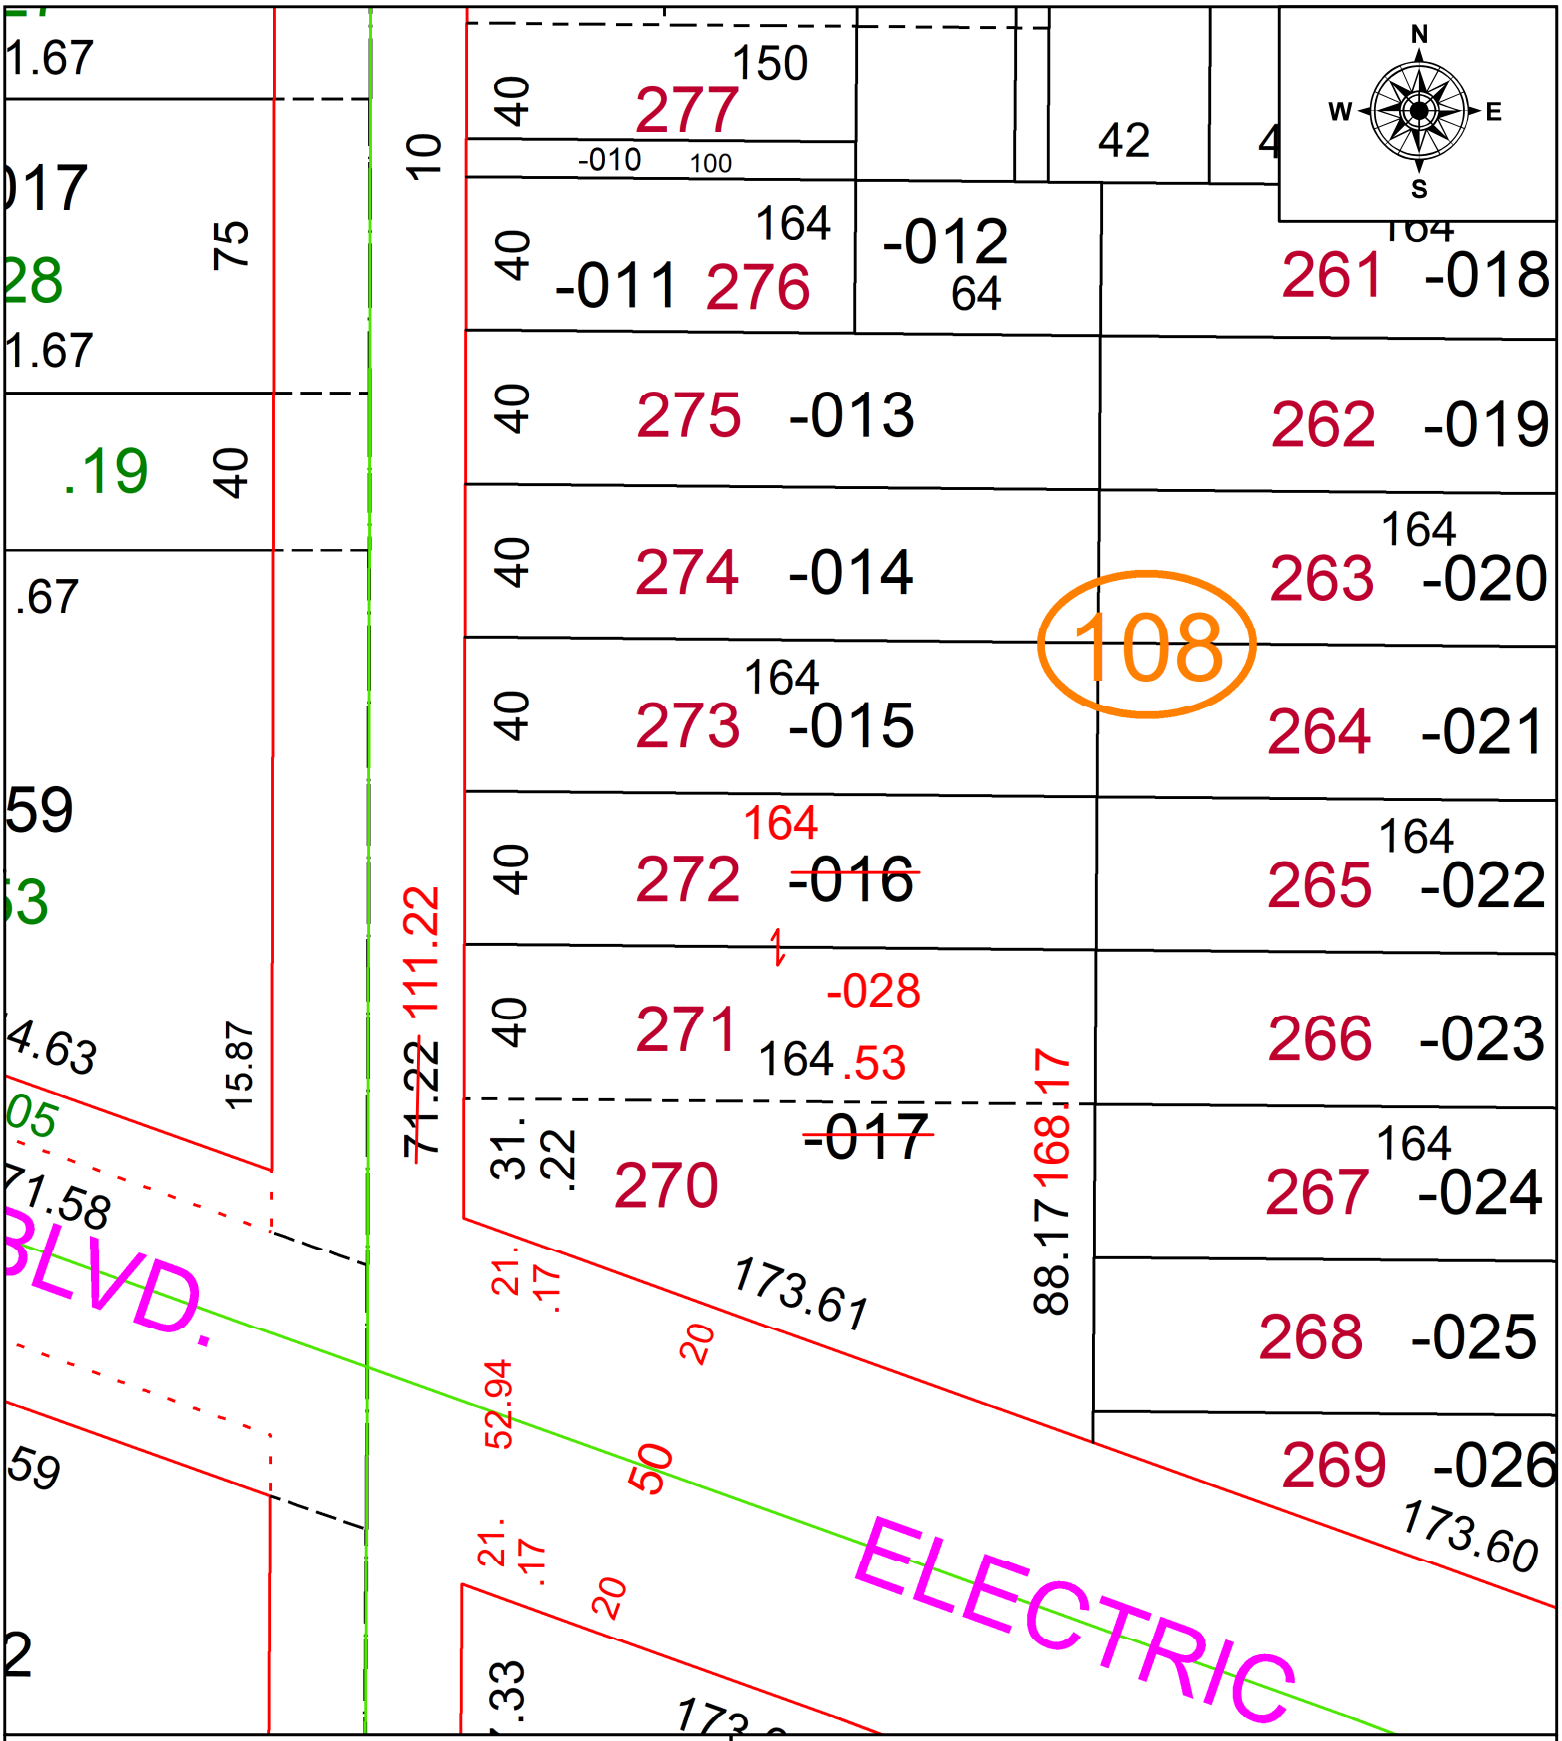

SPLITS/DEEDS PROCESSED

LORAIN COUNTY TAX MAP DEPARTMENT
226 MIDDLE AVE. ELYRIA, OH

SURVEYED BY: ROBERT M. RUFFING **SURV # 51281**

CLOSURE: 1: 188268

MAP PAGE(S): 04-00-030

APPOVED BY: AC **DATE:** September 20, 2024

SCALE: 1 in = 50 ft **PRIOR INSTRUMENT:** 2022- 0871562