PARENT PARCEL: 03-00-057-112-002 & 03-00-058-102-033

CHILD PARCEL: 03-00-057-112-025, -026, 03-00-058-102-034, -035, & -036

STARTING POINT: AC CORR PER SURV BY MICHAEL P. SPELLACY

24-04921

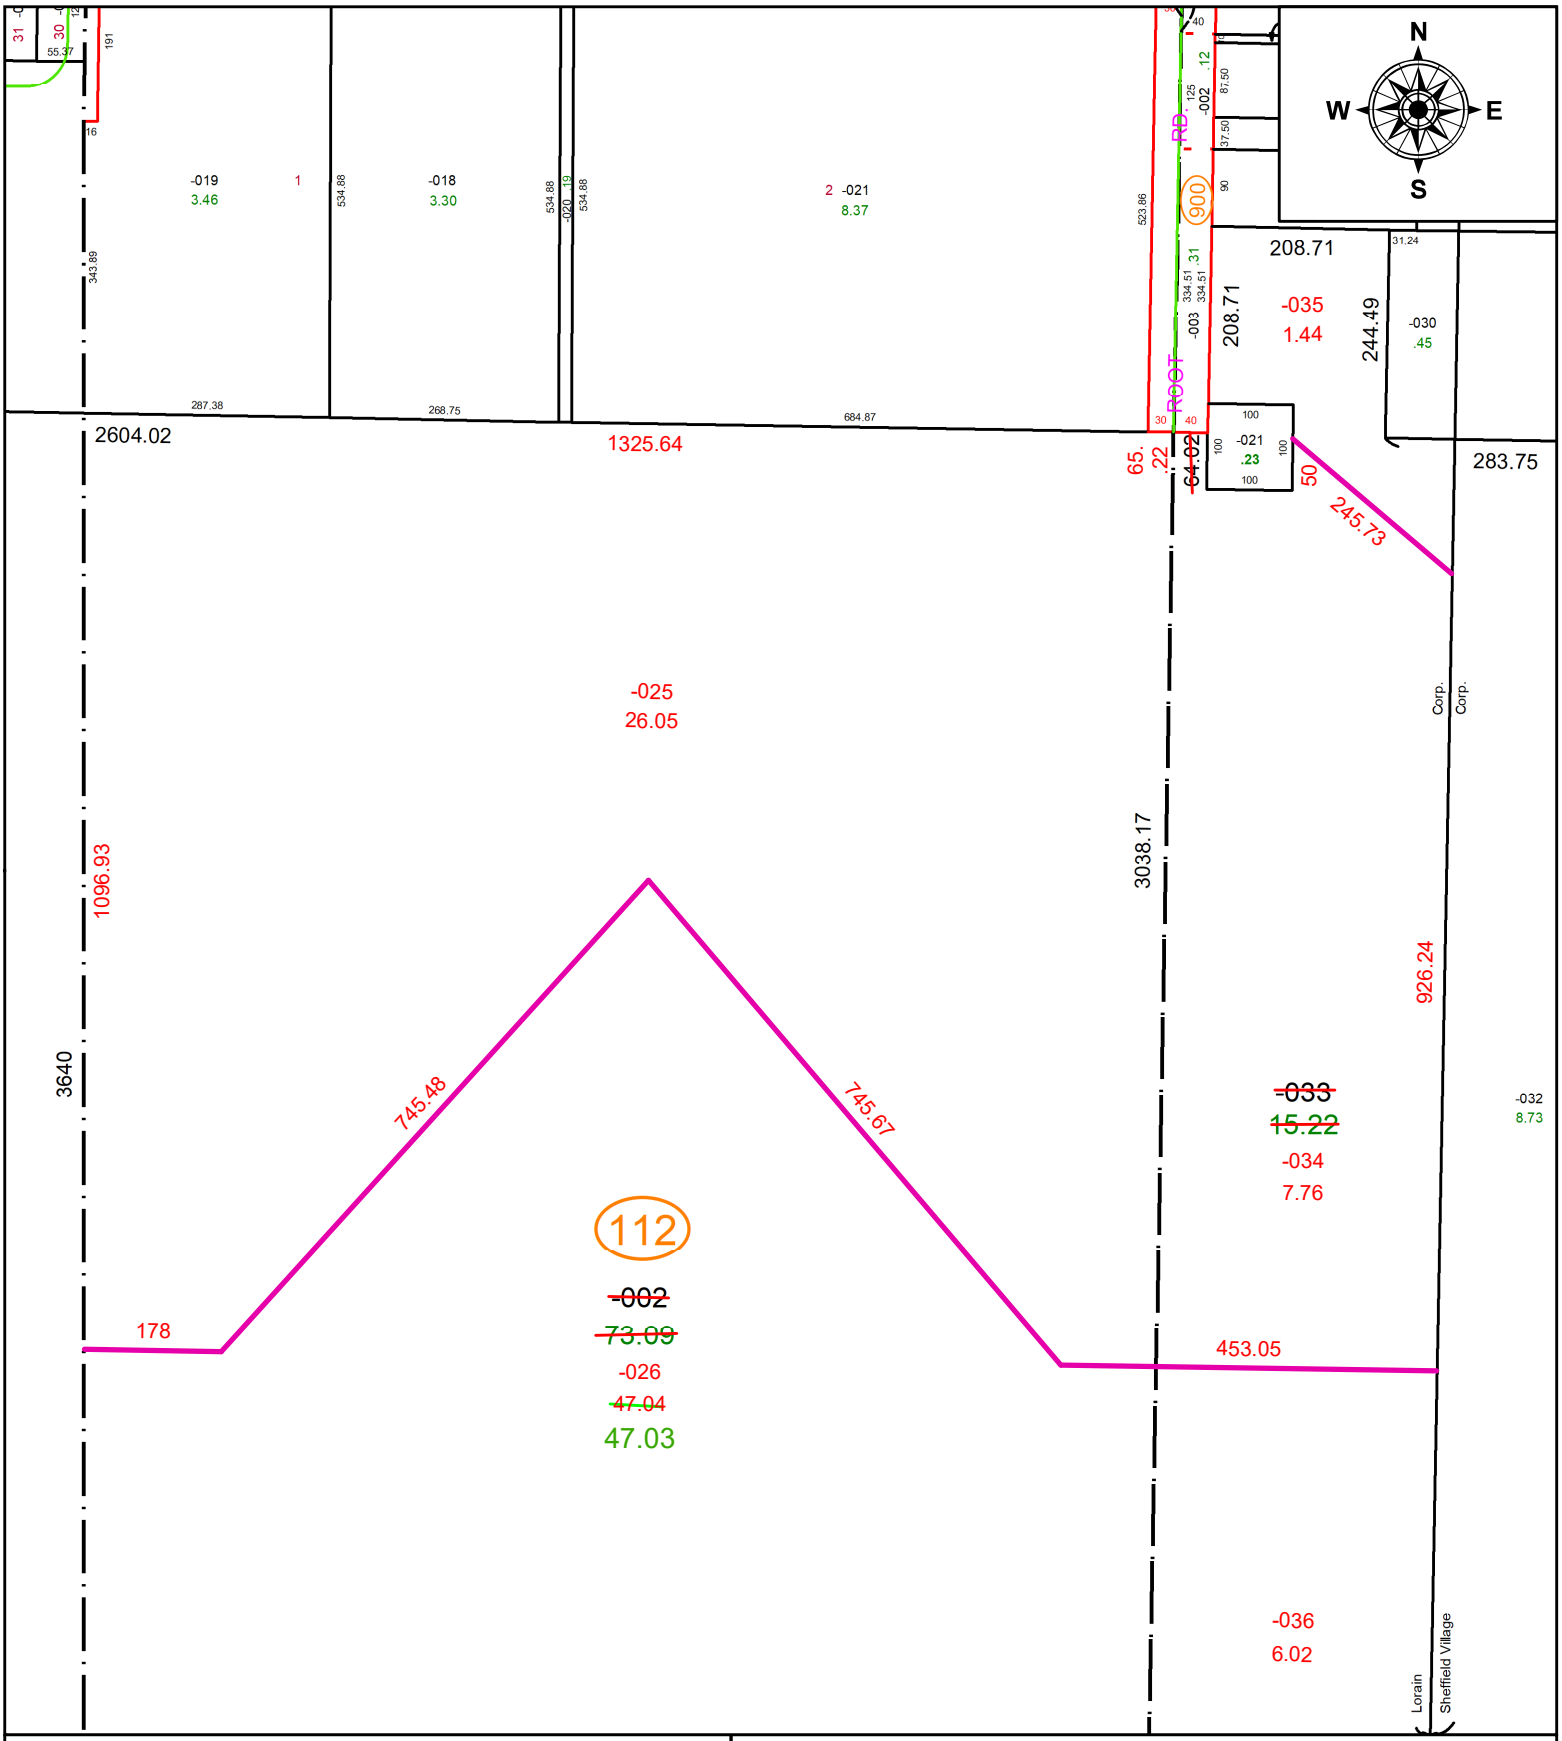

SPLITS/DEEDS PROCESSED

LORAIN COUNTY TAX MAP DEPARTMENT
226 MIDDLE AVE. ELYRIA, OH

SURVEYED BY: MICHAEL P. SPELLACY **SURV # 51297**

CLOSURE: 1: 447587

MAP PAGE(S): 03-00-057

APPOVED BY: AC **DATE:** October 08, 2024

SCALE: 1 in = 225 ft **PRIOR INSTRUMENT:** 2023- 0923160