PARENT PARCEL: 12-00-086-000-019

CHILD PARCEL: AC. CORR. PER SURVEY SCOTT ENGLAND

STARTING POINT: S.W. CORNER OF O.L 86

22-04922-A

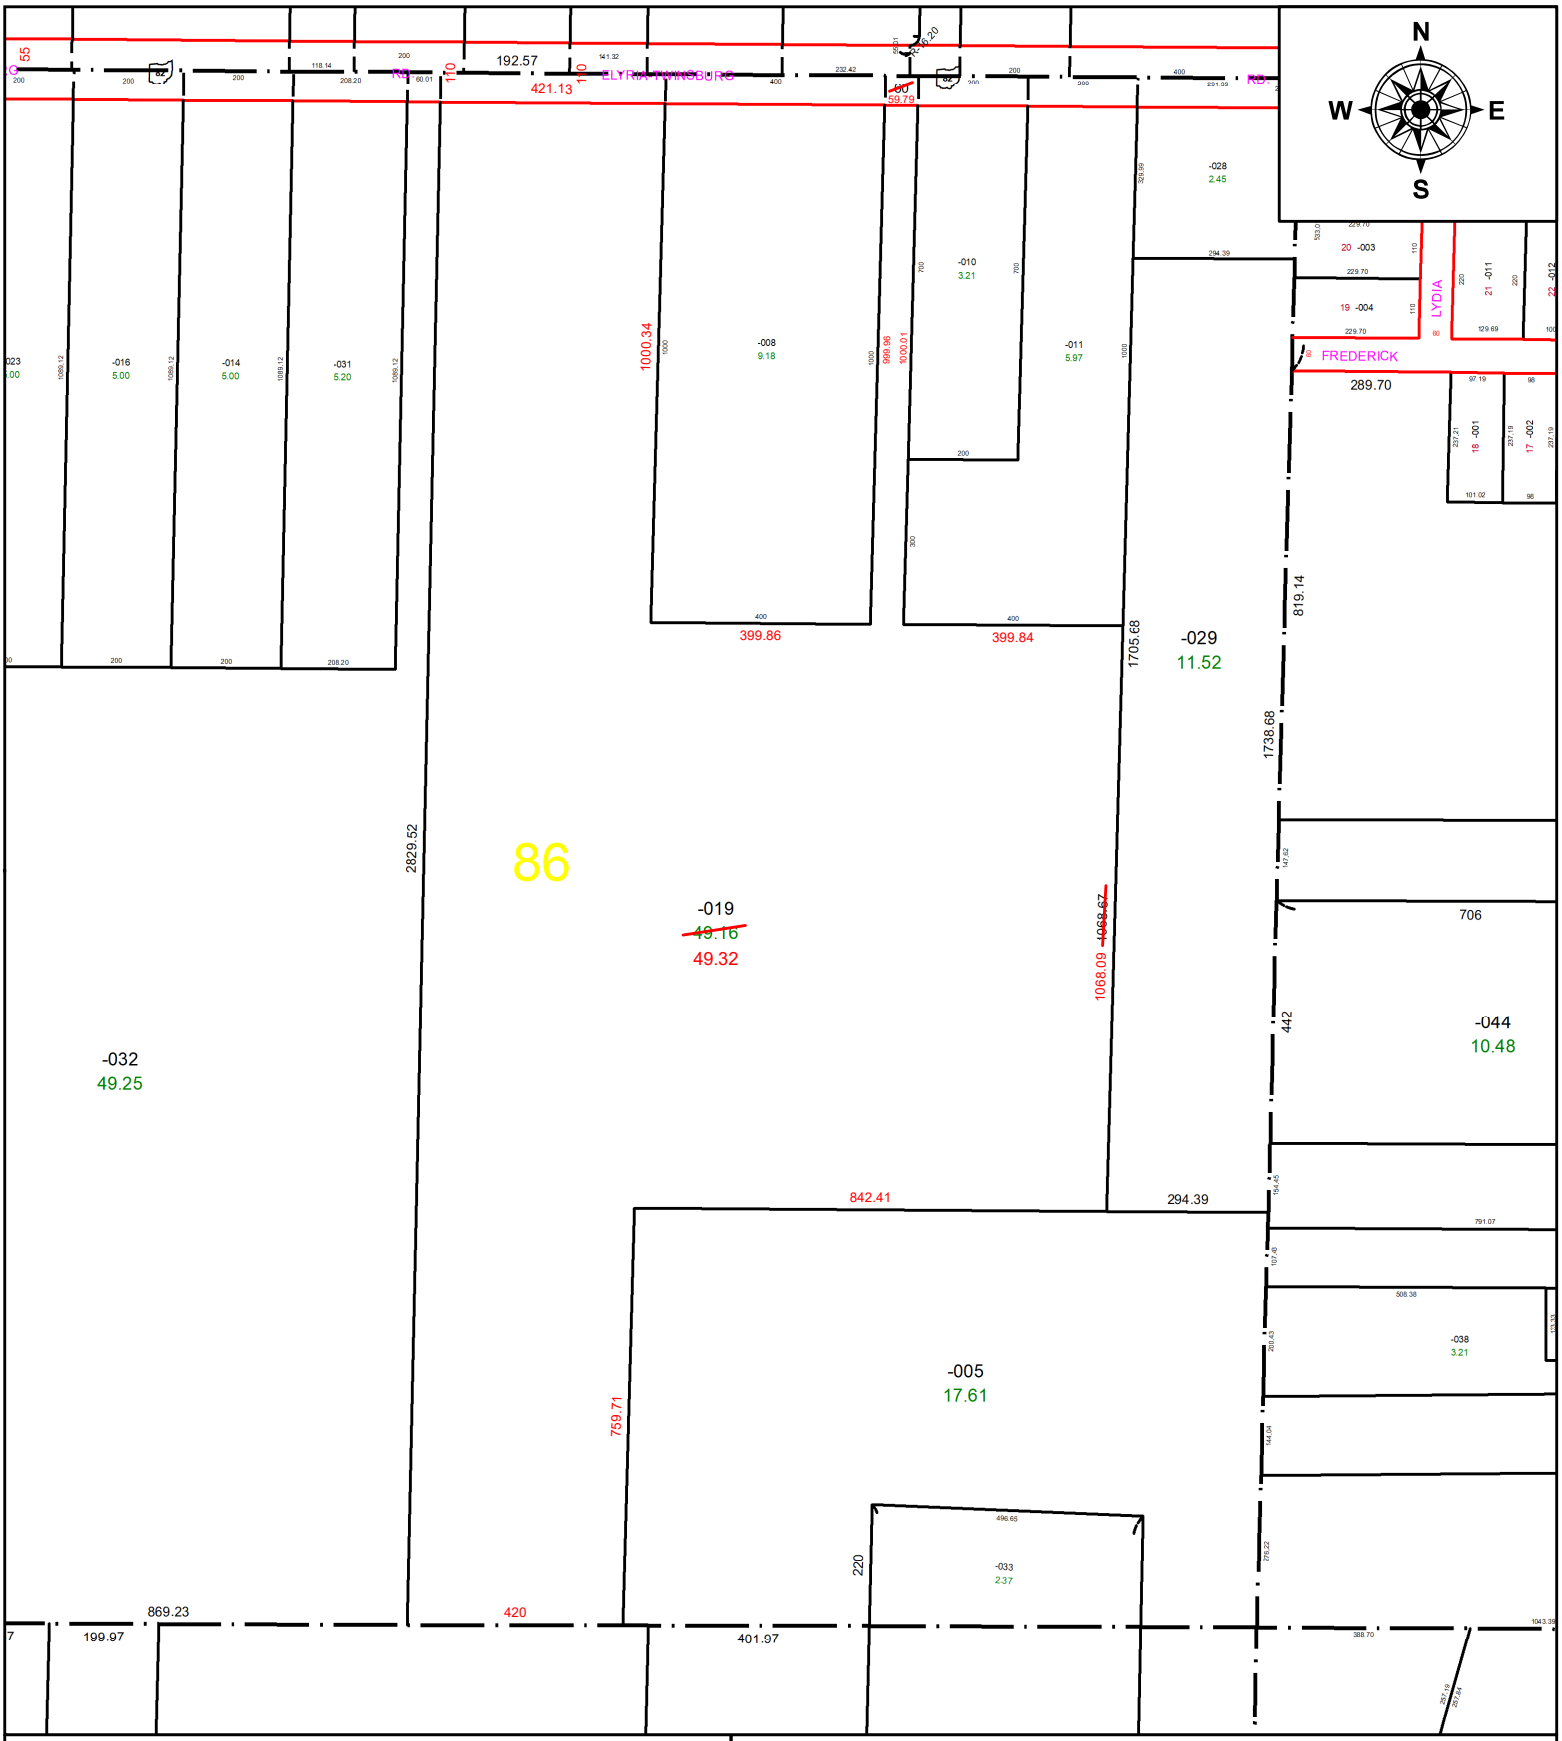

SPLITS/DEEDS PROCESSED

LORAIN COUNTY TAX MAP DEPARTMENT
226 MIDDLE AVE. ELYRIA, OH

SURVEYED BY: SCOTT ENGLAND **SURVEY #:** 50660

CLOSURE: 1:101473

MAP PAGE(S): 12-00-086

APPOVED BY: DMA **DATE:** 8/3/2022

SCALE: 1" = 350' **PRIOR INSTRUMENT:** 2022-0860554