PARENT PARCEL: 05-00-019-000-026
CHILD PARCEL: AC. CORR. PER PRIOR INSTRUMENT # 2021-085325
STARTING POINT: N/A

22-04924-A

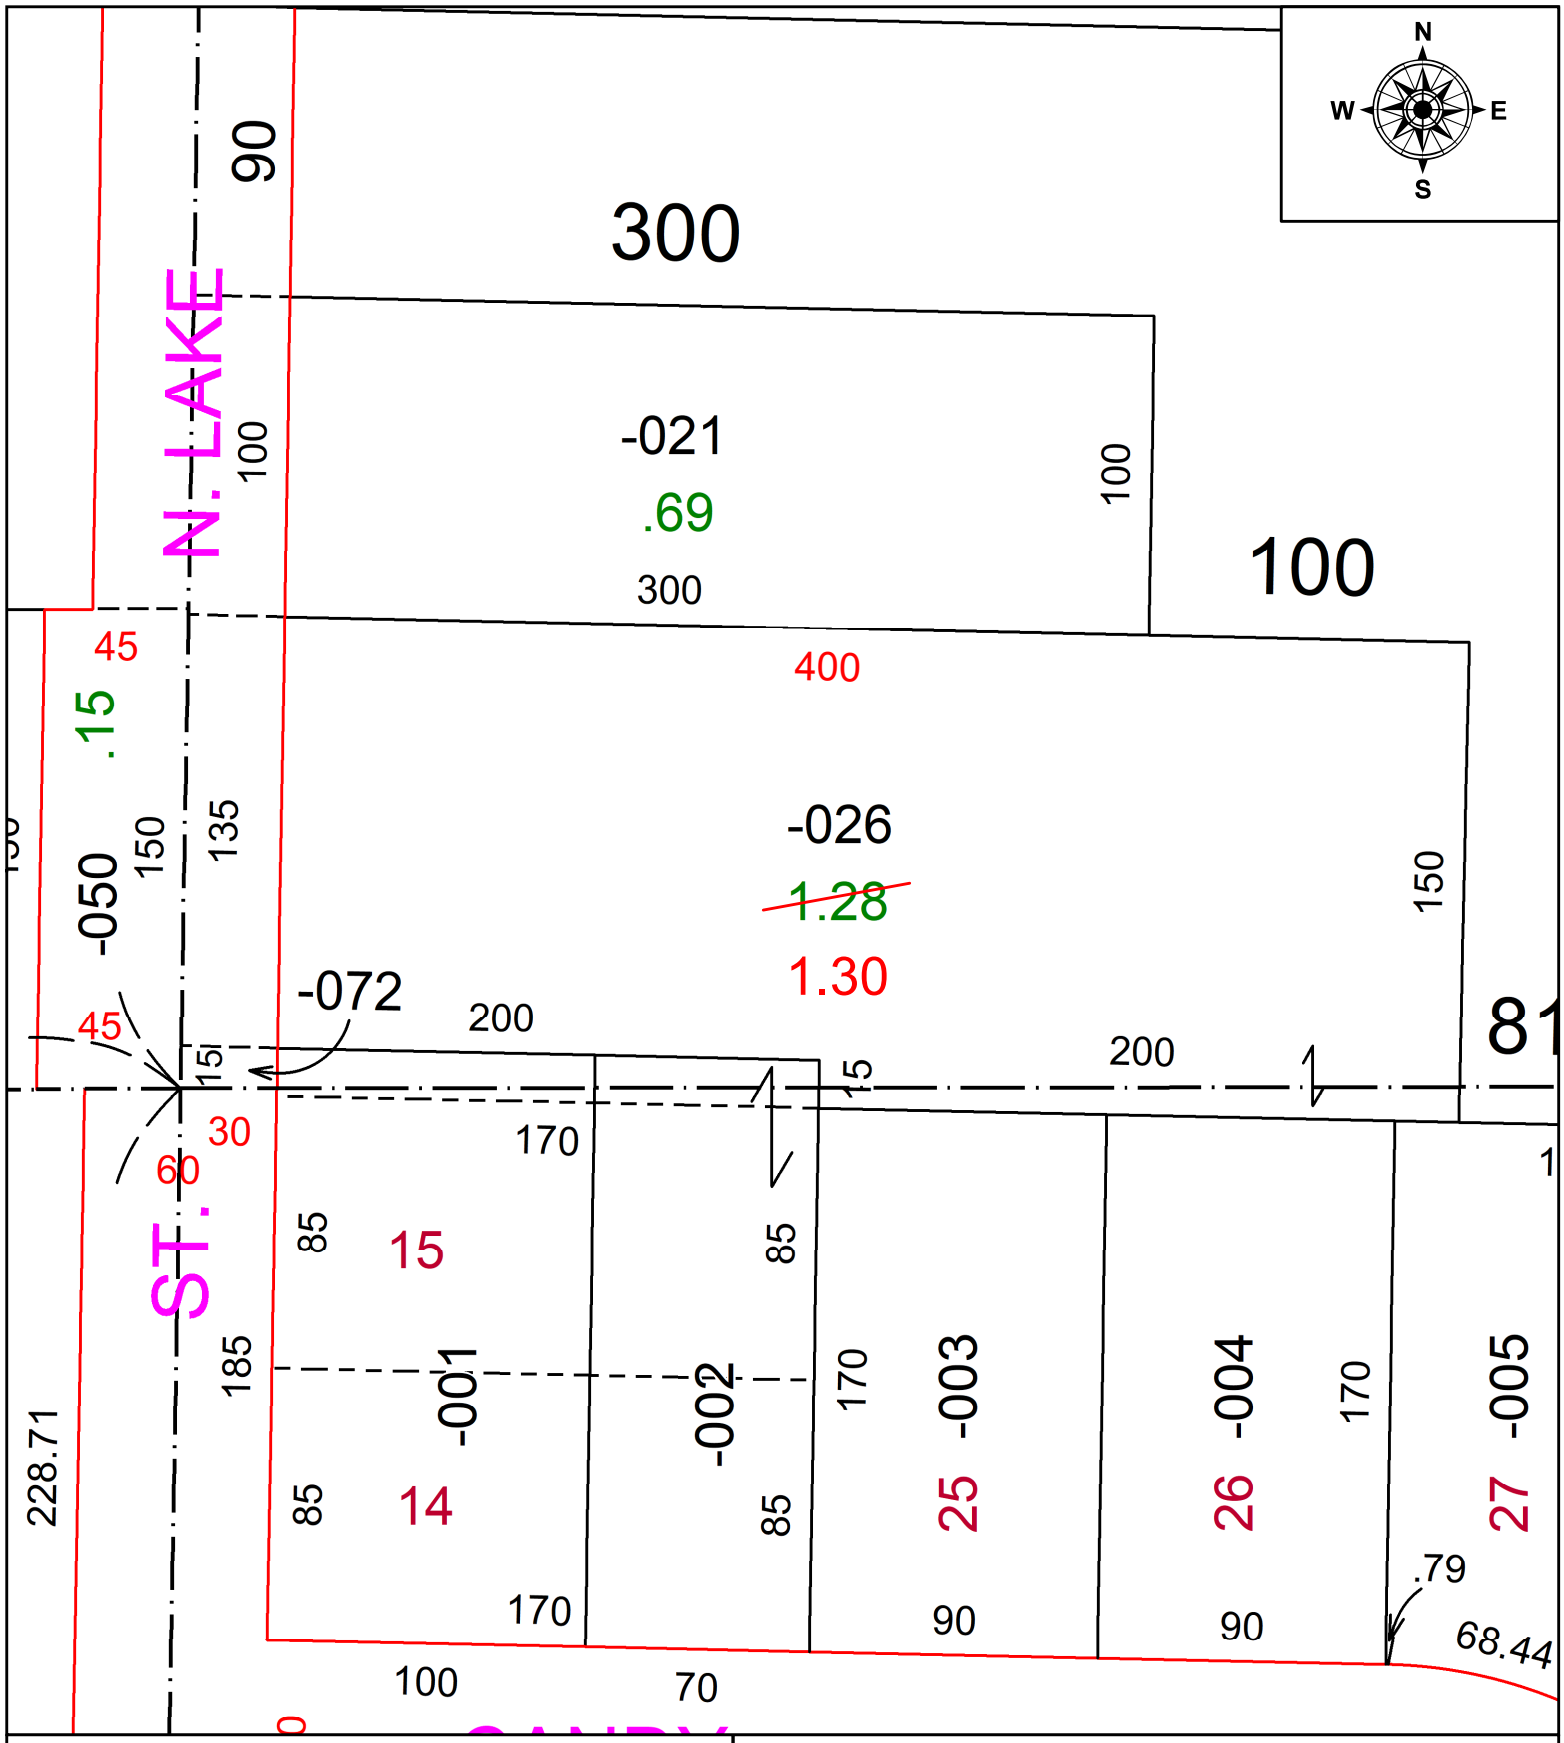

SPLITS/DEEDS PROCESSED
LORAIN COUNTY TAX MAP DEPARTMENT
226 MIDDLE AVE. ELYRIA, OH

SURVEYED BY: N/A **SURVEY #:** N/A
CLOSURE: N/A
MAP PAGE(S): 05-00-019
APPOVED BY: DMA **DATE:** 8/3/2022
SCALE: 1" = 60' **PRIOR INSTRUMENT:** 2021-085325