PARENT PARCEL: 06-21-001-101-058

CHILD PARCEL: AC. CORR. PER PRIOR INSTRUMENT # 2009-0304374

STARTING POINT: N/A

22-04927-A

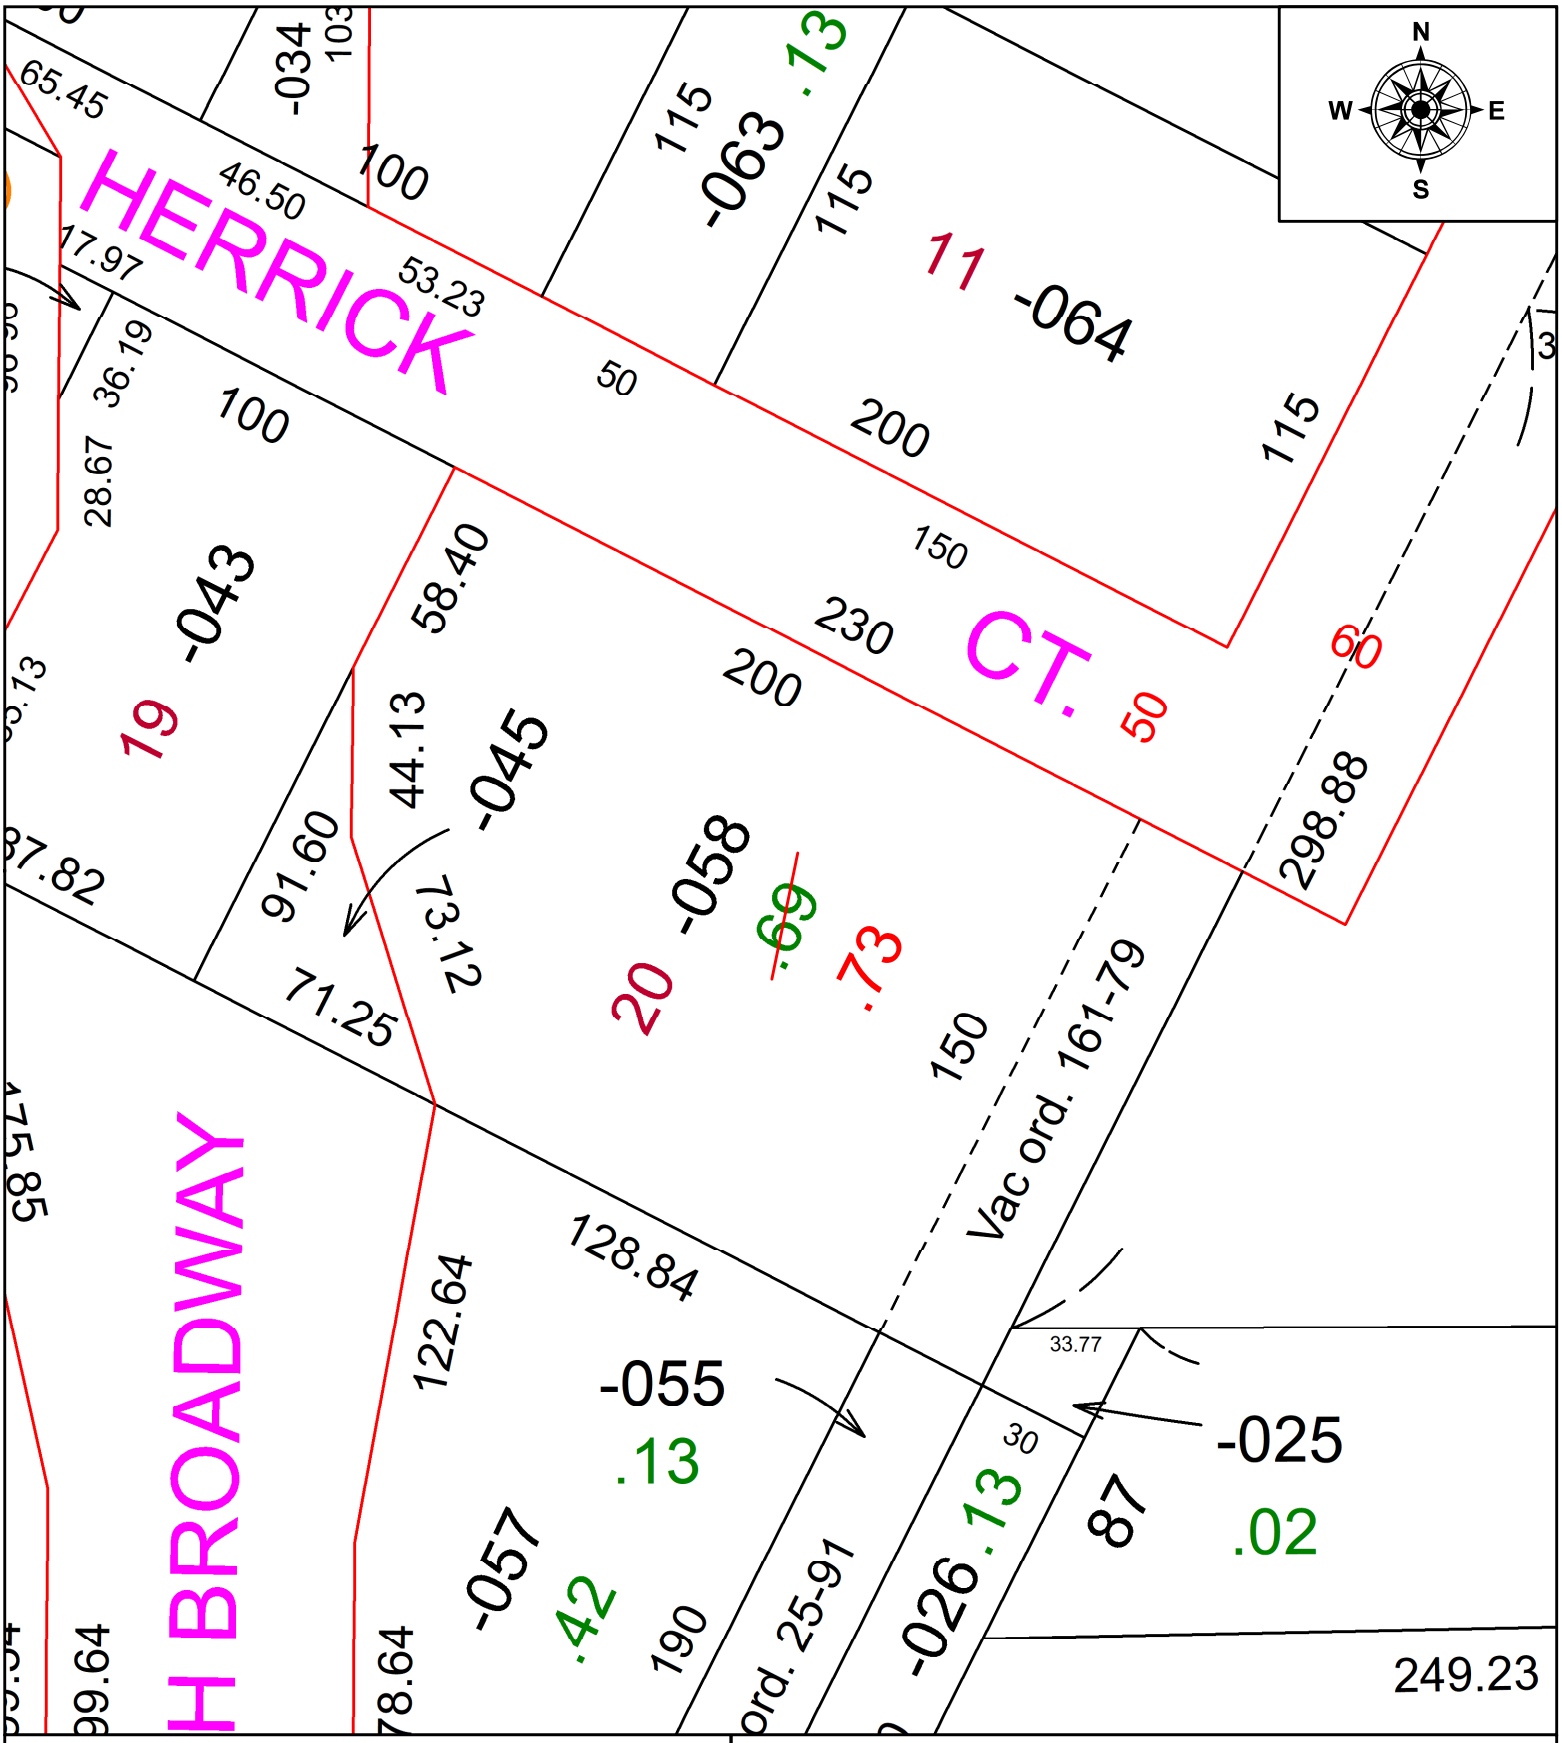

SPLITS/DEEDS PROCESSED

LORAIN COUNTY TAX MAP DEPARTMENT
226 MIDDLE AVE. ELYRIA, OH

SURVEYED BY: N/A **SURVEY #:** N/A

CLOSURE: N/A

MAP PAGE(S): 06-21-001

APPOVED BY: DMA **DATE:** 8/5/2022

SCALE: 1" = 50' **PRIOR INSTRUMENT:** 2009-0304374