PARENT PARCEL: 01-00-038-000-049

CHILD PARCEL: AC CORR PER PRIOR DEED INSTRUMENT NO. 2002- 0851636

STARTING POINT: C/L OF BAUMHART AND N LINE OF O/L 38

22-04928-A

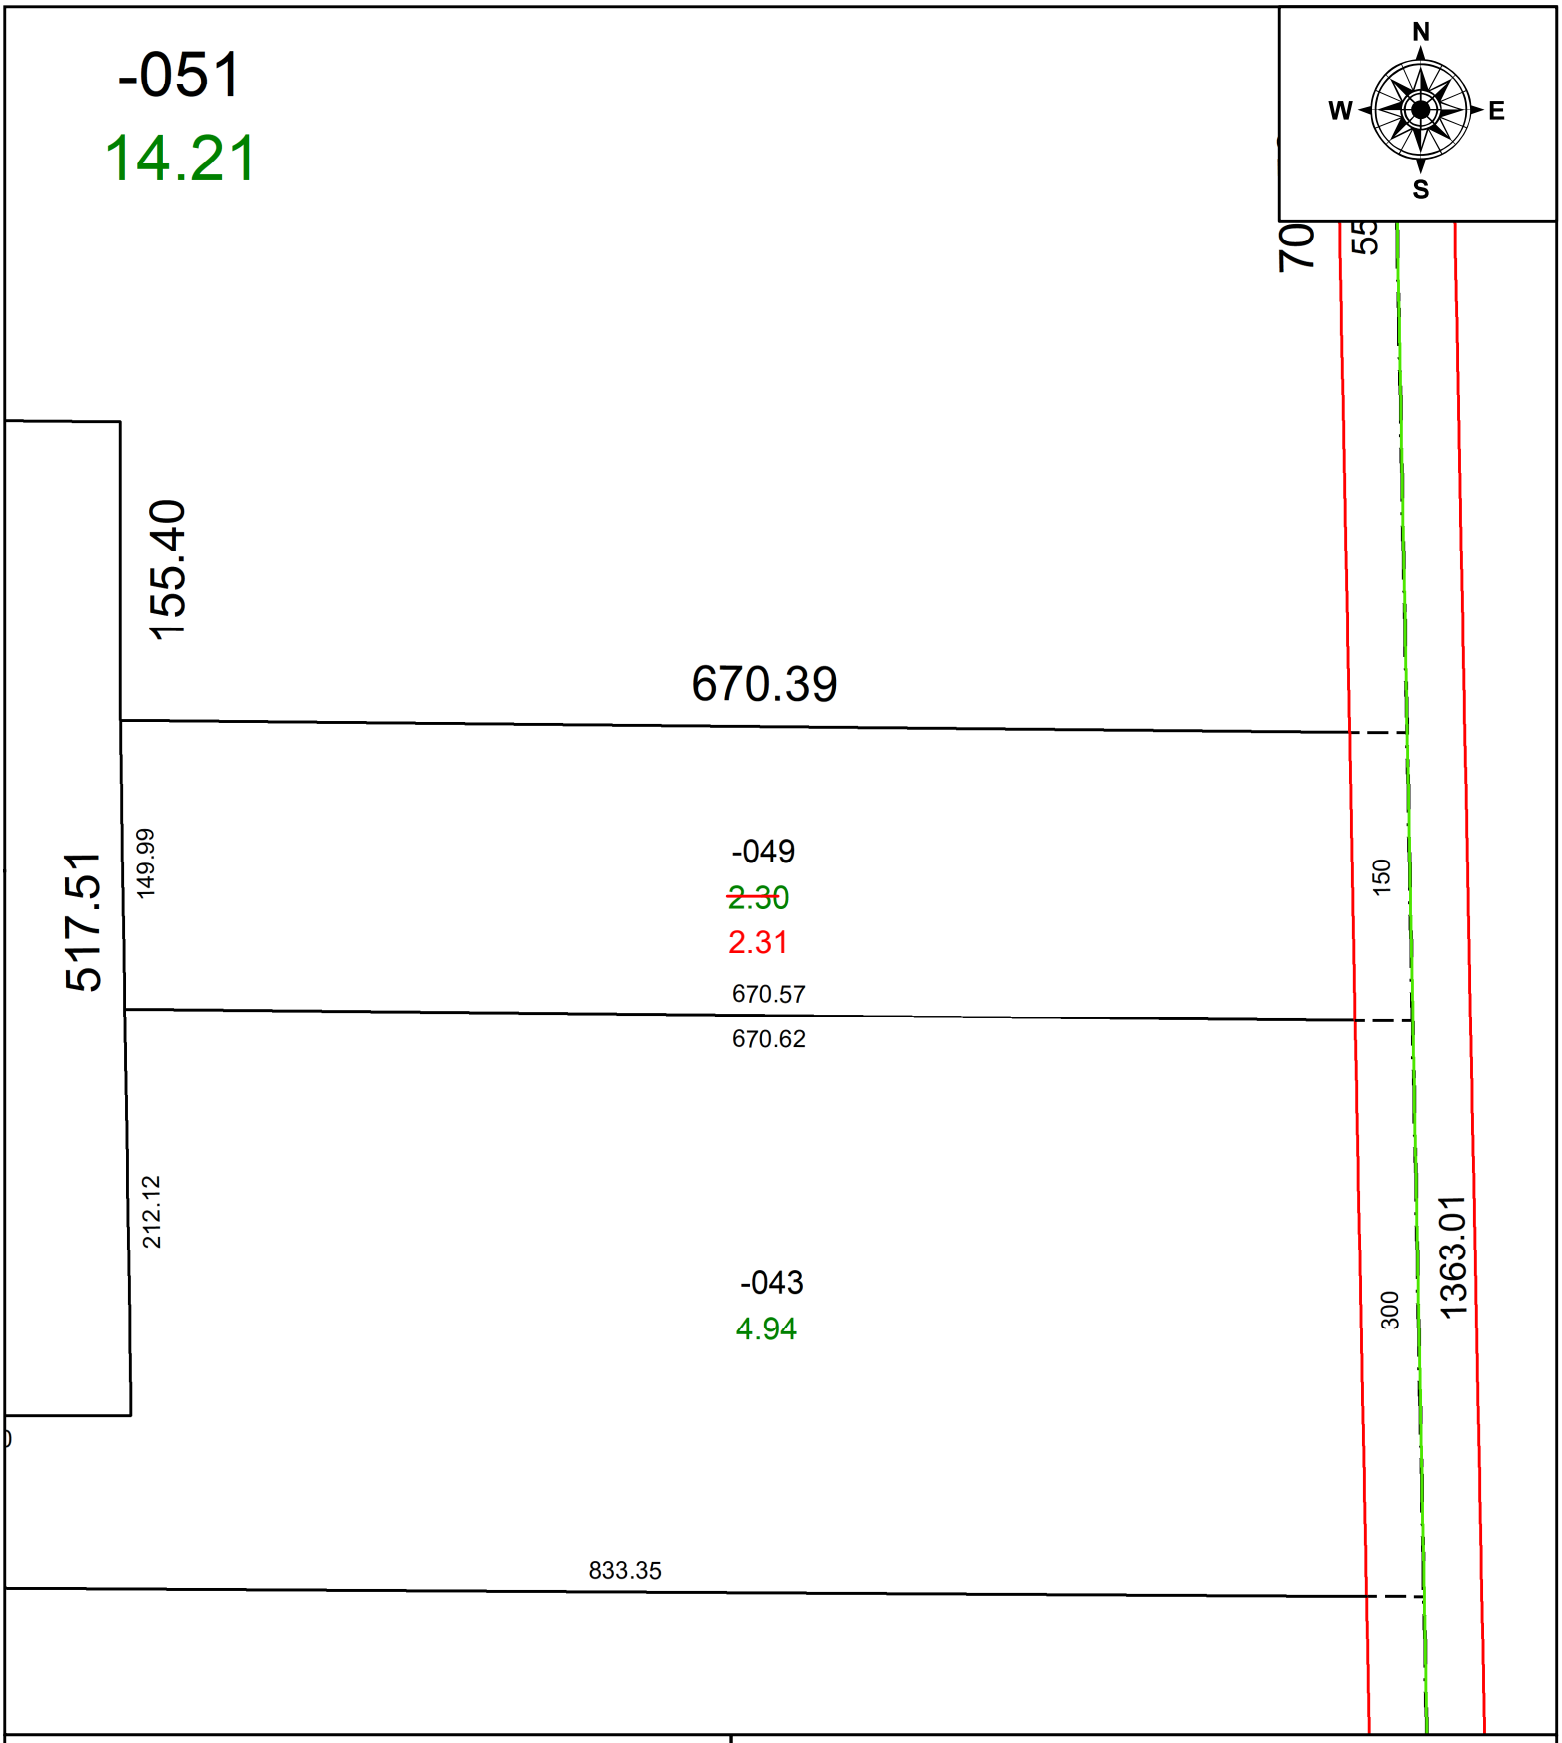

SPLITS/DEEDS PROCESSED

LORAIN COUNTY TAX MAP DEPARTMENT
226 MIDDLE AVE. ELYRIA, OH

SURVEYED BY: N/A
CLOSURE: N/A
MAP PAGE(S): 01-00-038
APPOVED BY: AC **DATE:** August 11, 2022
SCALE: 1" = 100 **PRIOR INSTRUMENT:** 2002- 0851636