PARENT PARCEL: 16-00-026-000-046 & -053

CHILD PARCEL: 16-00-026-000-054

STARTING POINT: C/L OF GRAFTON EASTERN RD AND SR 83

24-04930

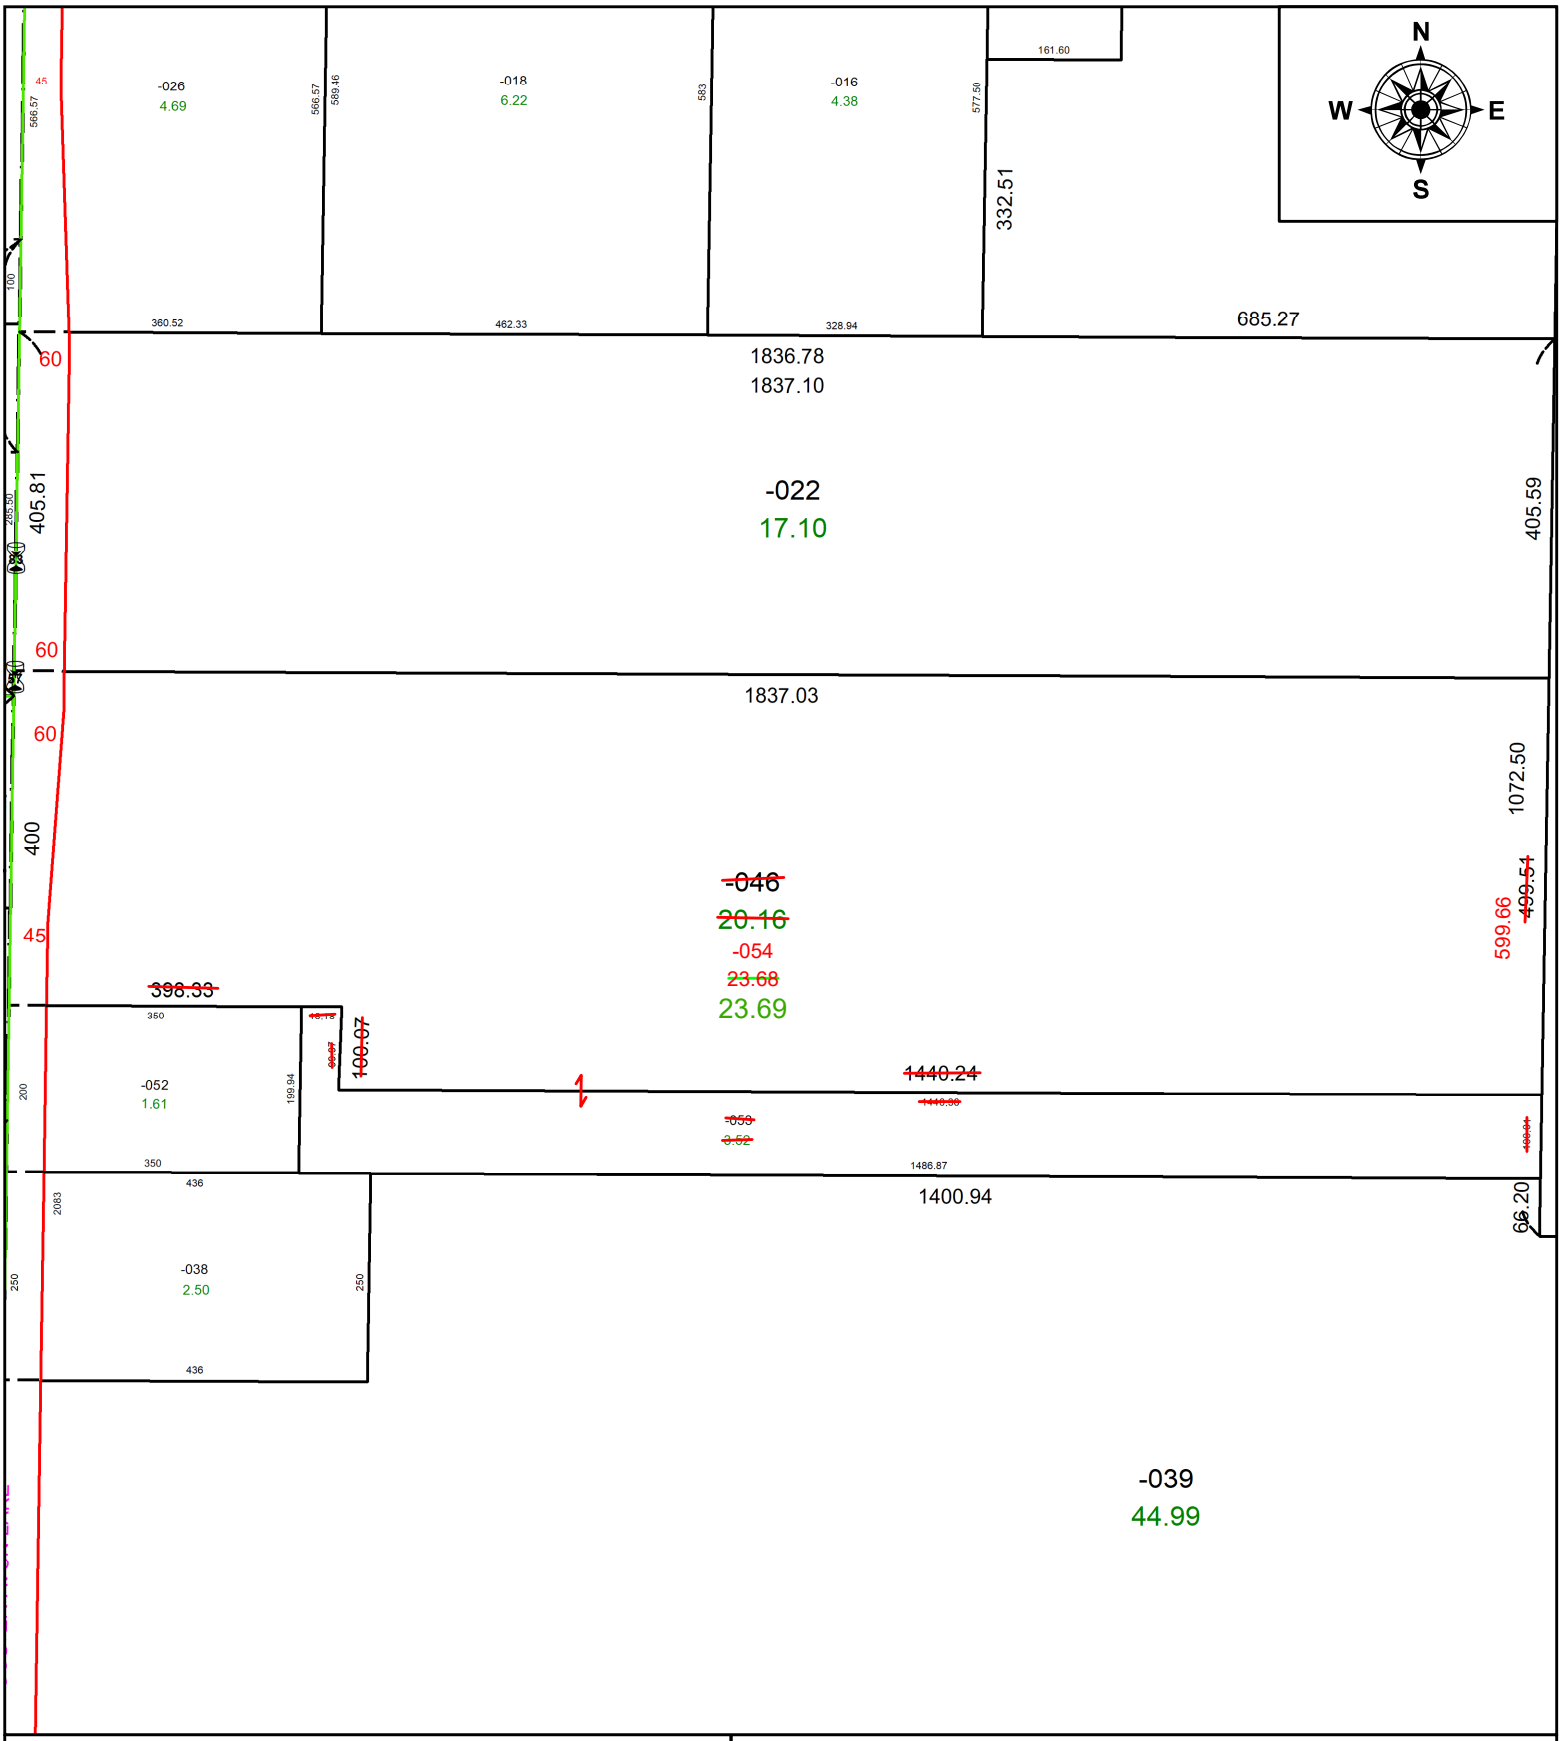

SPLITS/DEEDS PROCESSED

LORAIN COUNTY TAX MAP DEPARTMENT
226 MIDDLE AVE. ELYRIA, OH

SURVEYED BY: THOMAS A. SIMON **SURV # 51314**

CLOSURE: 1: 100789

MAP PAGE(S): 16-00-026

APPOVED BY: AC **DATE:** November 04, 2024

SCALE: 1 in = 230 ft **PRIOR INSTRUMENT:** 2021- 0807935