PARENT PARCEL: 15-00-055-103-002, -007, -008, -012

CHILD PARCEL: 15-00-055-103-013

STARTING POINT: C/L OF E MAIN AND CHURCH ST

24-04933

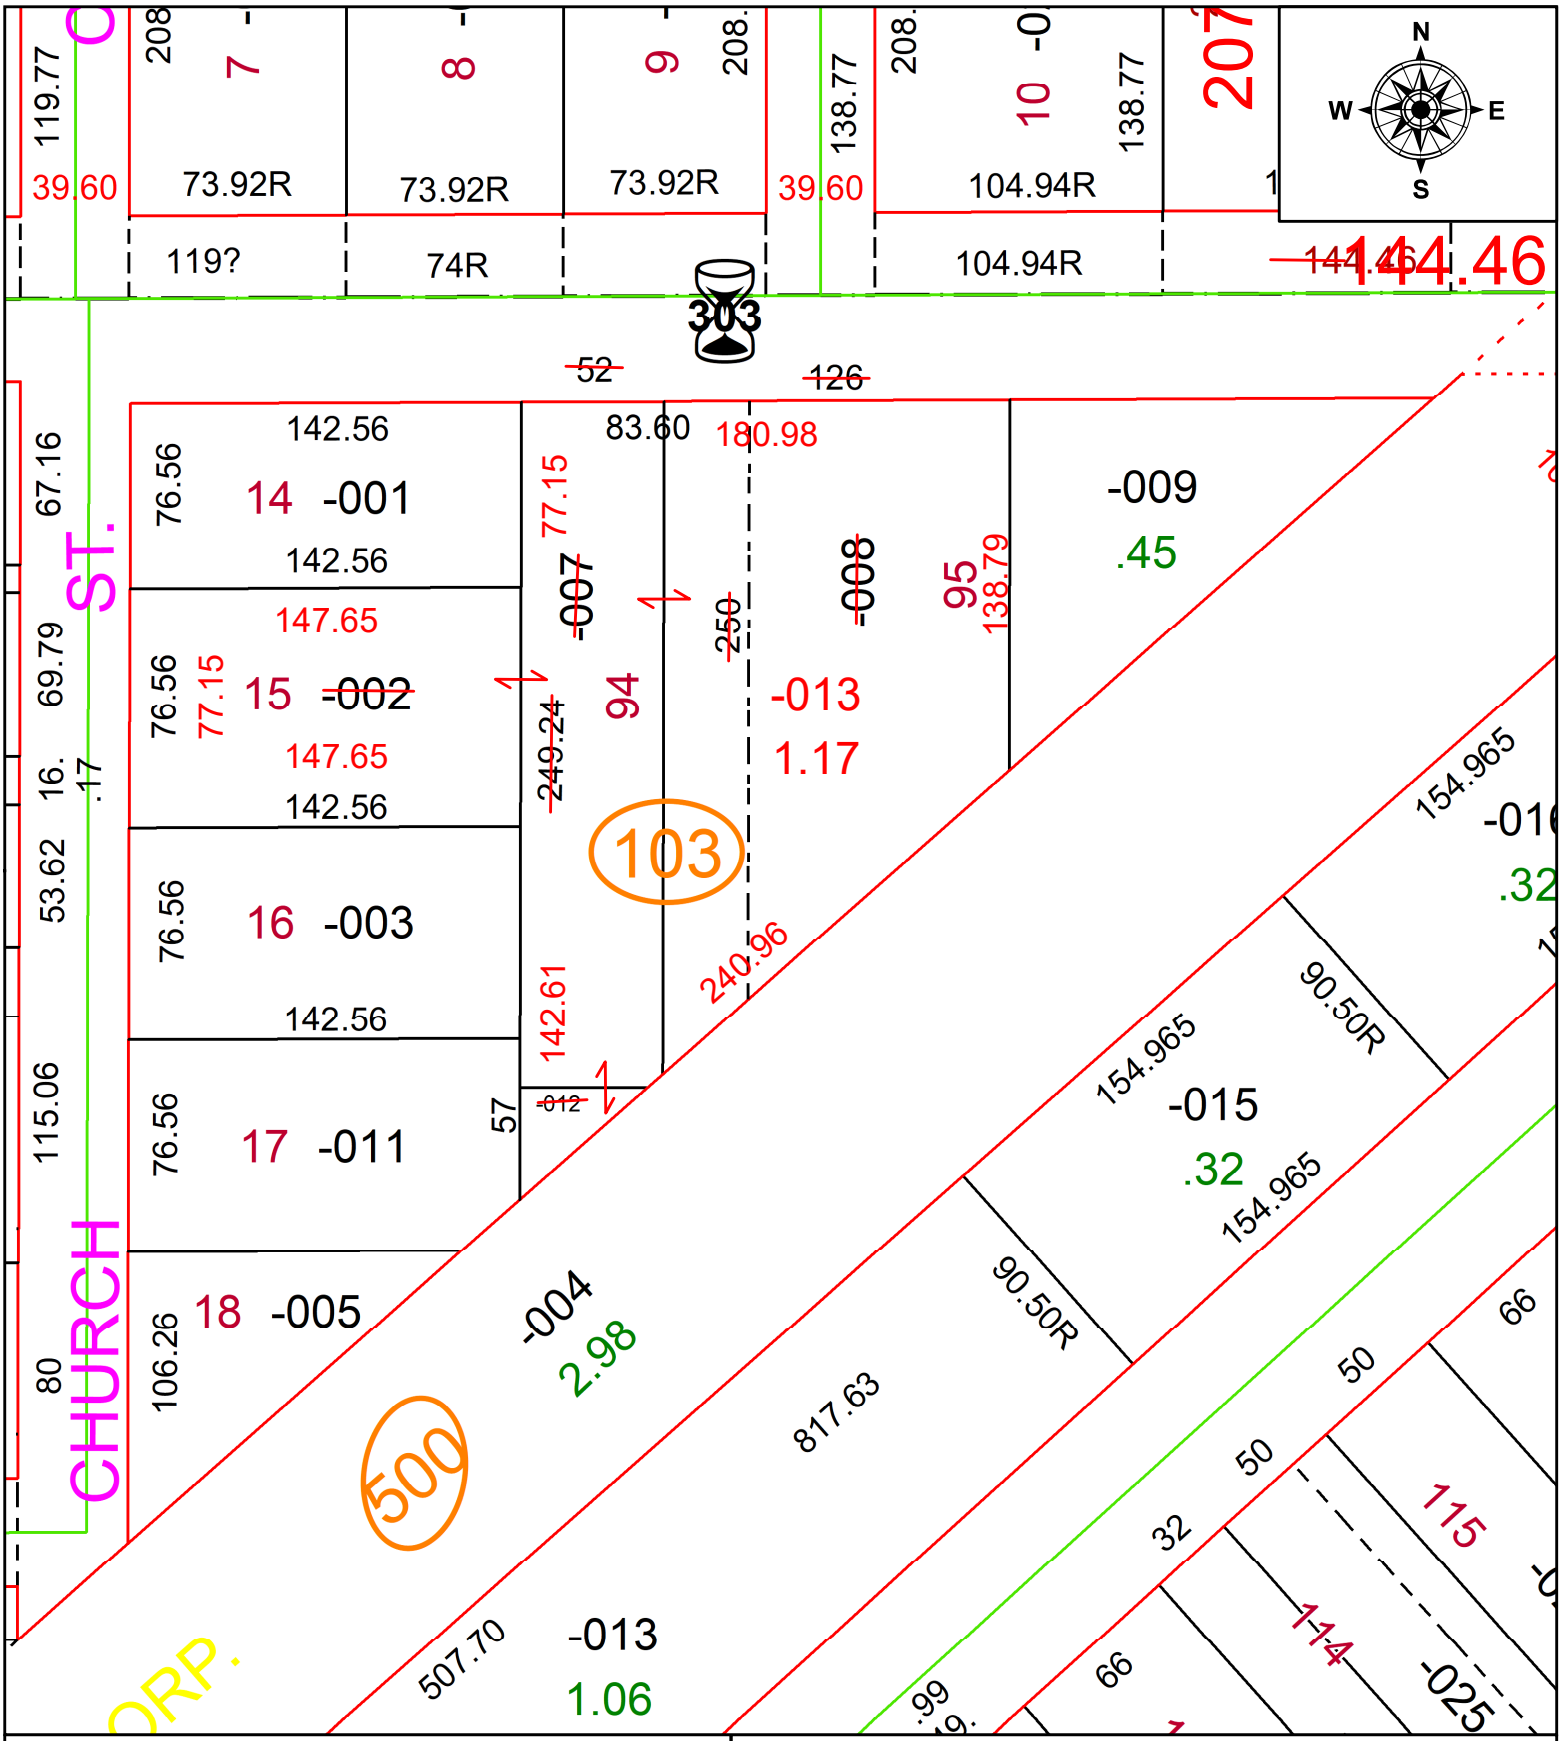

SPLITS/DEEDS PROCESSED

LORAIN COUNTY TAX MAP DEPARTMENT
226 MIDDLE AVE. ELYRIA, OH

SURVEYED BY: AMY M. KELLY **SURV # 51313**

CLOSURE: 1: 179512

MAP PAGE(S): 15-00-055

APPOVED BY: AC **DATE:** November 04, 2024

SCALE: 1 in = 70 ft **PRIOR INSTRUMENT:** 2023- 0939967